


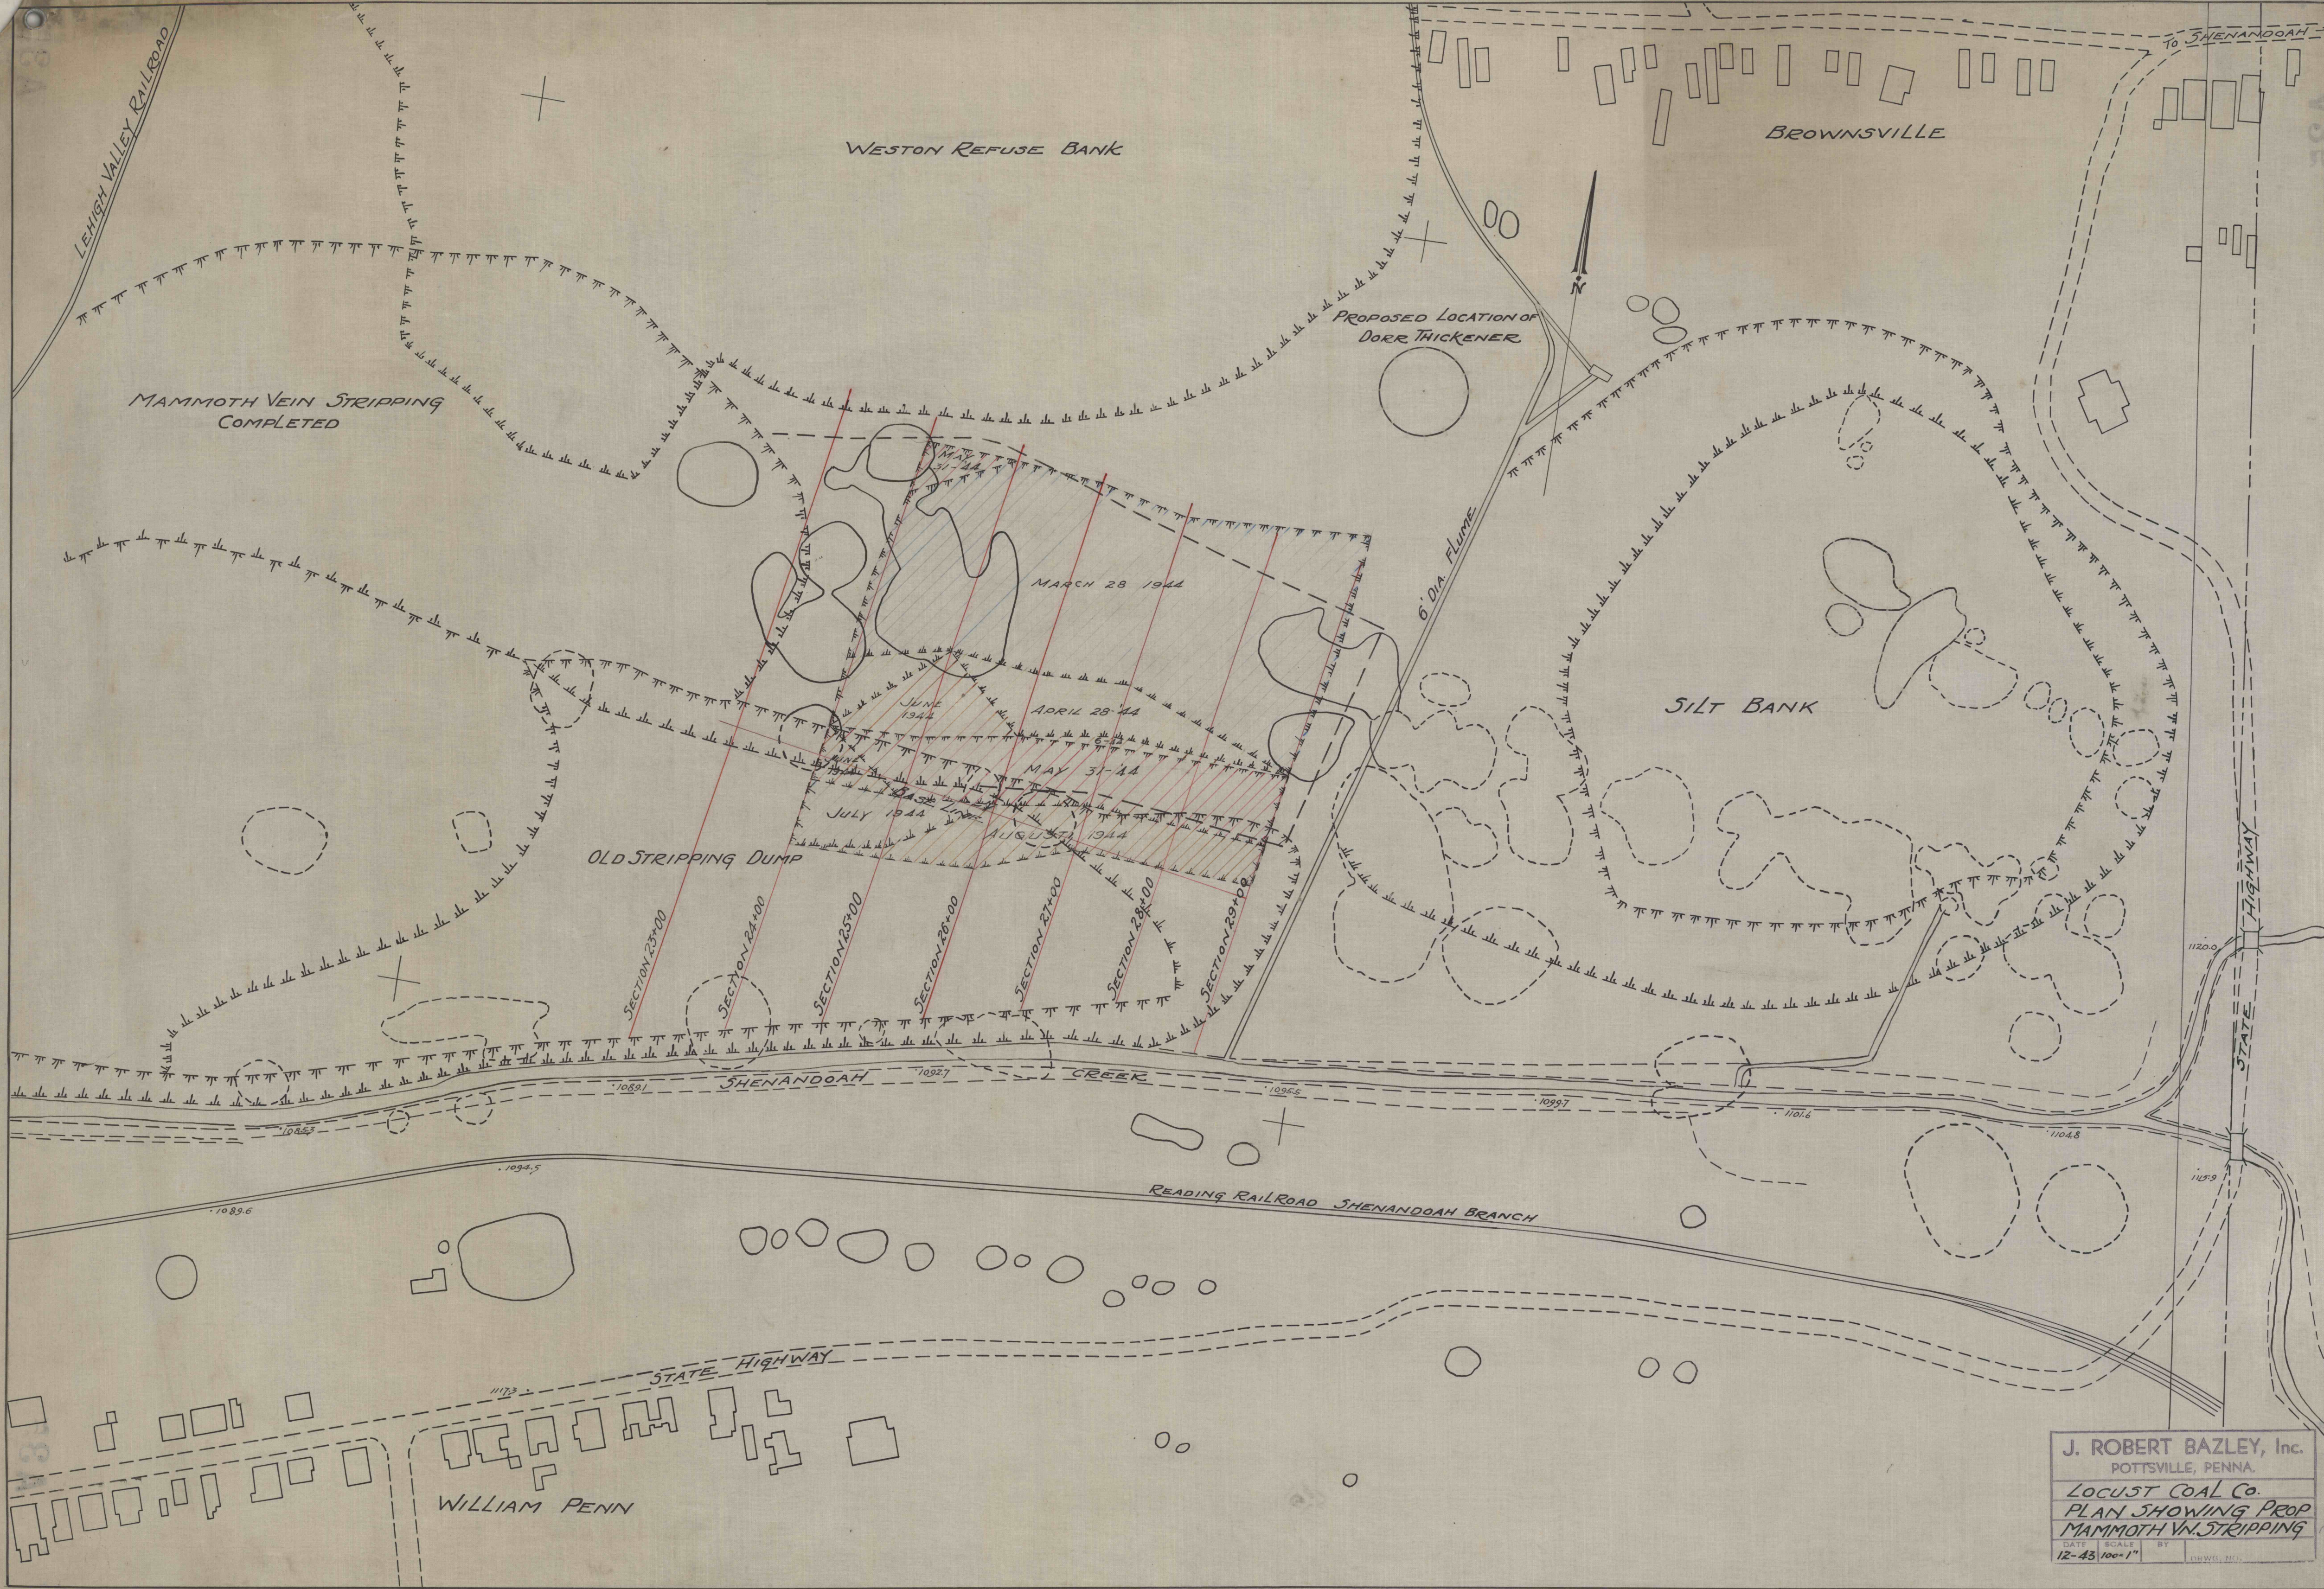

J. ROBERT BAZLEY, Inc.
POTTSVILLE, PENNA.
LOCUST COAL CO.
PLAN SHOWING PROP
MAMMOTH VN. STRIPPING
DATE 12-43 SCALE 1"=100' BY JRB