


N

SHOT 1-24-49
8 HOLES

SHOT 1-21-49
13 HOLES

SHOT 1-27-49
9 HOLES

SHOT 1-19-49
16 HOLES

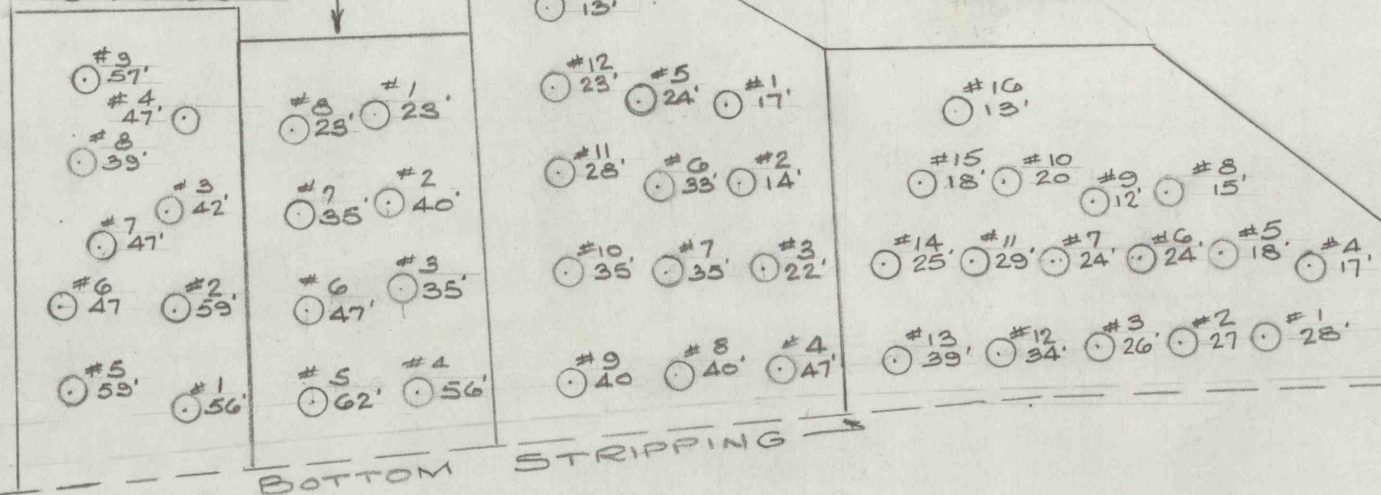

J. ROBERT BAZLEY, Inc.
POTTSVILLE, PENNA.

DRILL HOLES

PACKER No. 4

9-A STRIPPING

DATE	SCALE	BY
1-27-49	1"=40'	SWP.