


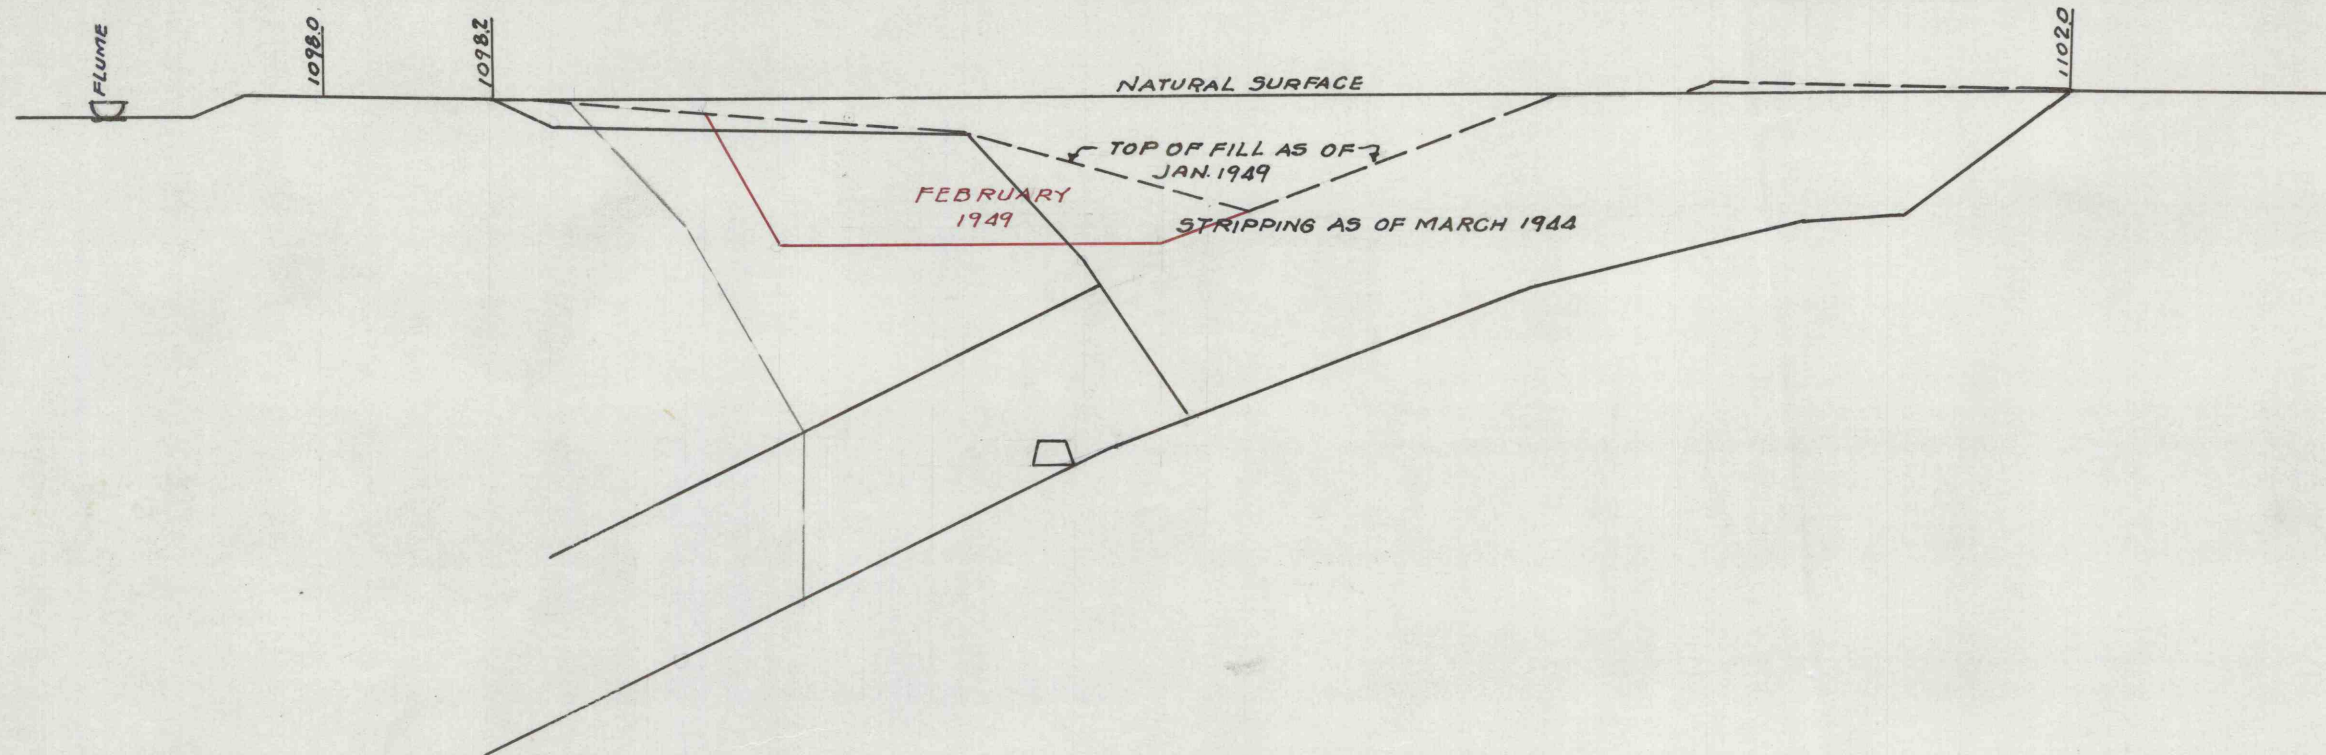

PACKER N° 9 STRIPPING
SECTION 2900 FEET EAST OF GUNBOAT SLOPE
SCALE 1"=50' MAR 1, 1949