


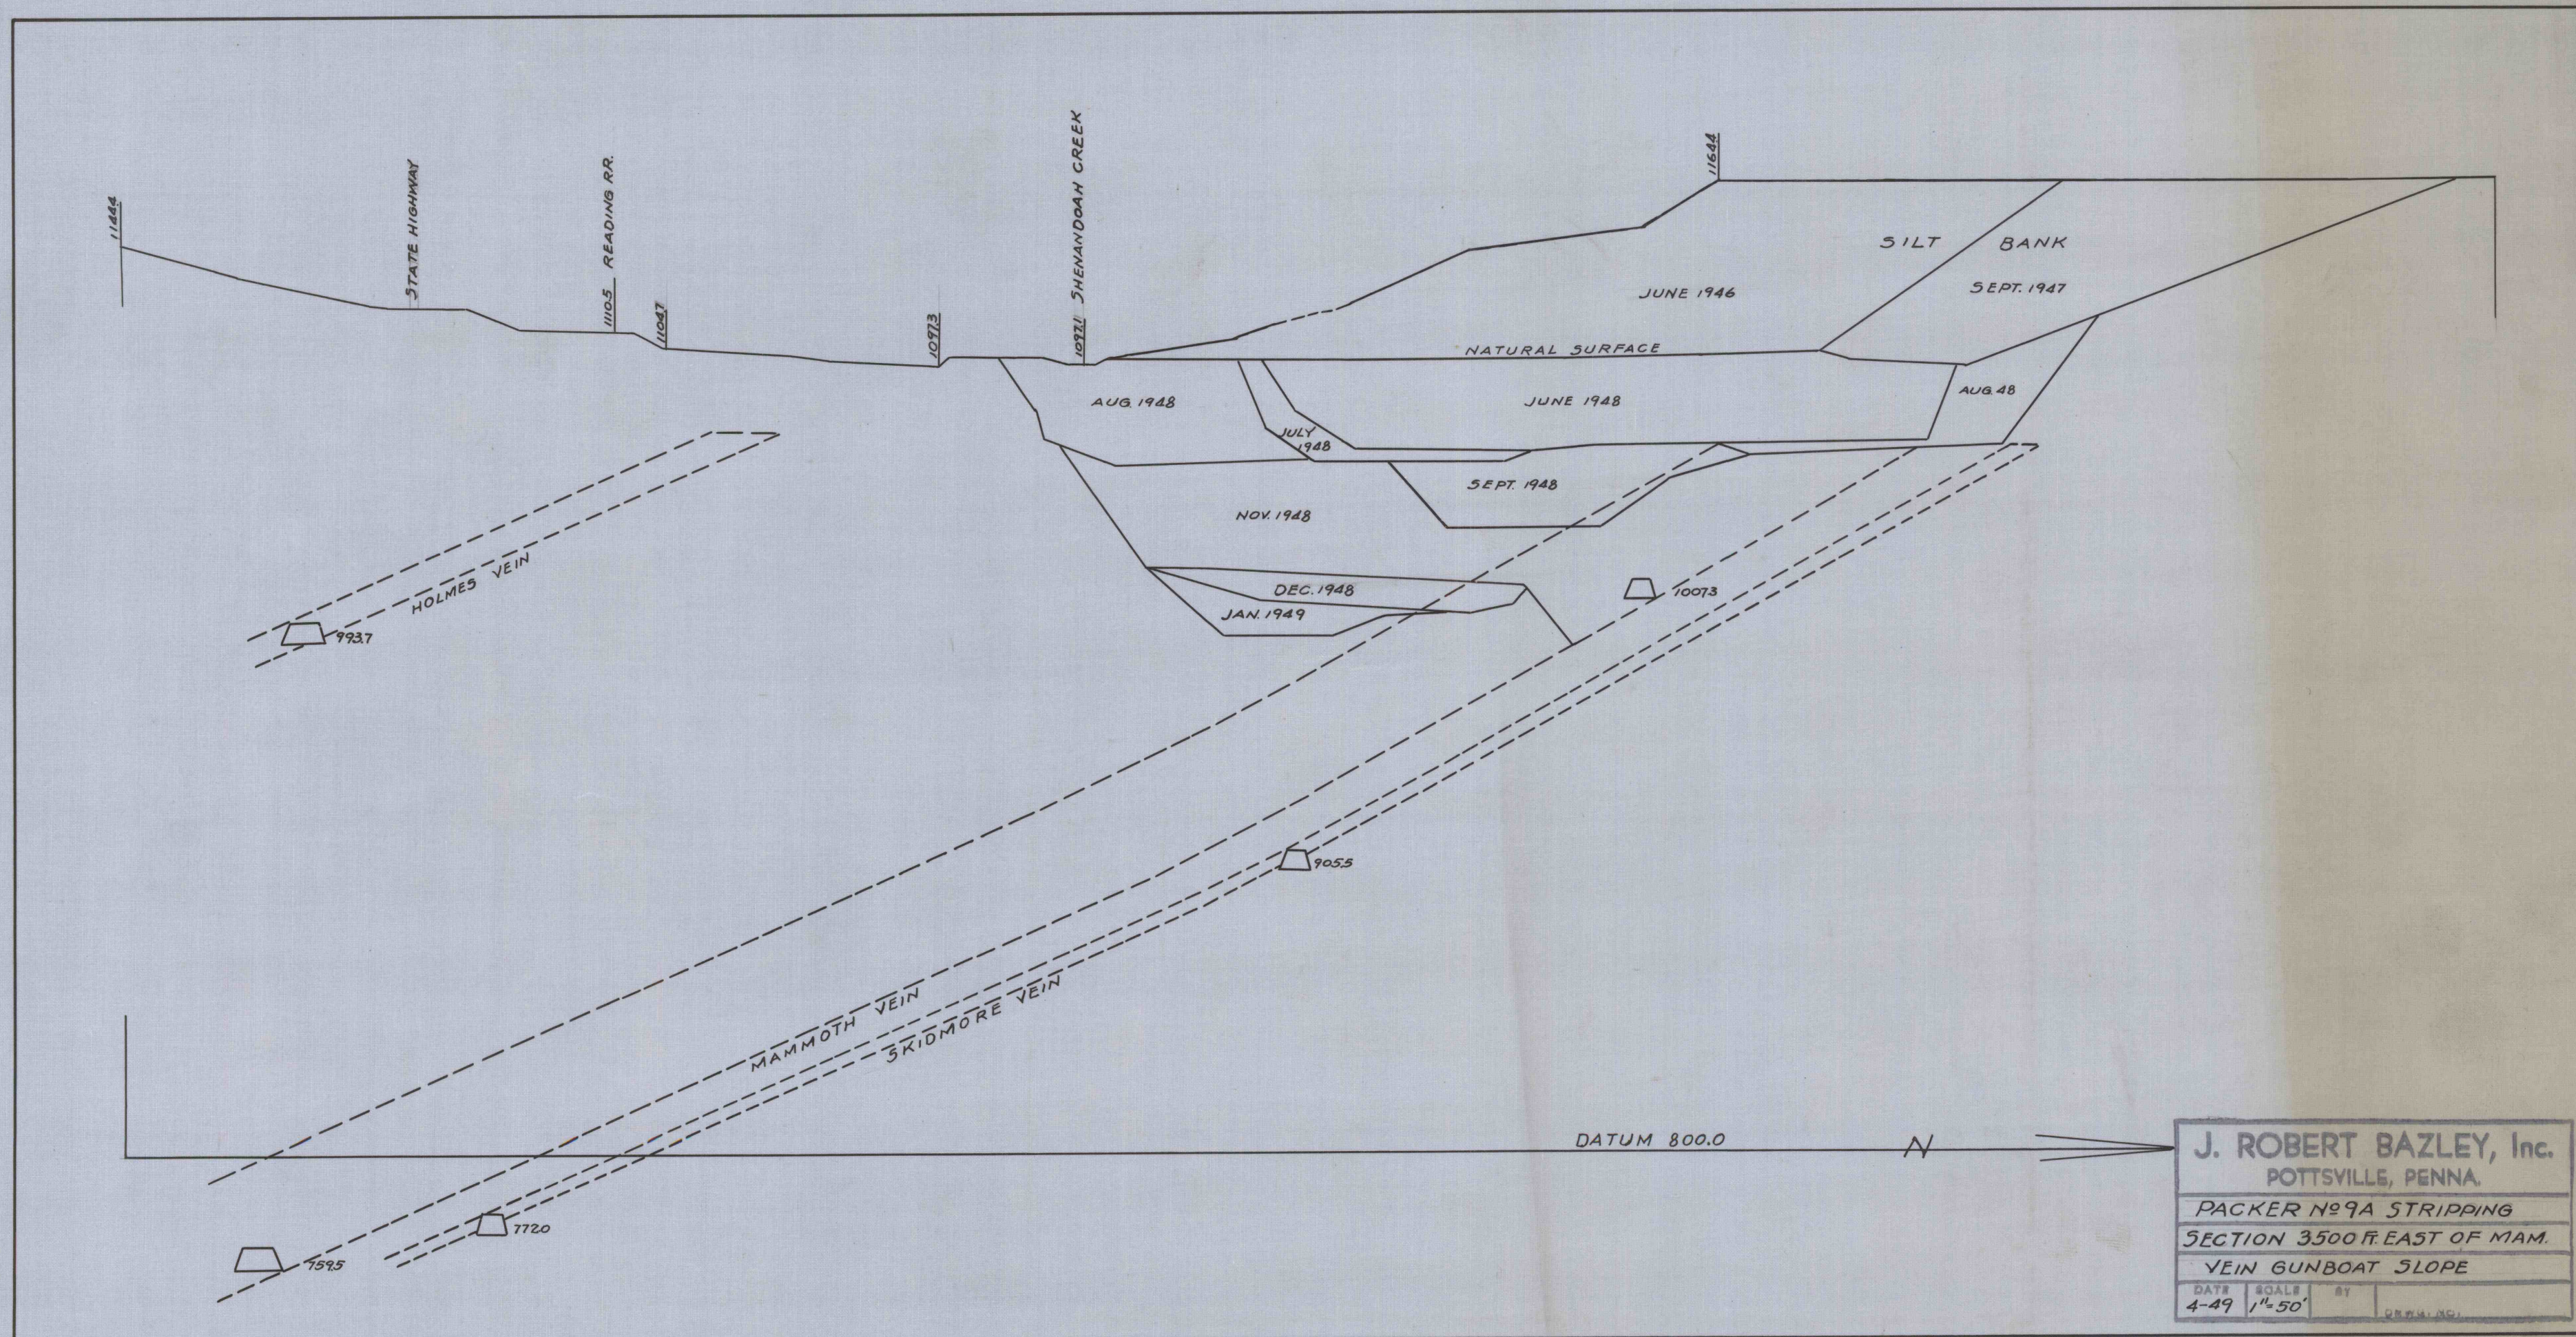

J. ROBERT BAZLEY, Inc.
POTTSVILLE, PENNA.
PACKER No 9A STRIPPING
SECTION 3500 FT. EAST OF MAM.
VEIN GUNBOAT SLOPE
DATE 4-49 SCALE 1"=50' BY QRS:NC