


4322

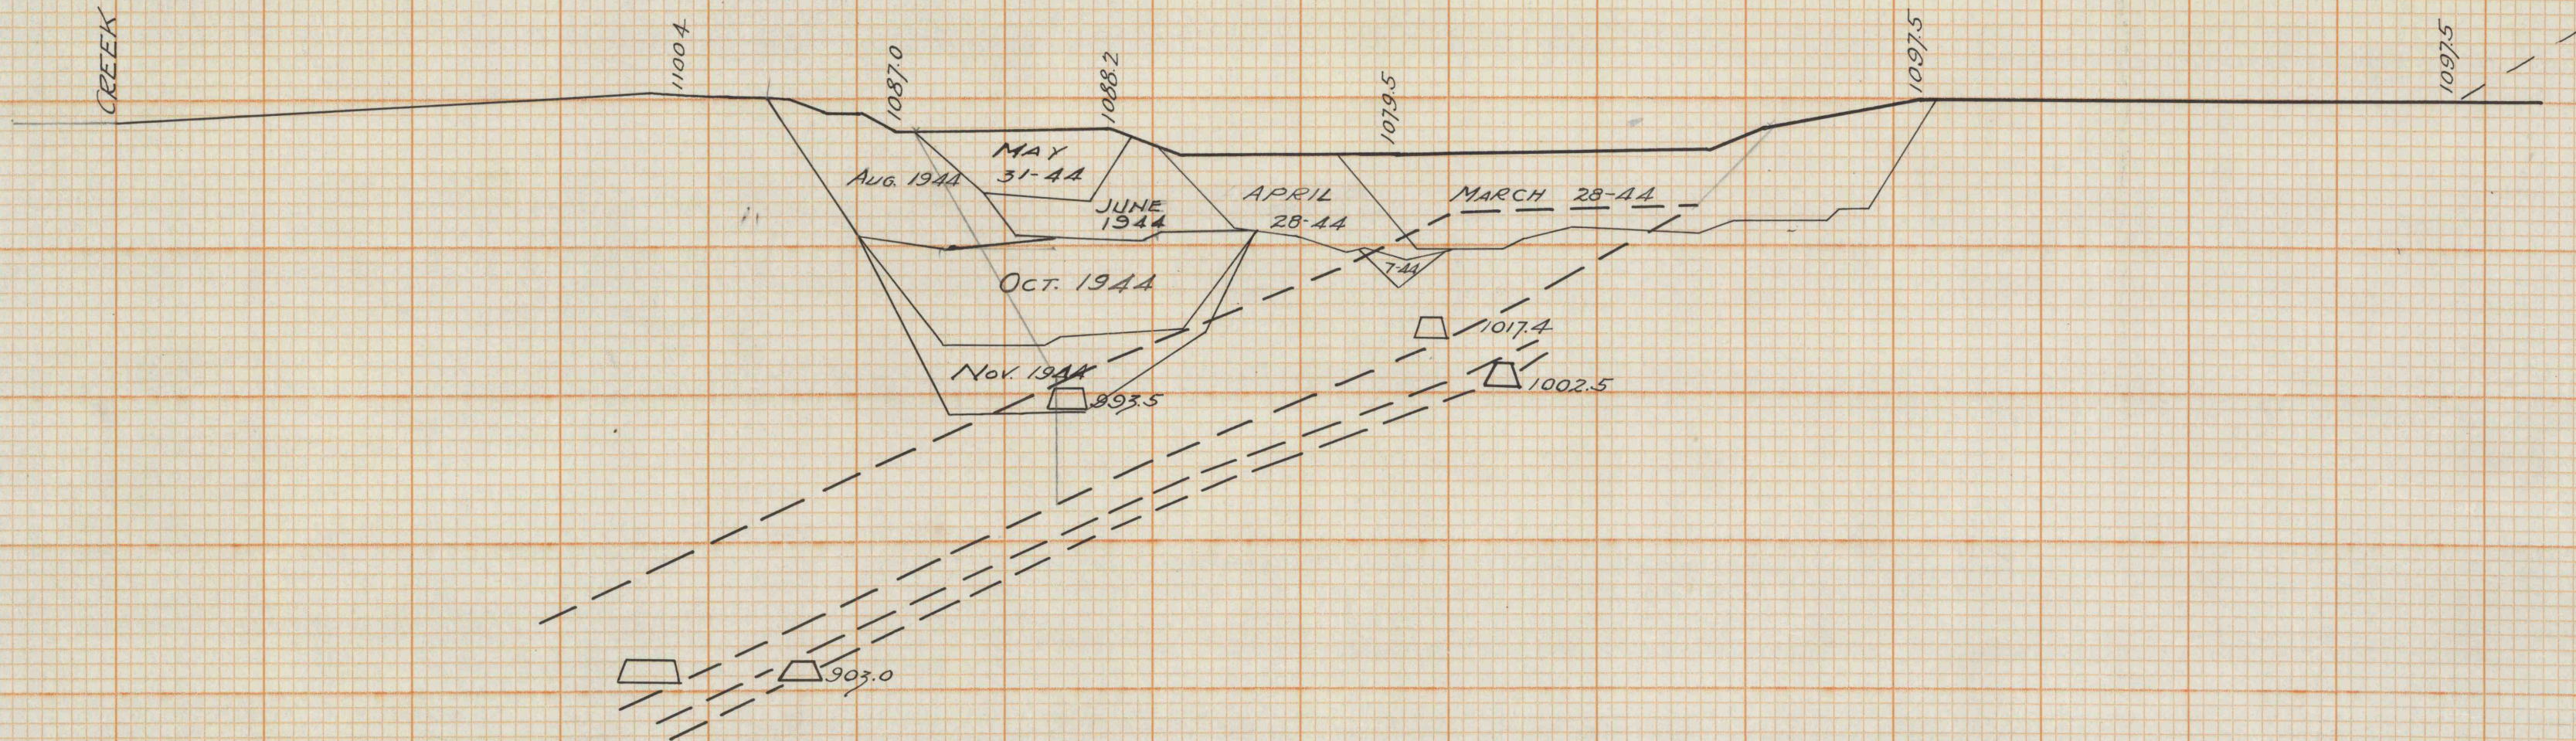

J. ROBERT BAZLEY, Inc.			
POTTSVILLE, PENNA.			
PACKER N° 4 H9			
SECTION 27+00 EAST OF			
GUNBOAT SLOPE			
DATE	SCALE	BY	DRWG. NO.
12-43	1"=50'	L.C. Co	