


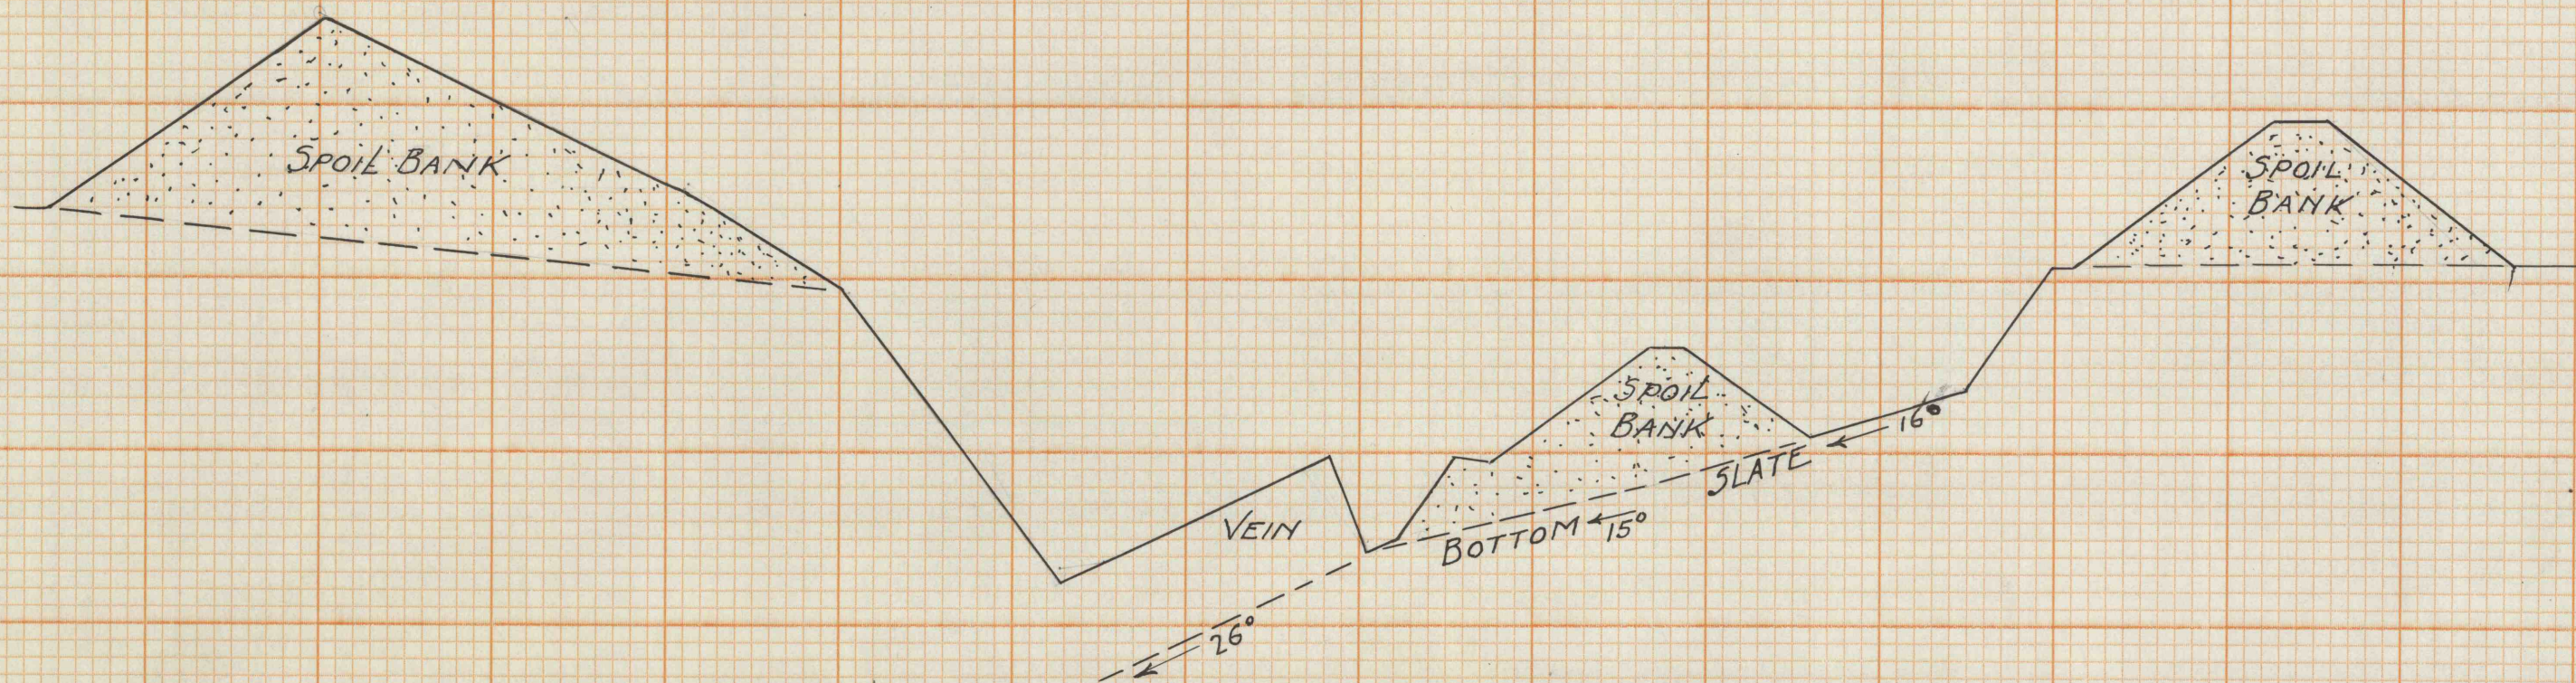

SECTION LINE 27+50

DATUM 900

J. ROBERT BAZLEY, Inc.			
POTTSVILLE, PENNA.			
PACKER No 9			
SECTION LINE			
27+50			
DATE	SCALE	BY	
7/44	1"=50'		J.R.B.