


V32

CREEK

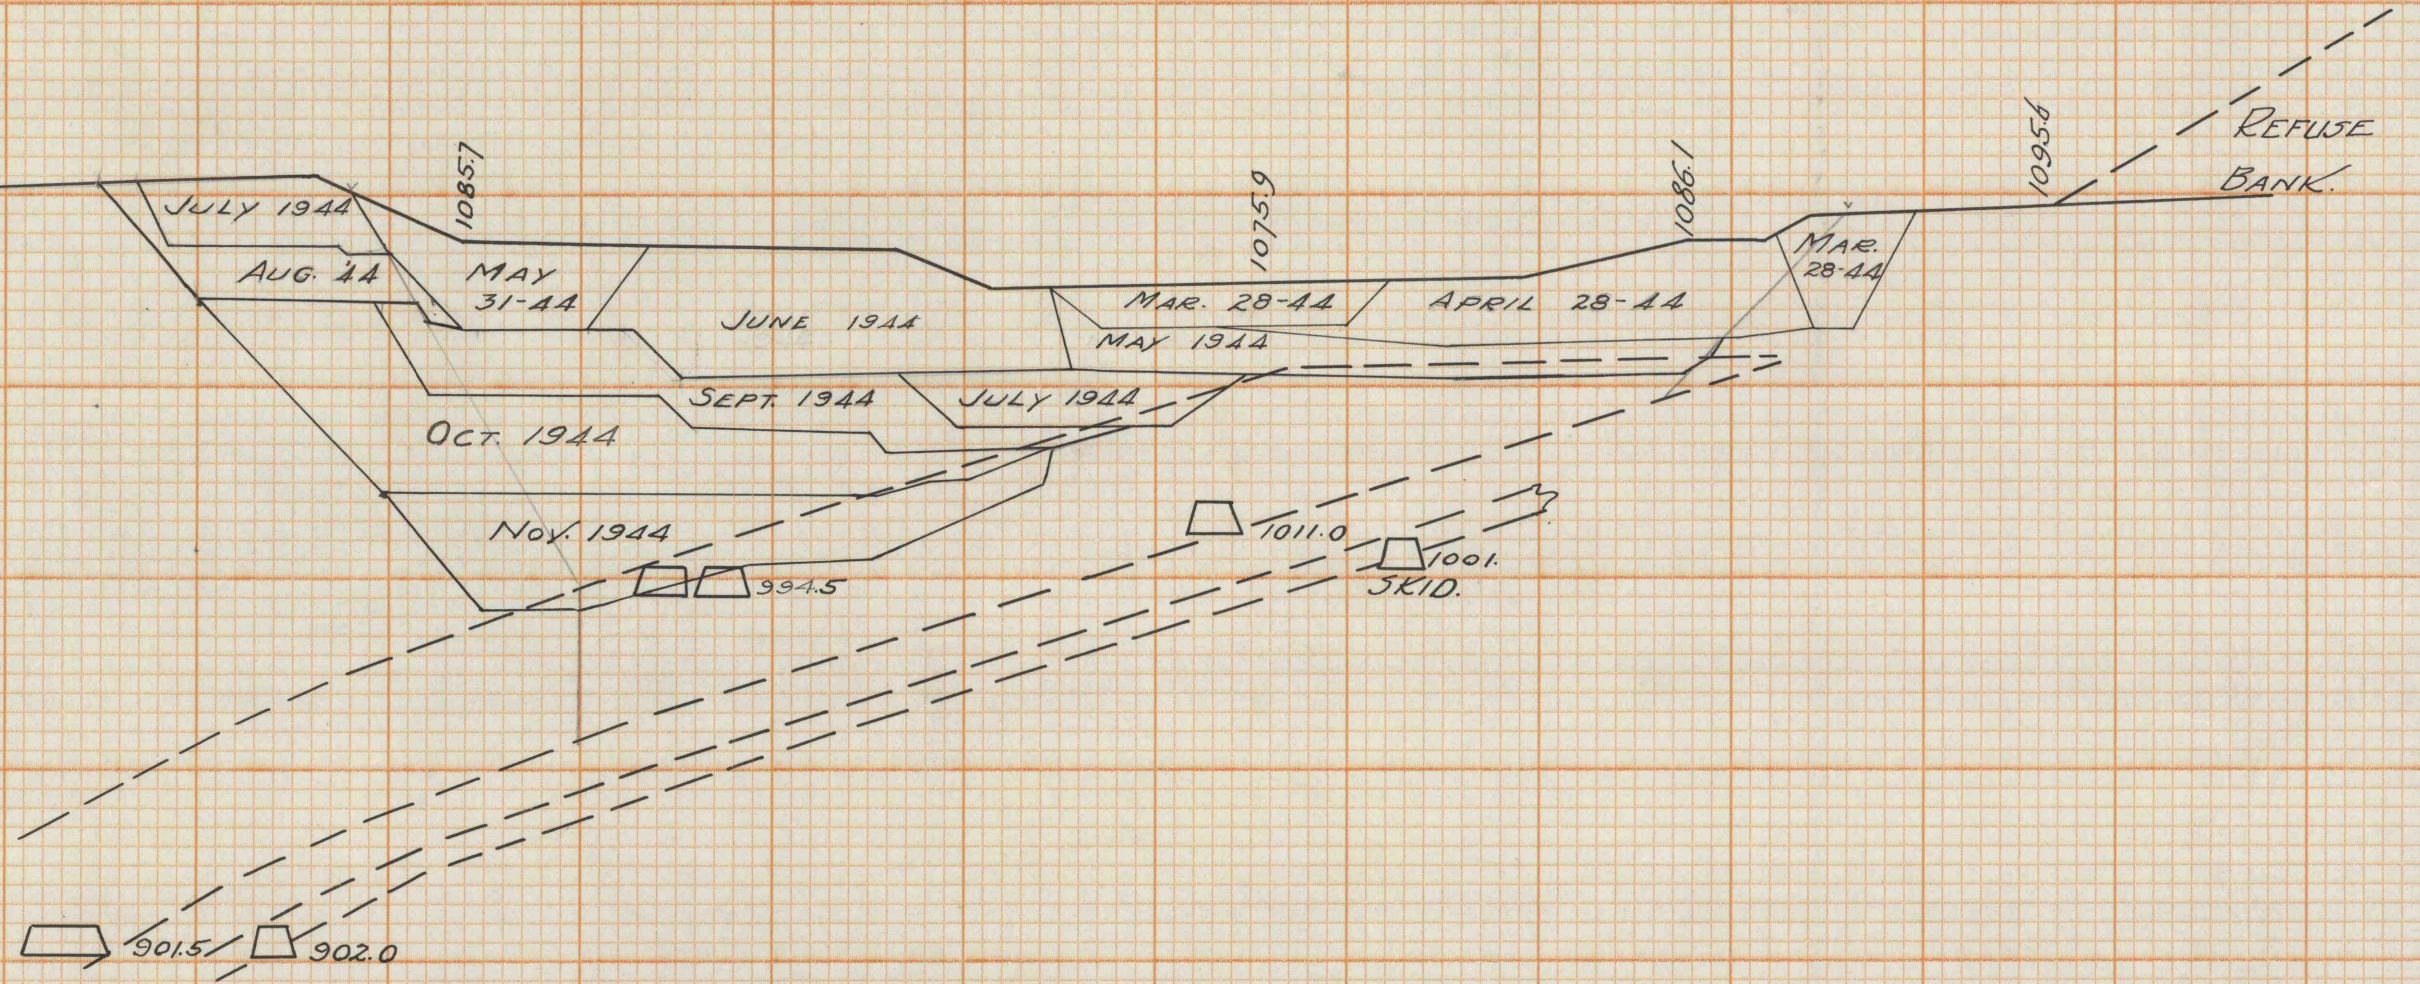

J. ROBERT BAZLEY, Inc.			
POTTSVILLE, PENNA.			
PACKER N°4 49			
SECTION 25+00 EAST			
OF GUNBOAT SLOPE			
DATE	SCALE	BY	DRWG. NO.
12-43	1"=50'	L.C.G.	