


132

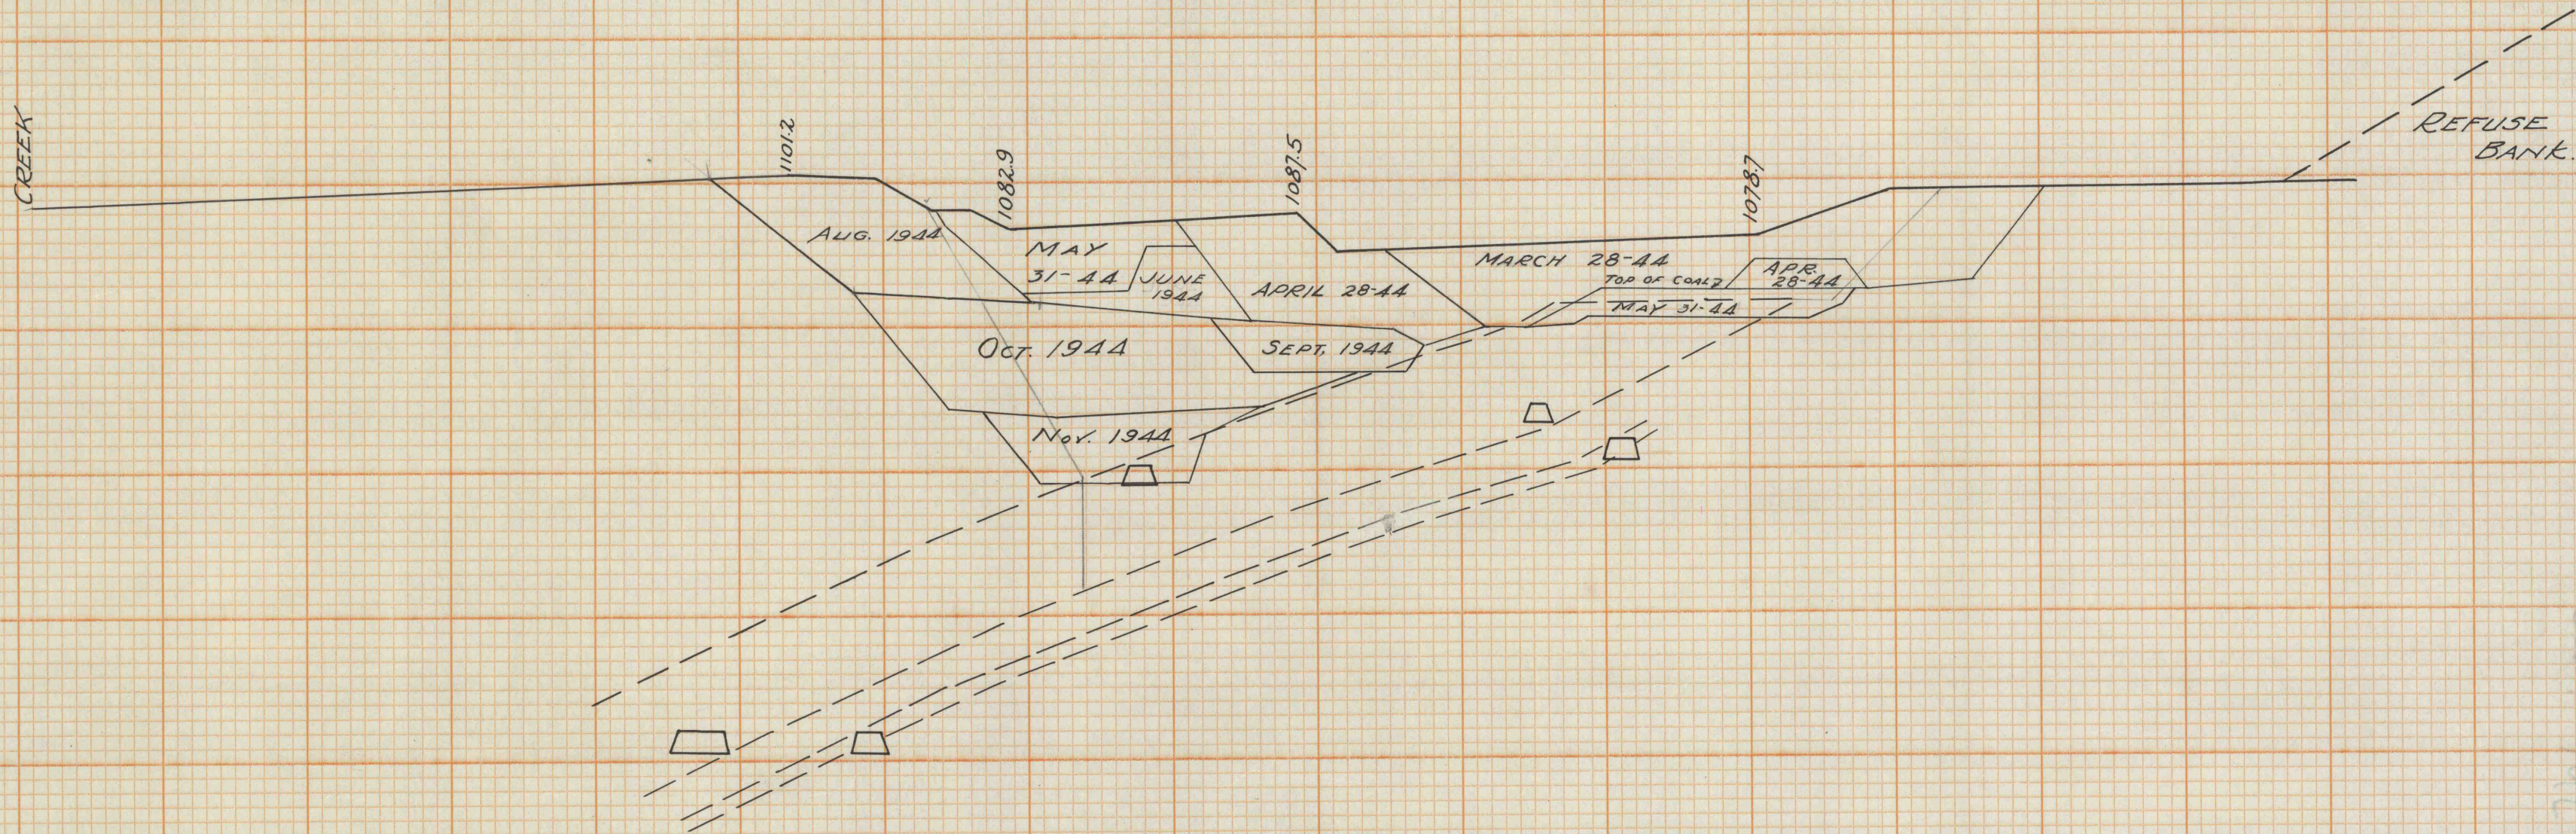

J. ROBERT BAZLEY, Inc.			
POTTSVILLE, PENNA.			
PACKER N° 4 #			
SECTION 26+00 EAST OF			
GUNBOAT SLOPE			
DATE	SCALE	BY	DRWG. N°
12-43	1"=50'	L.C.C.	

132