


82-6
60.1
116

LEGEND	
②	WATCHMAN STATION
⊕	FIRE STATION
⊕	FIRE EXTINGUISHER
①	FIRE HYDRANT
⑤	BUILDING NUMBER

W 38
268
12
1280
T=5

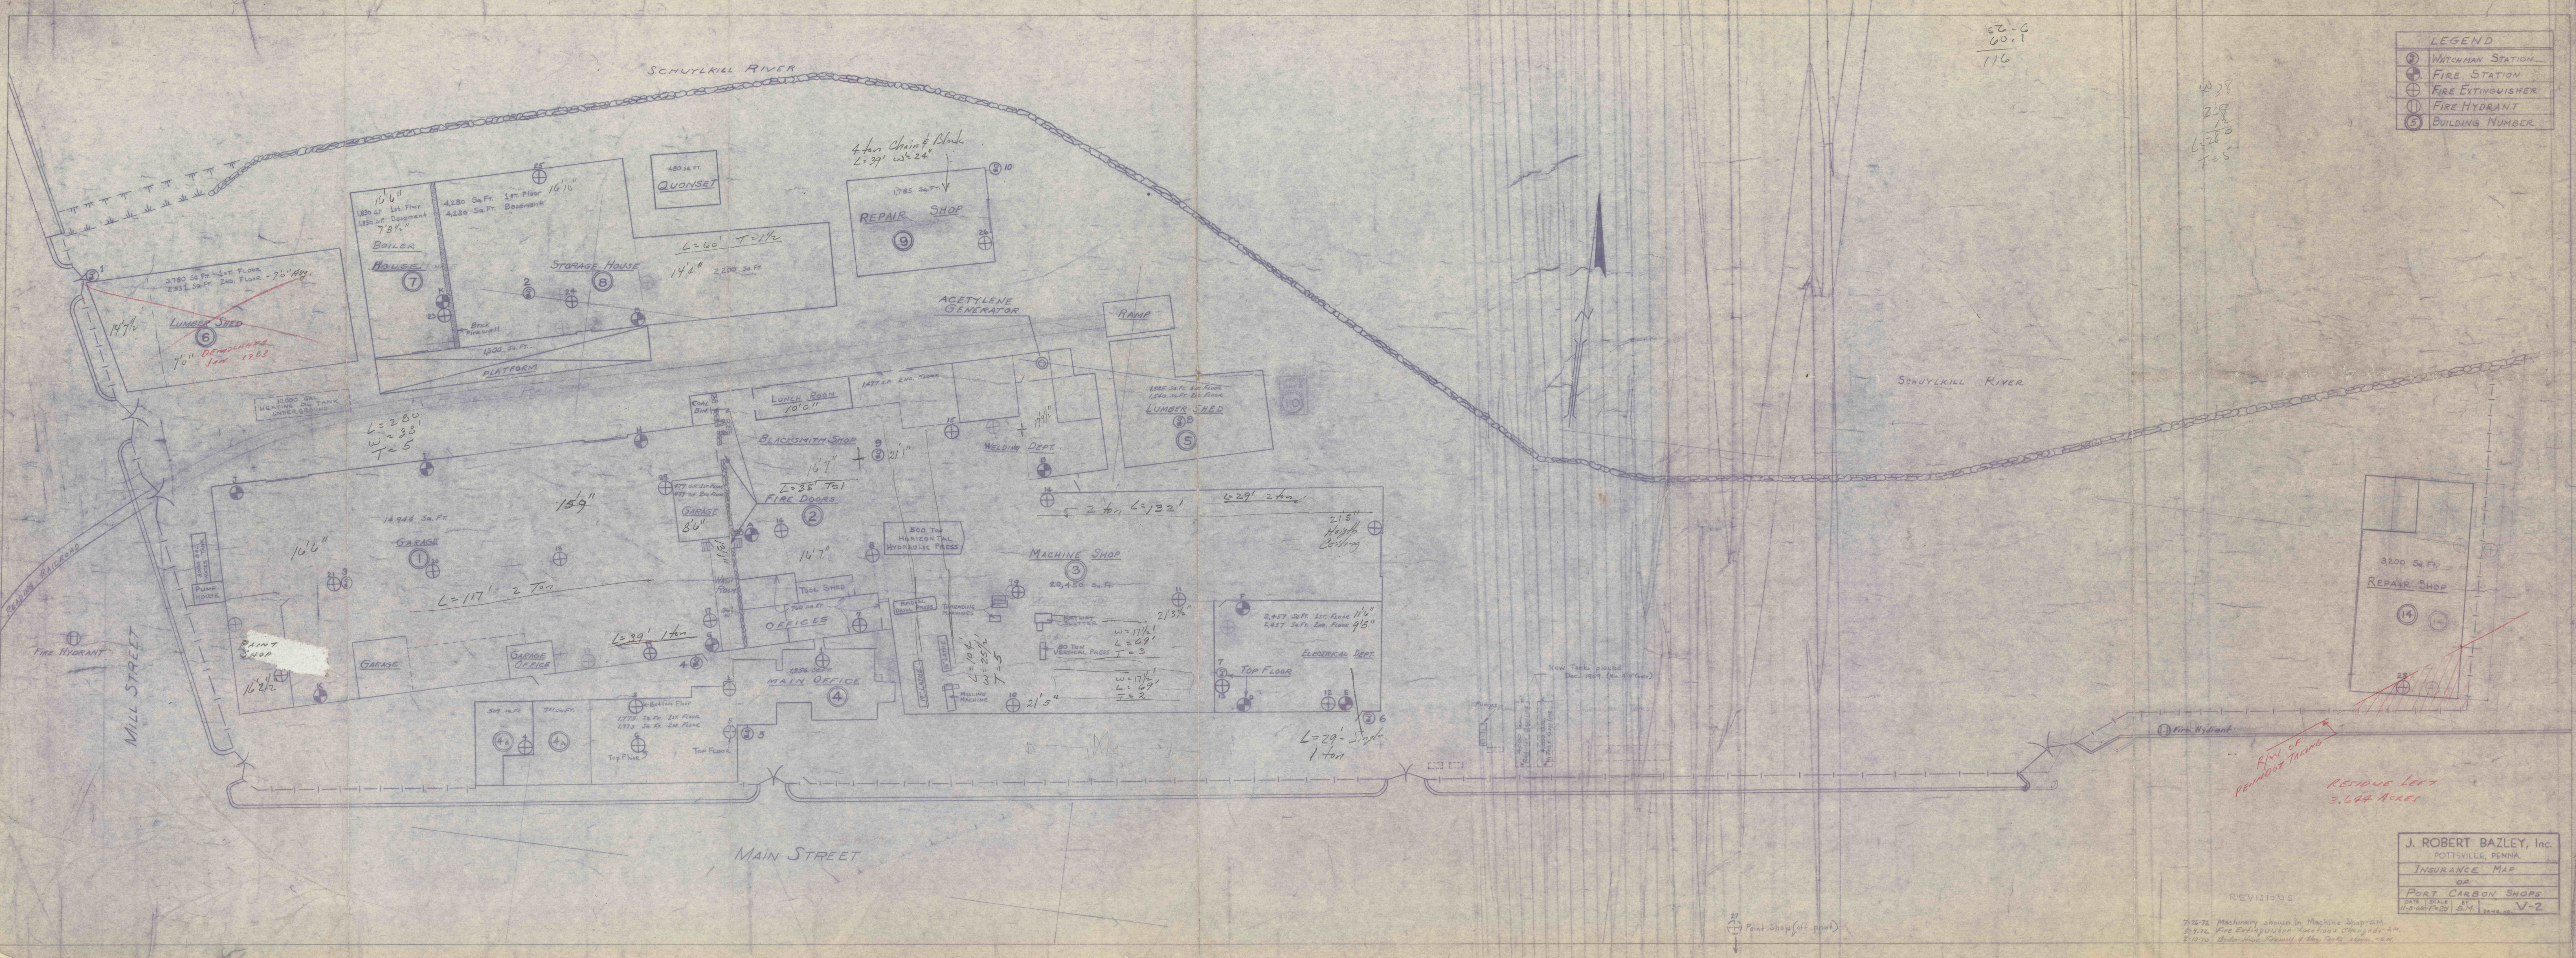

REVISIONS
REVISED LEFT
3.644 ACRES

J. ROBERT BAZLEY, Inc.	
POTTSVILLE, PENNA.	
INSURANCE MAP	
OF	
PORT CARBON SHOPS	
DATE	SCALE
11-8-60	1"=20'
BY	BY
S.M.	S.M.
REVISED	V-2

7-26-72 Machinery shown in Machine Shop-S.M.
2-9-72 Fire Extinguisher Locations Changed-S.M.
2-10-70 Boiler House Firewall & New Tanks shown-S.M.