


LEGEND	
(1)	WATCHMAN STATION
(2)	FIRE STATION
(3)	FIRE EXTINGUISHER
(4)	FIRE HYDRANT
(5)	BUILDING NUMBER

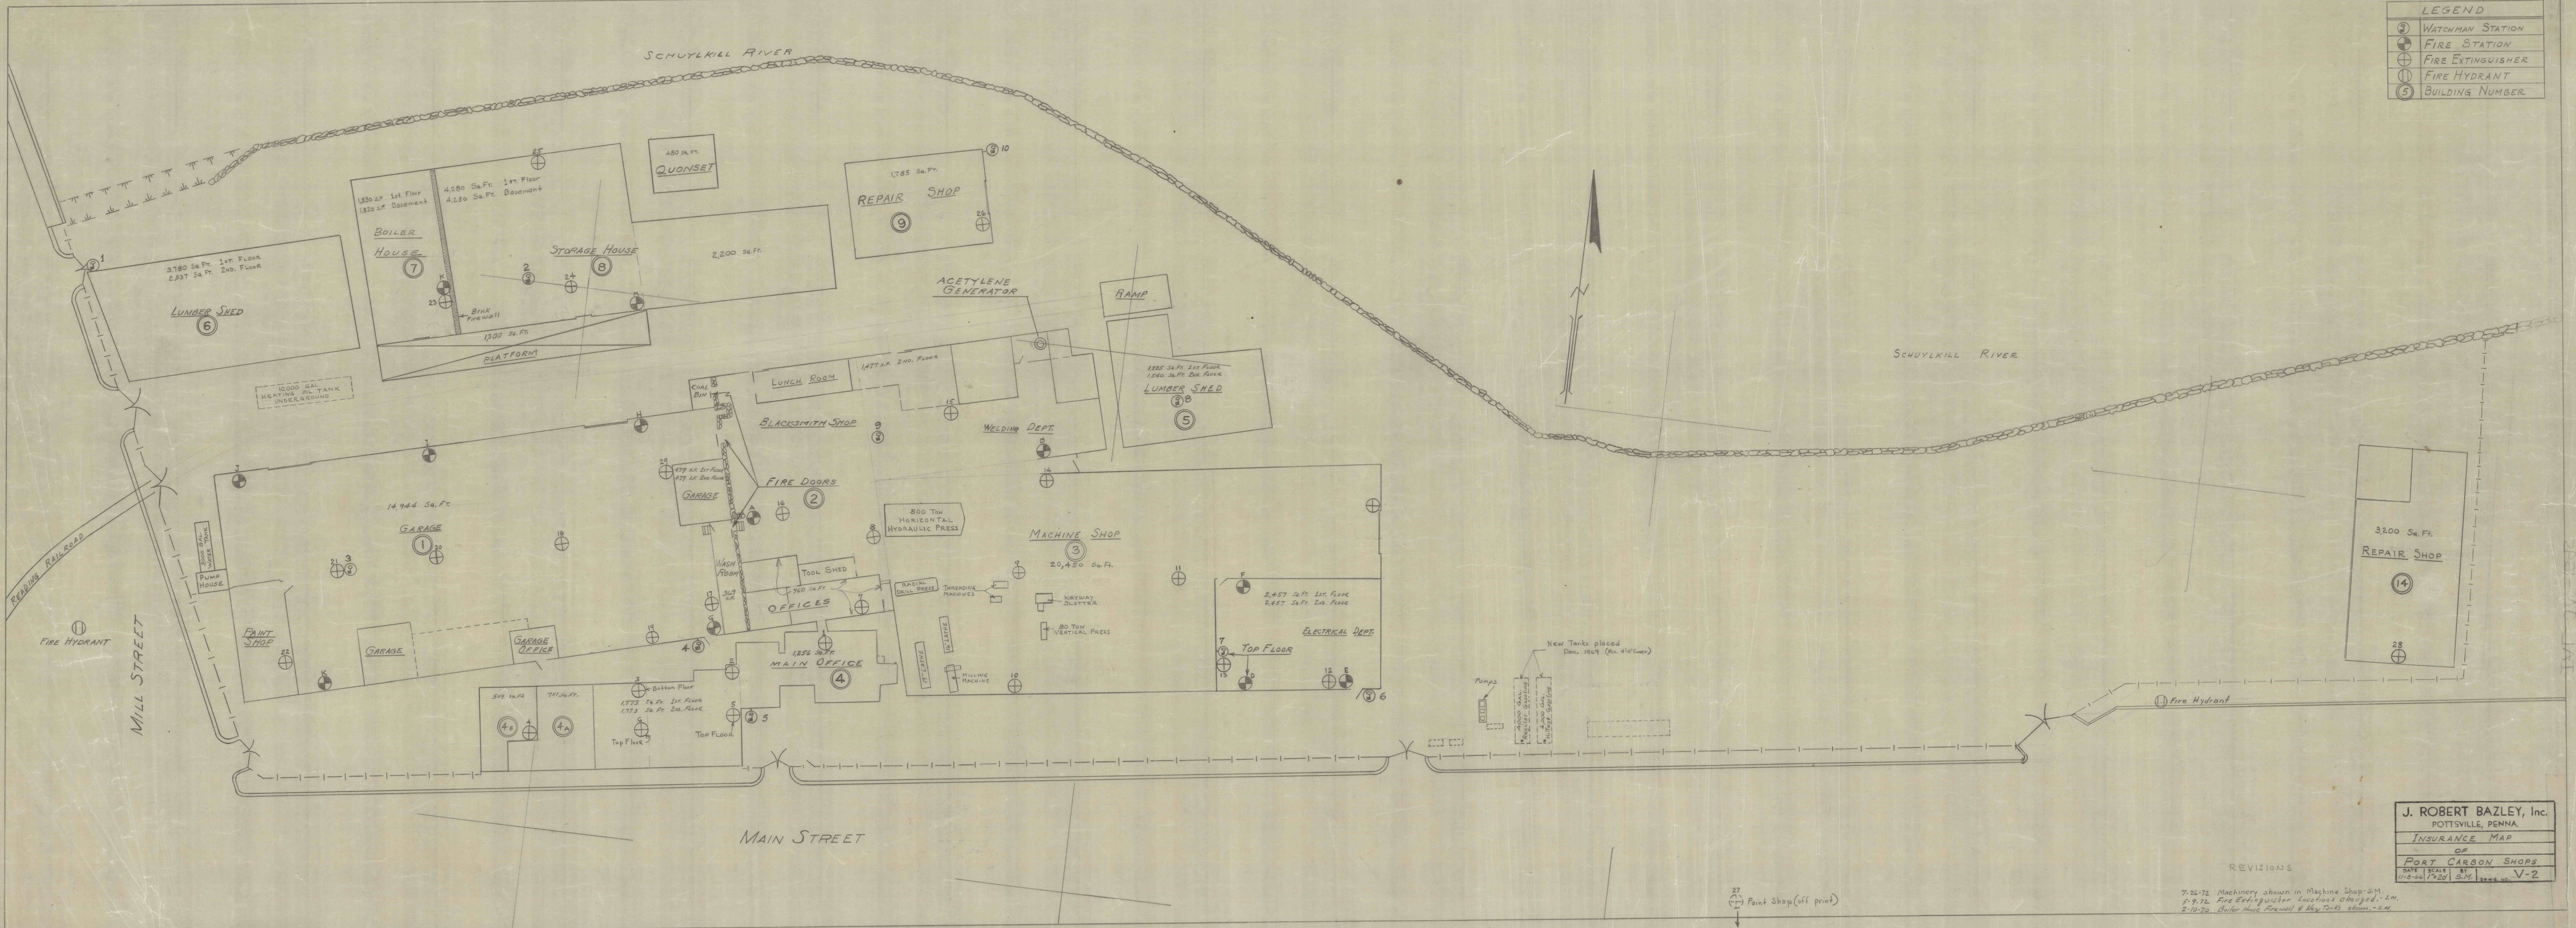

J. ROBERT BAZLEY, Inc.
POTTSVILLE, PENNA.
INSURANCE MAP
OF
PORT CARBON SHOPS
DATE 11-8-60 SCALE 1"=20' S.M. BY JRB V-2

REVISIONS

7-26-72 Machinery shown in Machine Shop-S.M.
5-9-72 Fire Extinguisher Locations changed-S.M.
2-10-70 Boiler House Firewall & New Tanks shown-S.M.

27
Paint Shop (off print)