


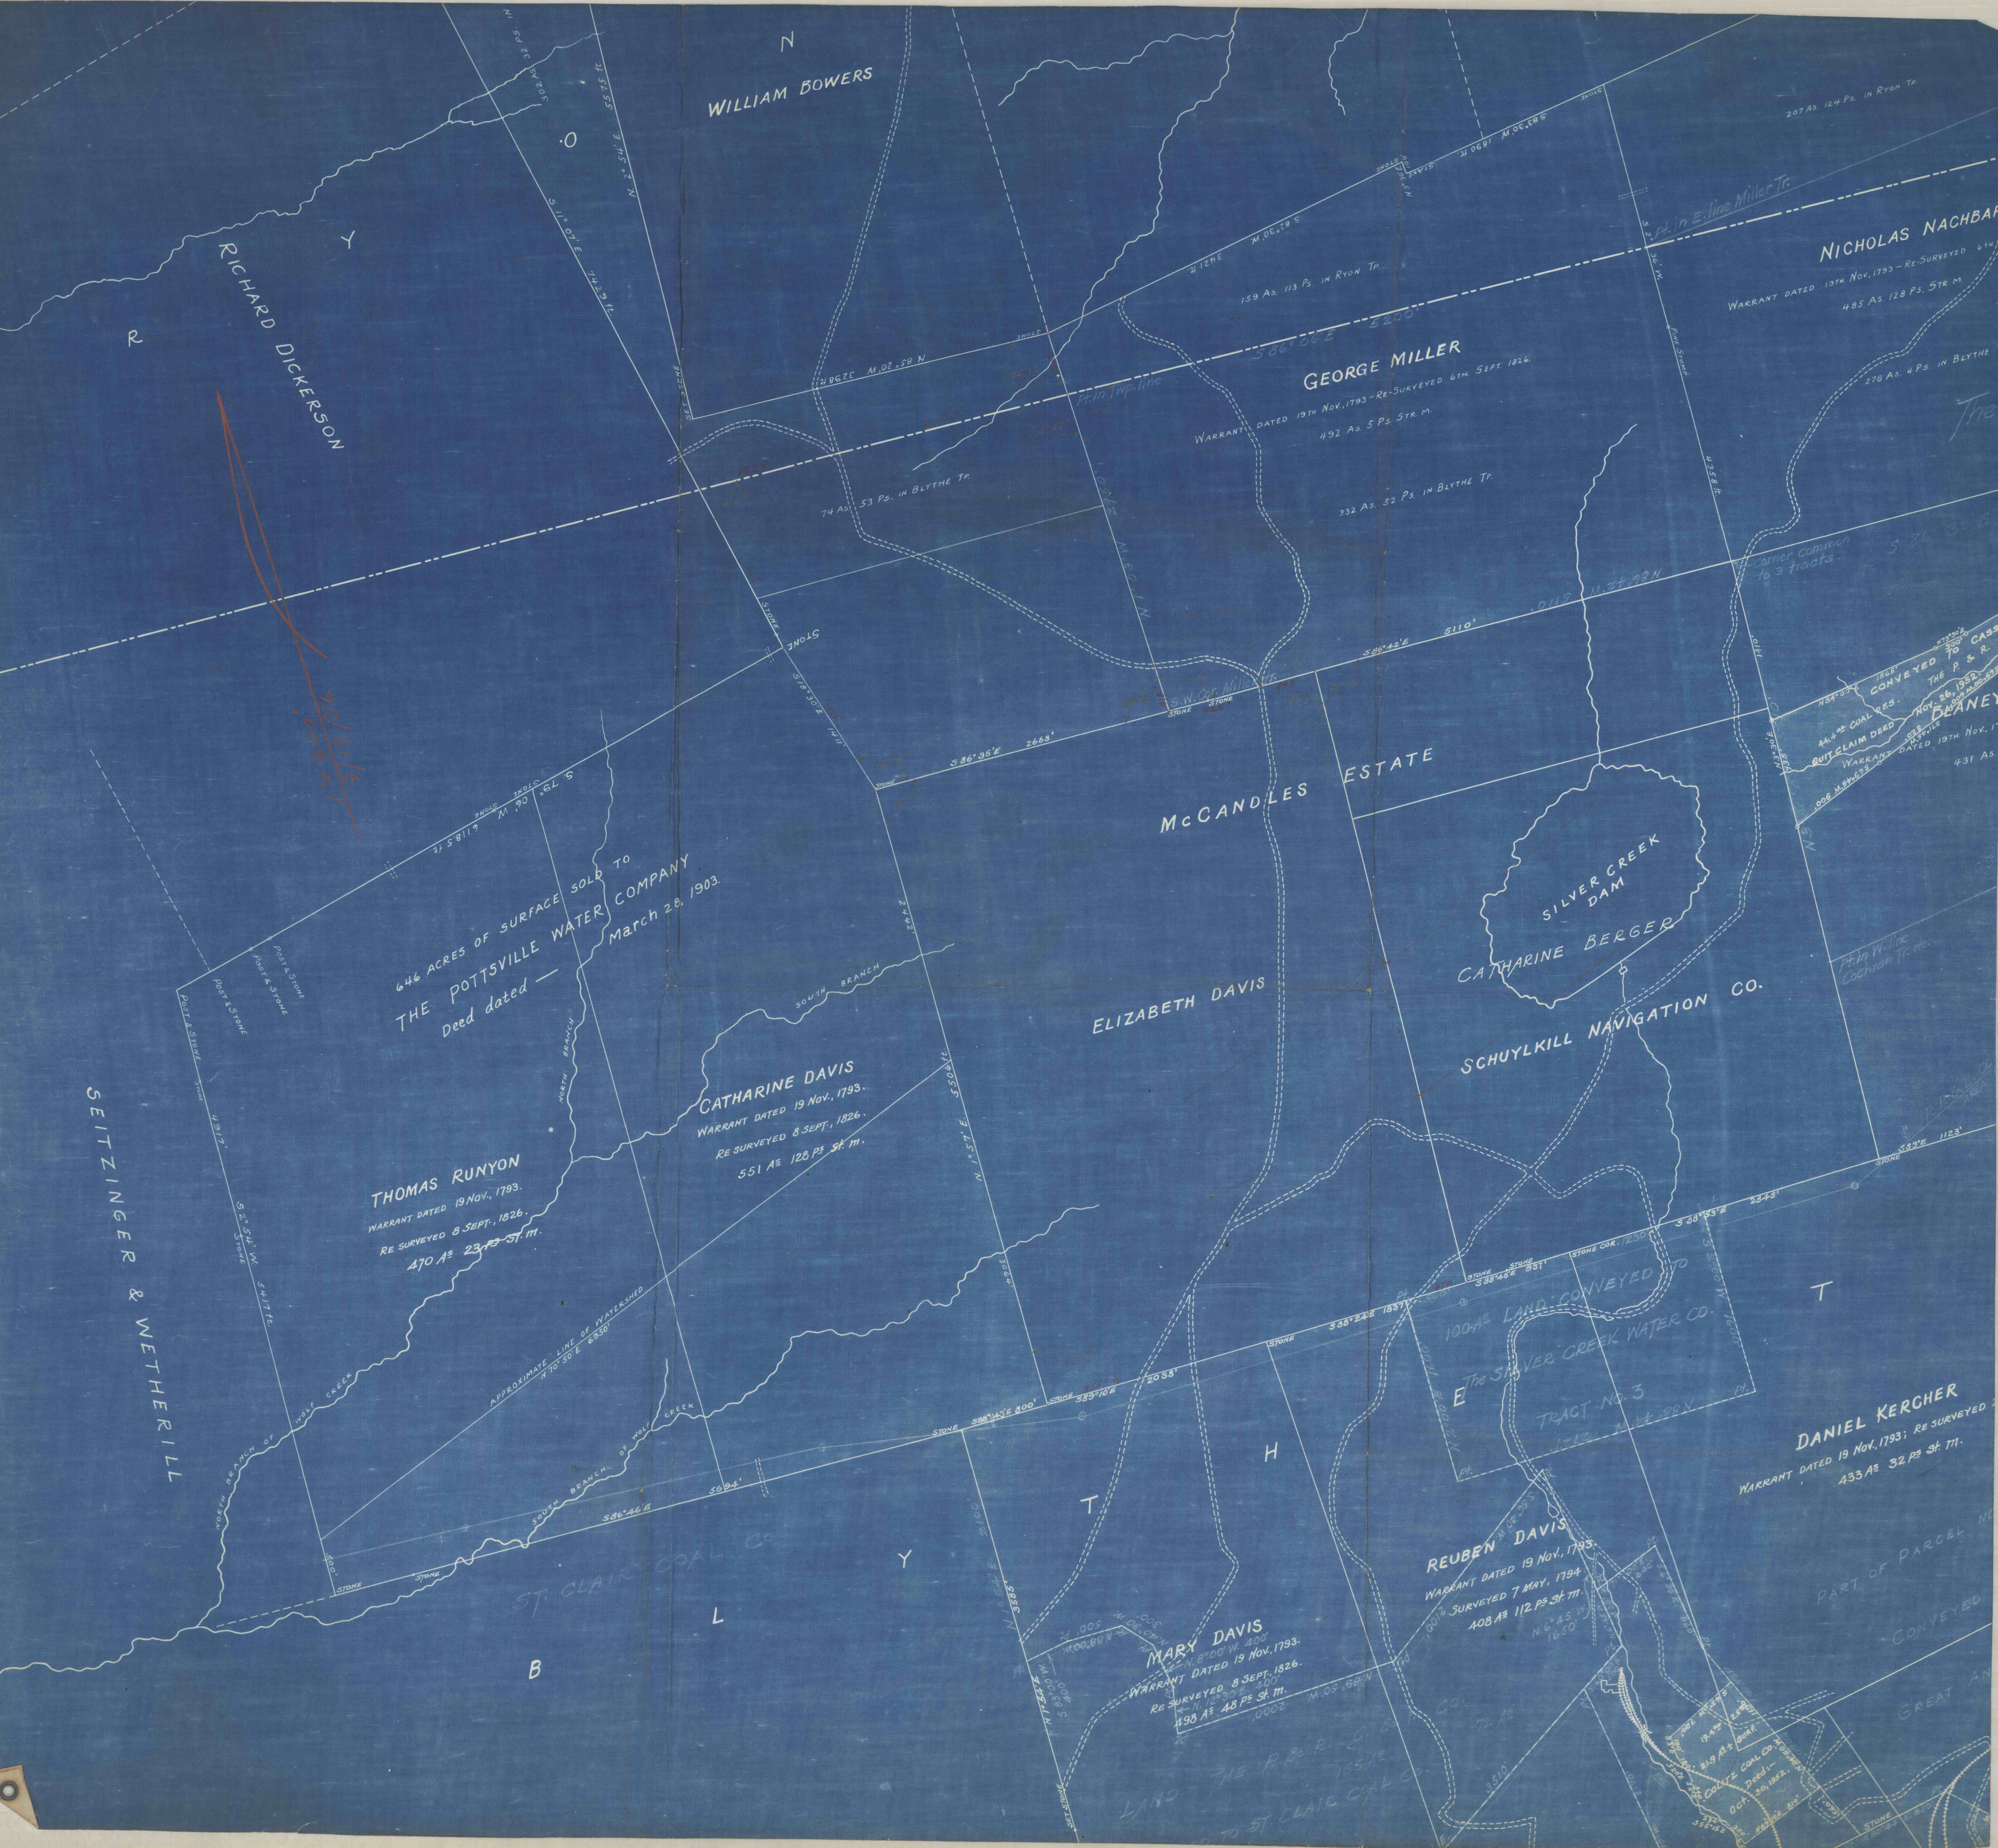

WILLIAM BOWERS

RICHARD DICKERSON

GEORGE MILLER
WARRANT DATED 19TH NOV. 1793 - RE-SURVEYED 6TH SEPT. 1826.
492 AS. 5 PS. 5 TR. M.

NICHOLAS NACHBAR
WARRANT DATED 19TH NOV. 1793 - RE-SURVEYED 6TH SEPT. 1826.
485 AS. 128 PS. 5 TR. M.

MCCANDLES ESTATE

ELIZABETH DAVIS

CATHARINE DAVIS
WARRANT DATED 19 NOV. 1793.
RE-SURVEYED 8 SEPT. 1826.
551 AS. 128 PS. 5 TR. M.

THOMAS RUNYON
WARRANT DATED 19 NOV. 1793.
RE-SURVEYED 8 SEPT. 1826.
470 AS. 23 PS. 5 TR. M.

SILVER CREEK DAM
CATHARINE BERGER

SCHUYLKILL NAVIGATION CO.

DANIEL KERCHER
WARRANT DATED 19 NOV. 1793; RE-SURVEYED 8 SEPT. 1826.
433 AS. 32 PS. 5 TR. M.

REUBEN DAVIS
WARRANT DATED 19 NOV. 1793.
RE-SURVEYED 7 MAY. 1794.
408 AS. 112 PS. 5 TR. M.

MARY DAVIS
WARRANT DATED 19 NOV. 1793.
RE-SURVEYED 8 SEPT. 1826.
498 AS. 48 PS. 5 TR. M.

646 ACRES OF SURFACE SOLD TO
THE POTTSVILLE WATER COMPANY
Deed dated March 28, 1903.

TRACT NO. 3

ST. CLAIR COAL CO.

SEITZINGER & WETHERILL