


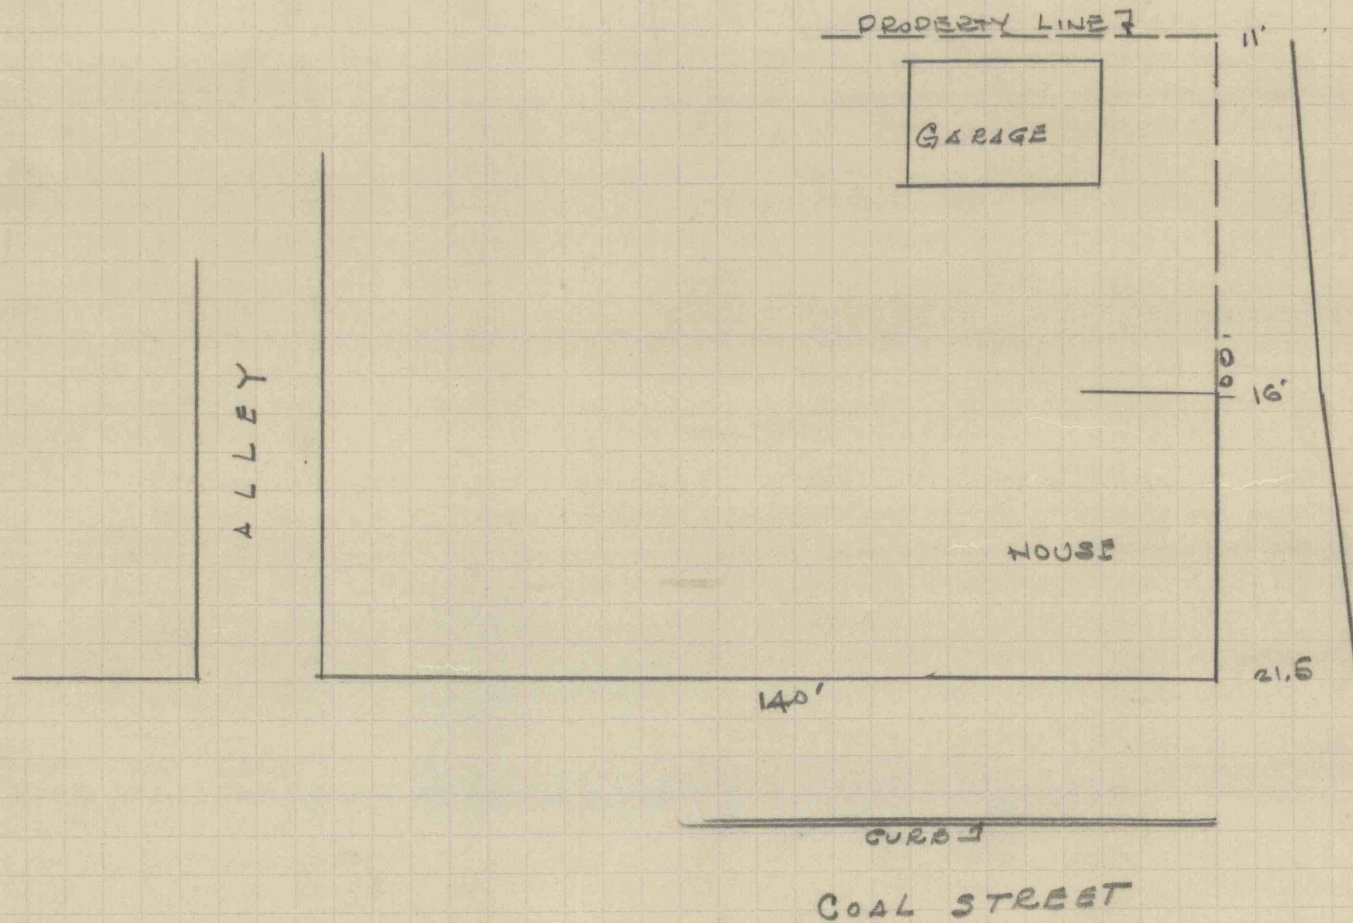

1101-MI-JAI

SCALE 1" = 30'
Y-17