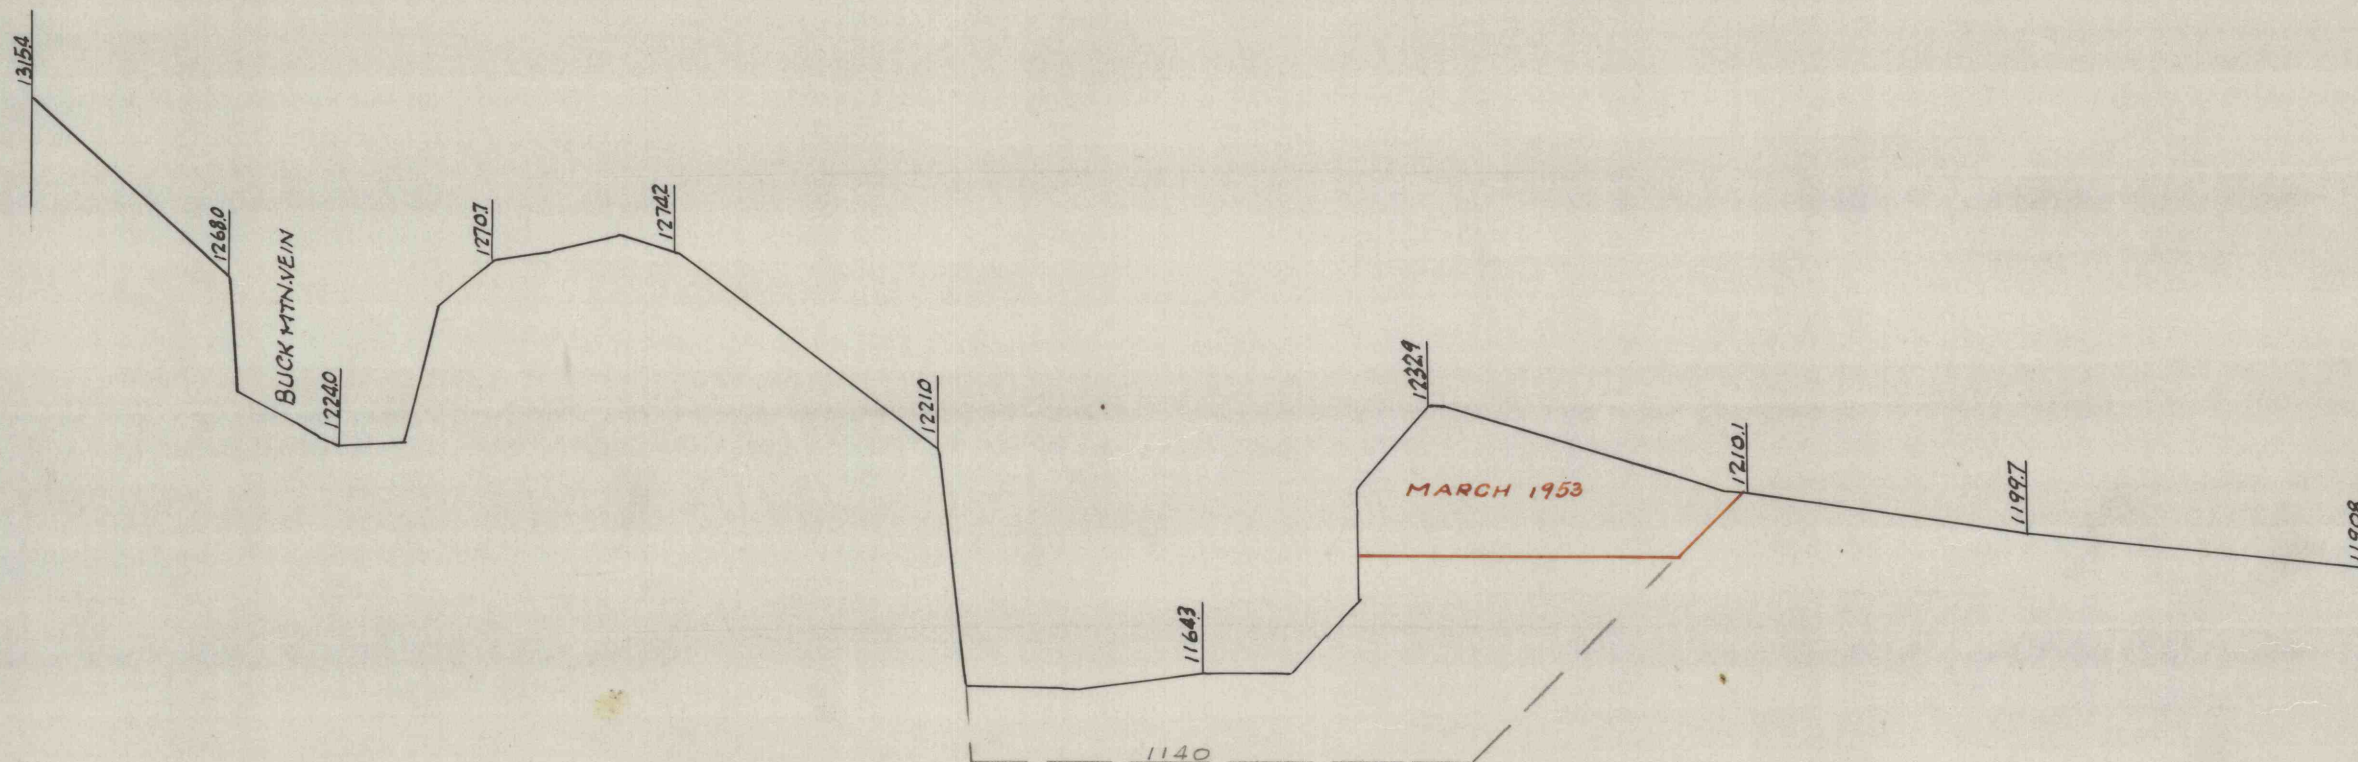


J. ROBERT BAZLEY, Inc.			
POTTSVILLE, PENNA.			
ASHTON SOUTH SIDE			
STRIPPING			
SECTION 12+00WEST			
DATE	SCALE	BY	DATE
4-16-53	1"=50'		