


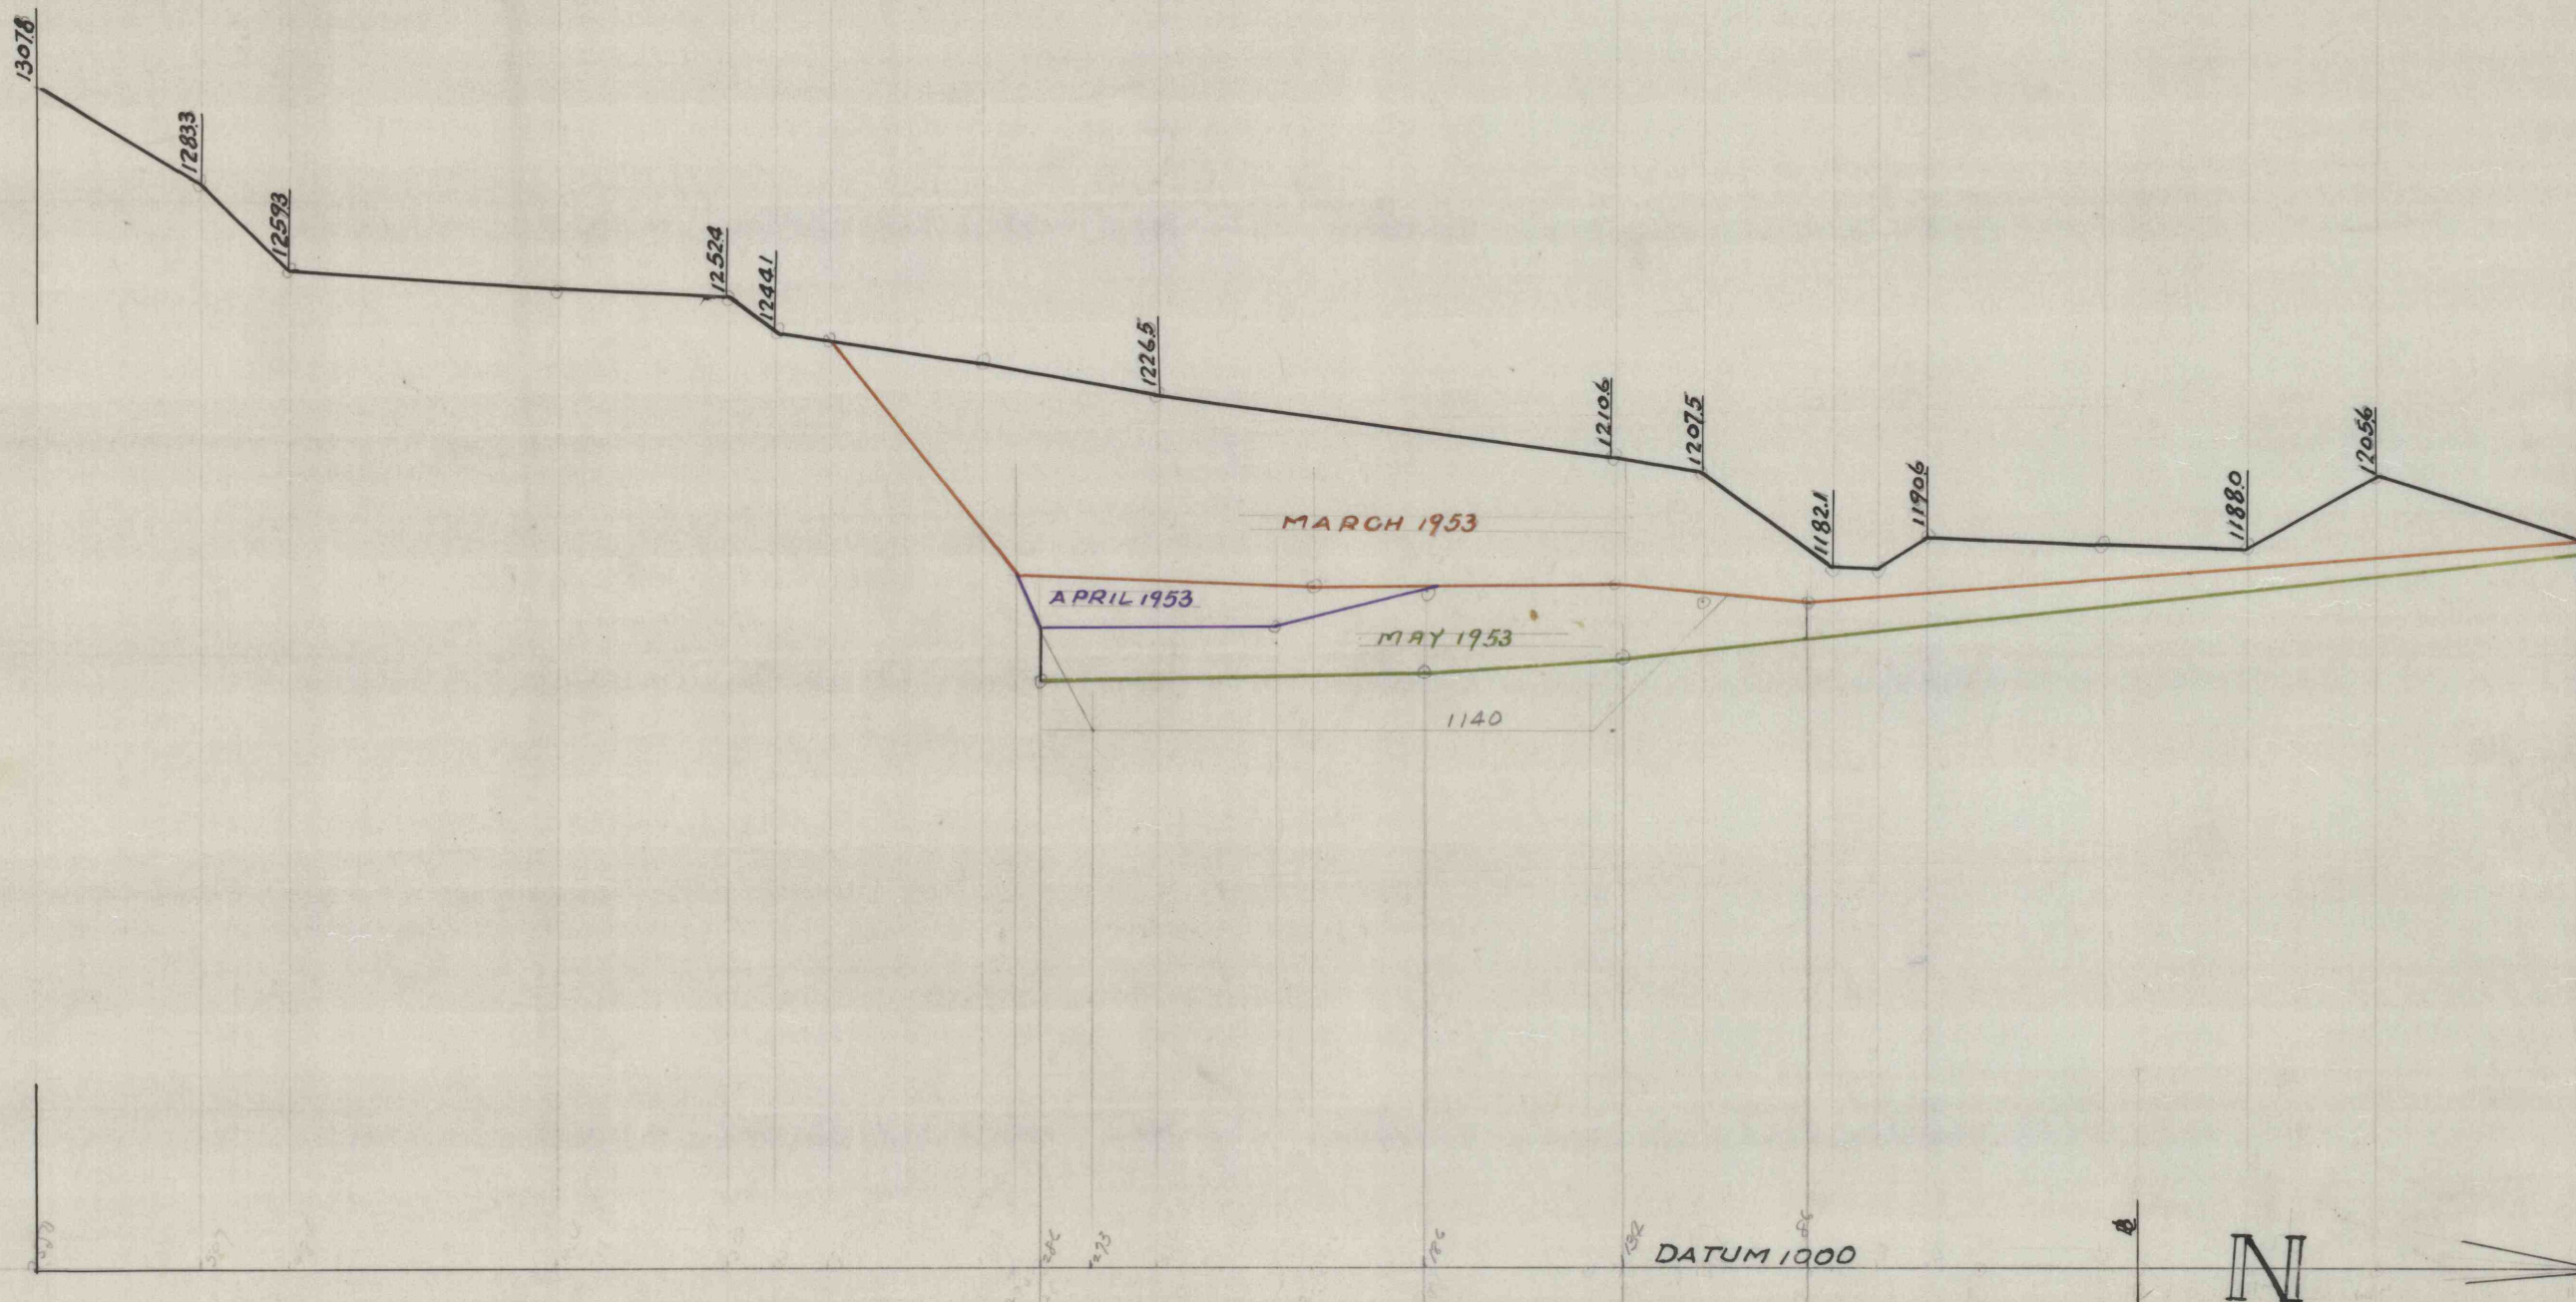

J. ROBERT BAZLEY, Inc.			
POTTSVILLE, PENNA.			
ASHTON SOUTH SIDE			
STRIPPING			
SECTION 10+00 WEST			
DATE	SCALE	BY	
4-53	1"=50'		