


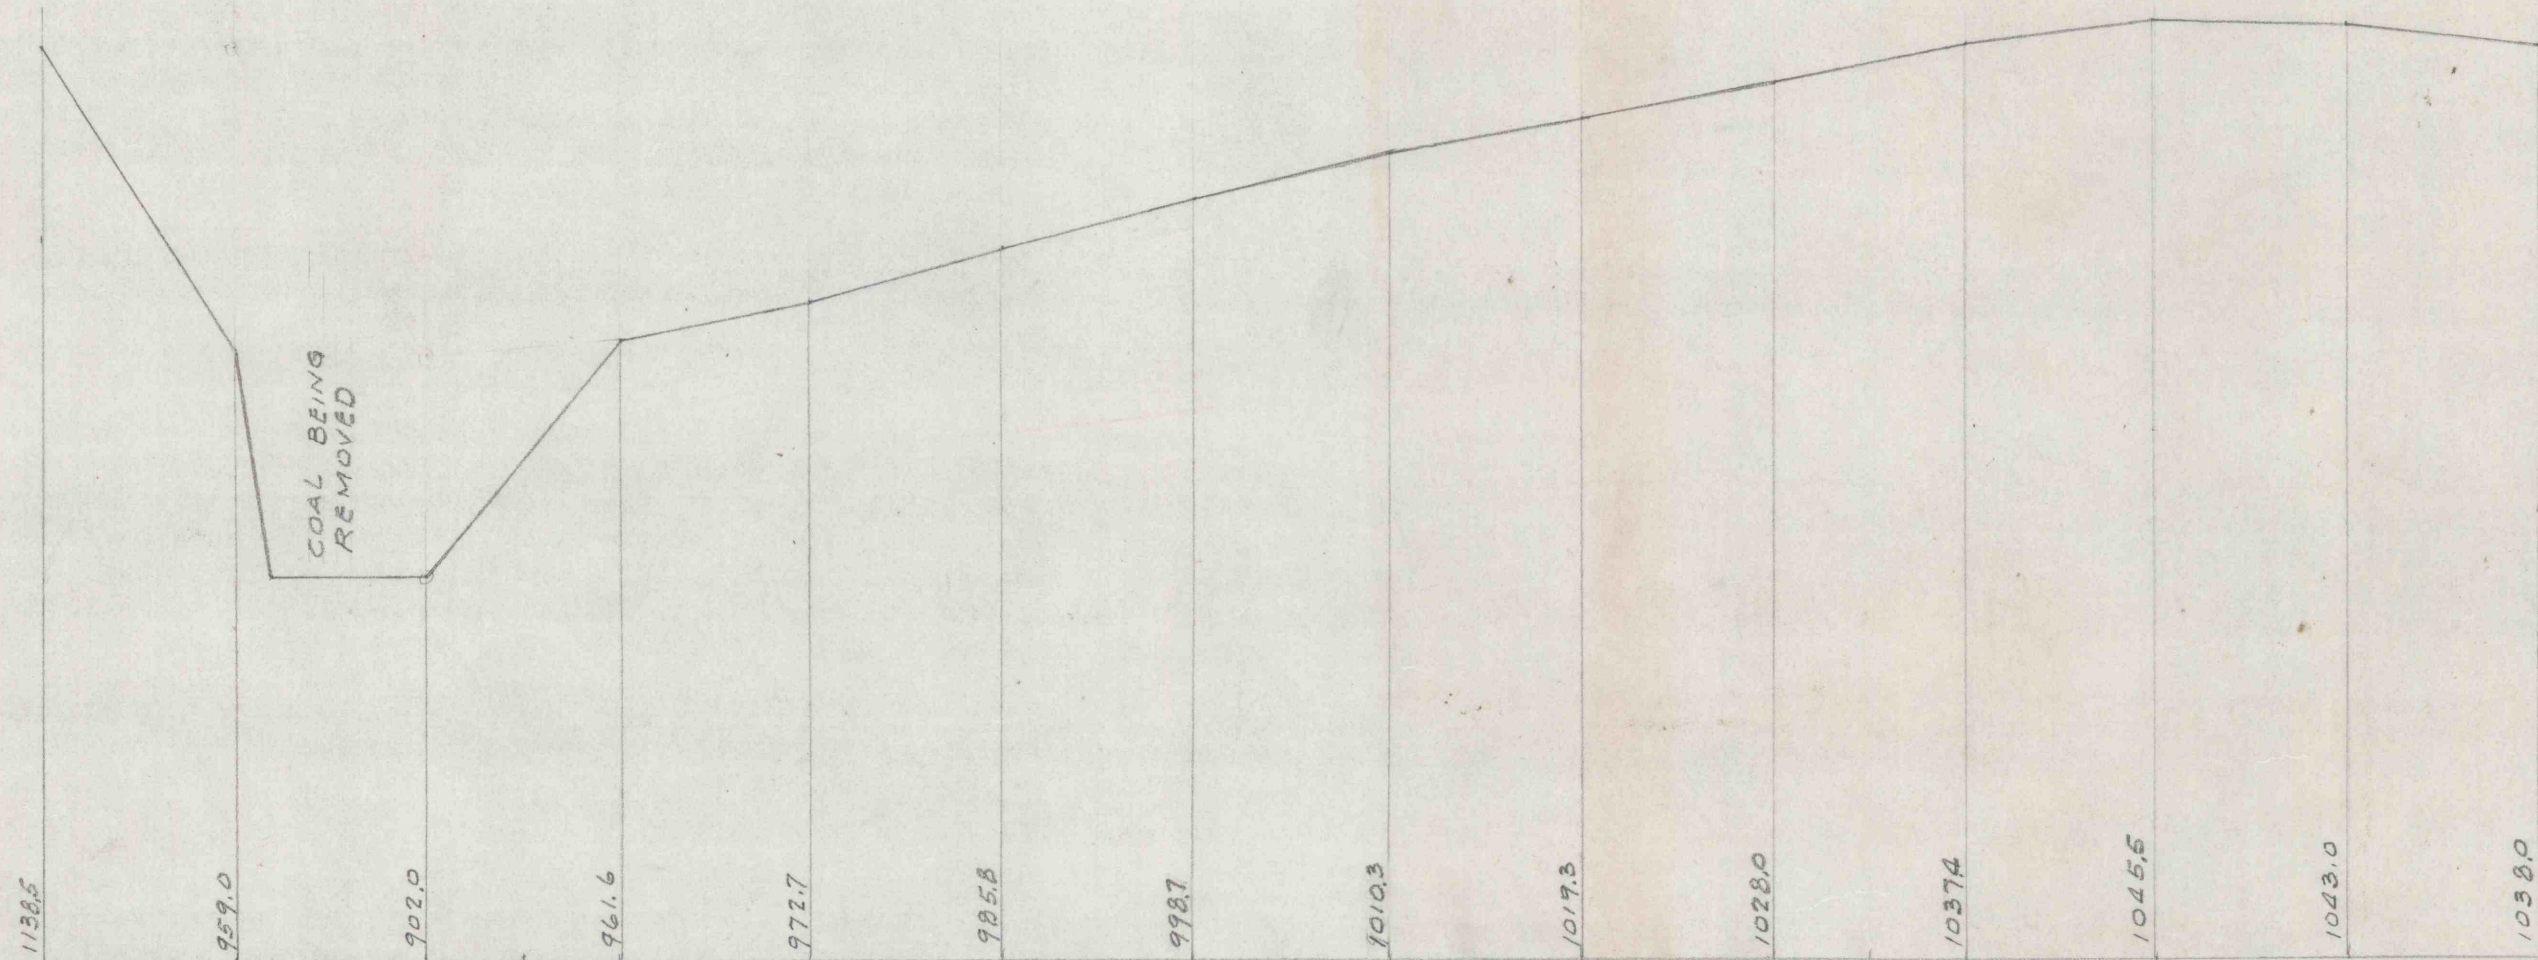

SCALE 1 IN. = 100 FT. HORIZ.
1 IN. = 50 FT. VERT.

J. ROBERT BAZLEY, Inc.			
POTTSVILLE, PENNA.			
LOCUST COAL CO			
TAMAQUA LANDS STRIPP			
PROFILE ALONG ROAD			
DATE	SCALE	BY	DRWG. NO.
12/8/49			