


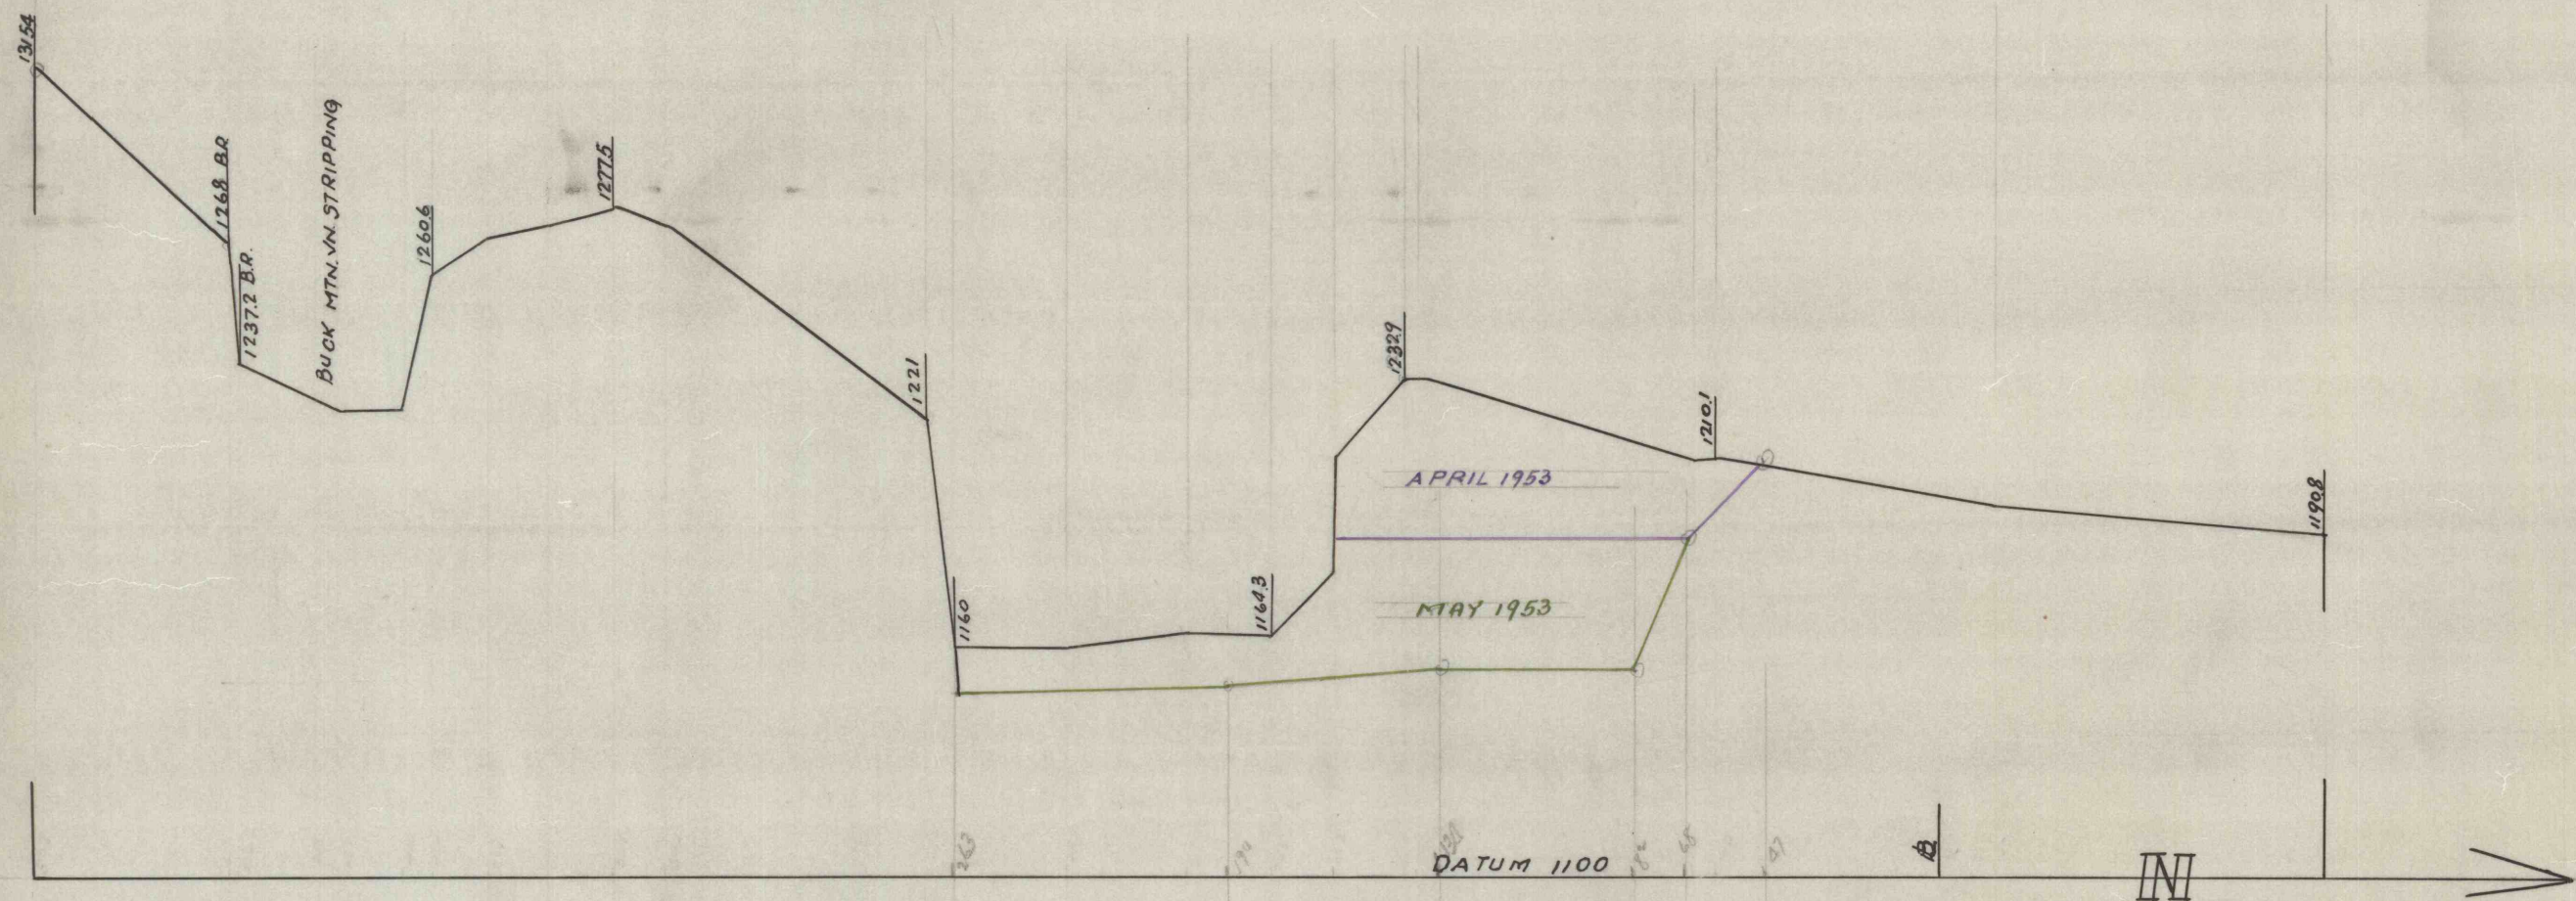

J. ROBERT BAZLEY, Inc.			
POTTSVILLE, PENNA.			
ASHTON SOUTH SIDE			
STRIPPING			
SECTION 12+00 WEST			
DATE	SCALE	BY	DATE/NO.
8-53	1"=50'		