


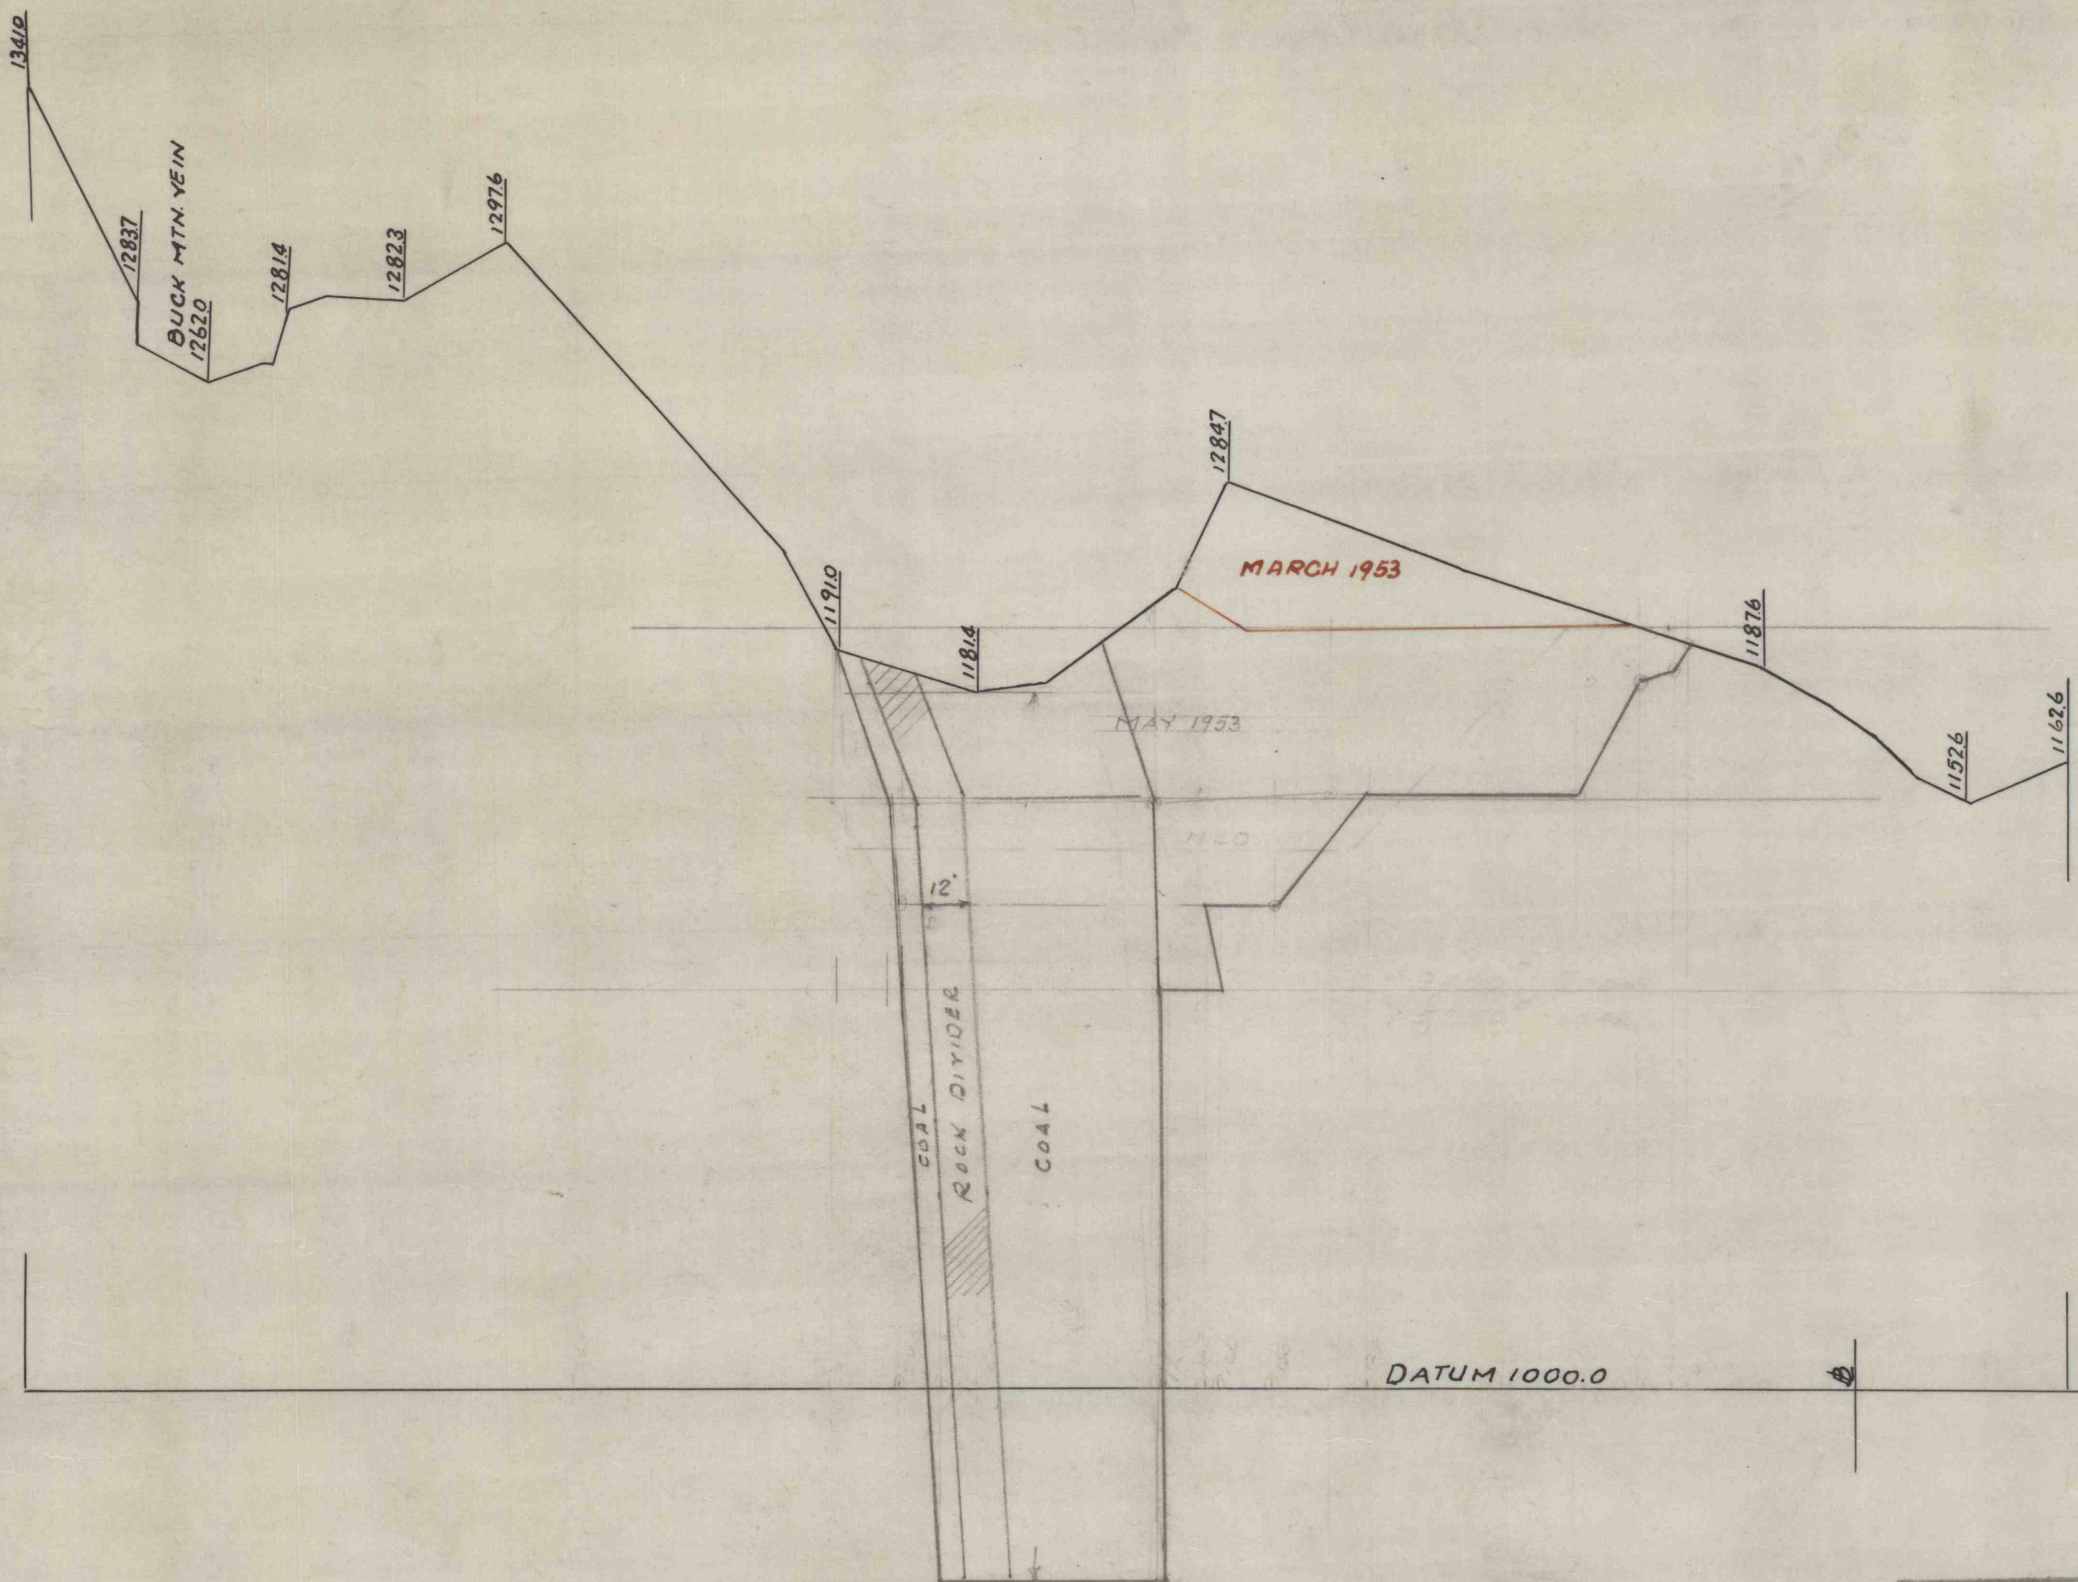

J. ROBERT BAZLEY, Inc.			
POTTSVILLE, PENNA.			
ASHTON SOUTH SIDE			
STRIPPING			
SECTION 13+00 WEST			
DATE	SCALE	BY	DATA NO.
4-53	1"=50'		T-3

2301-MC-JAT