


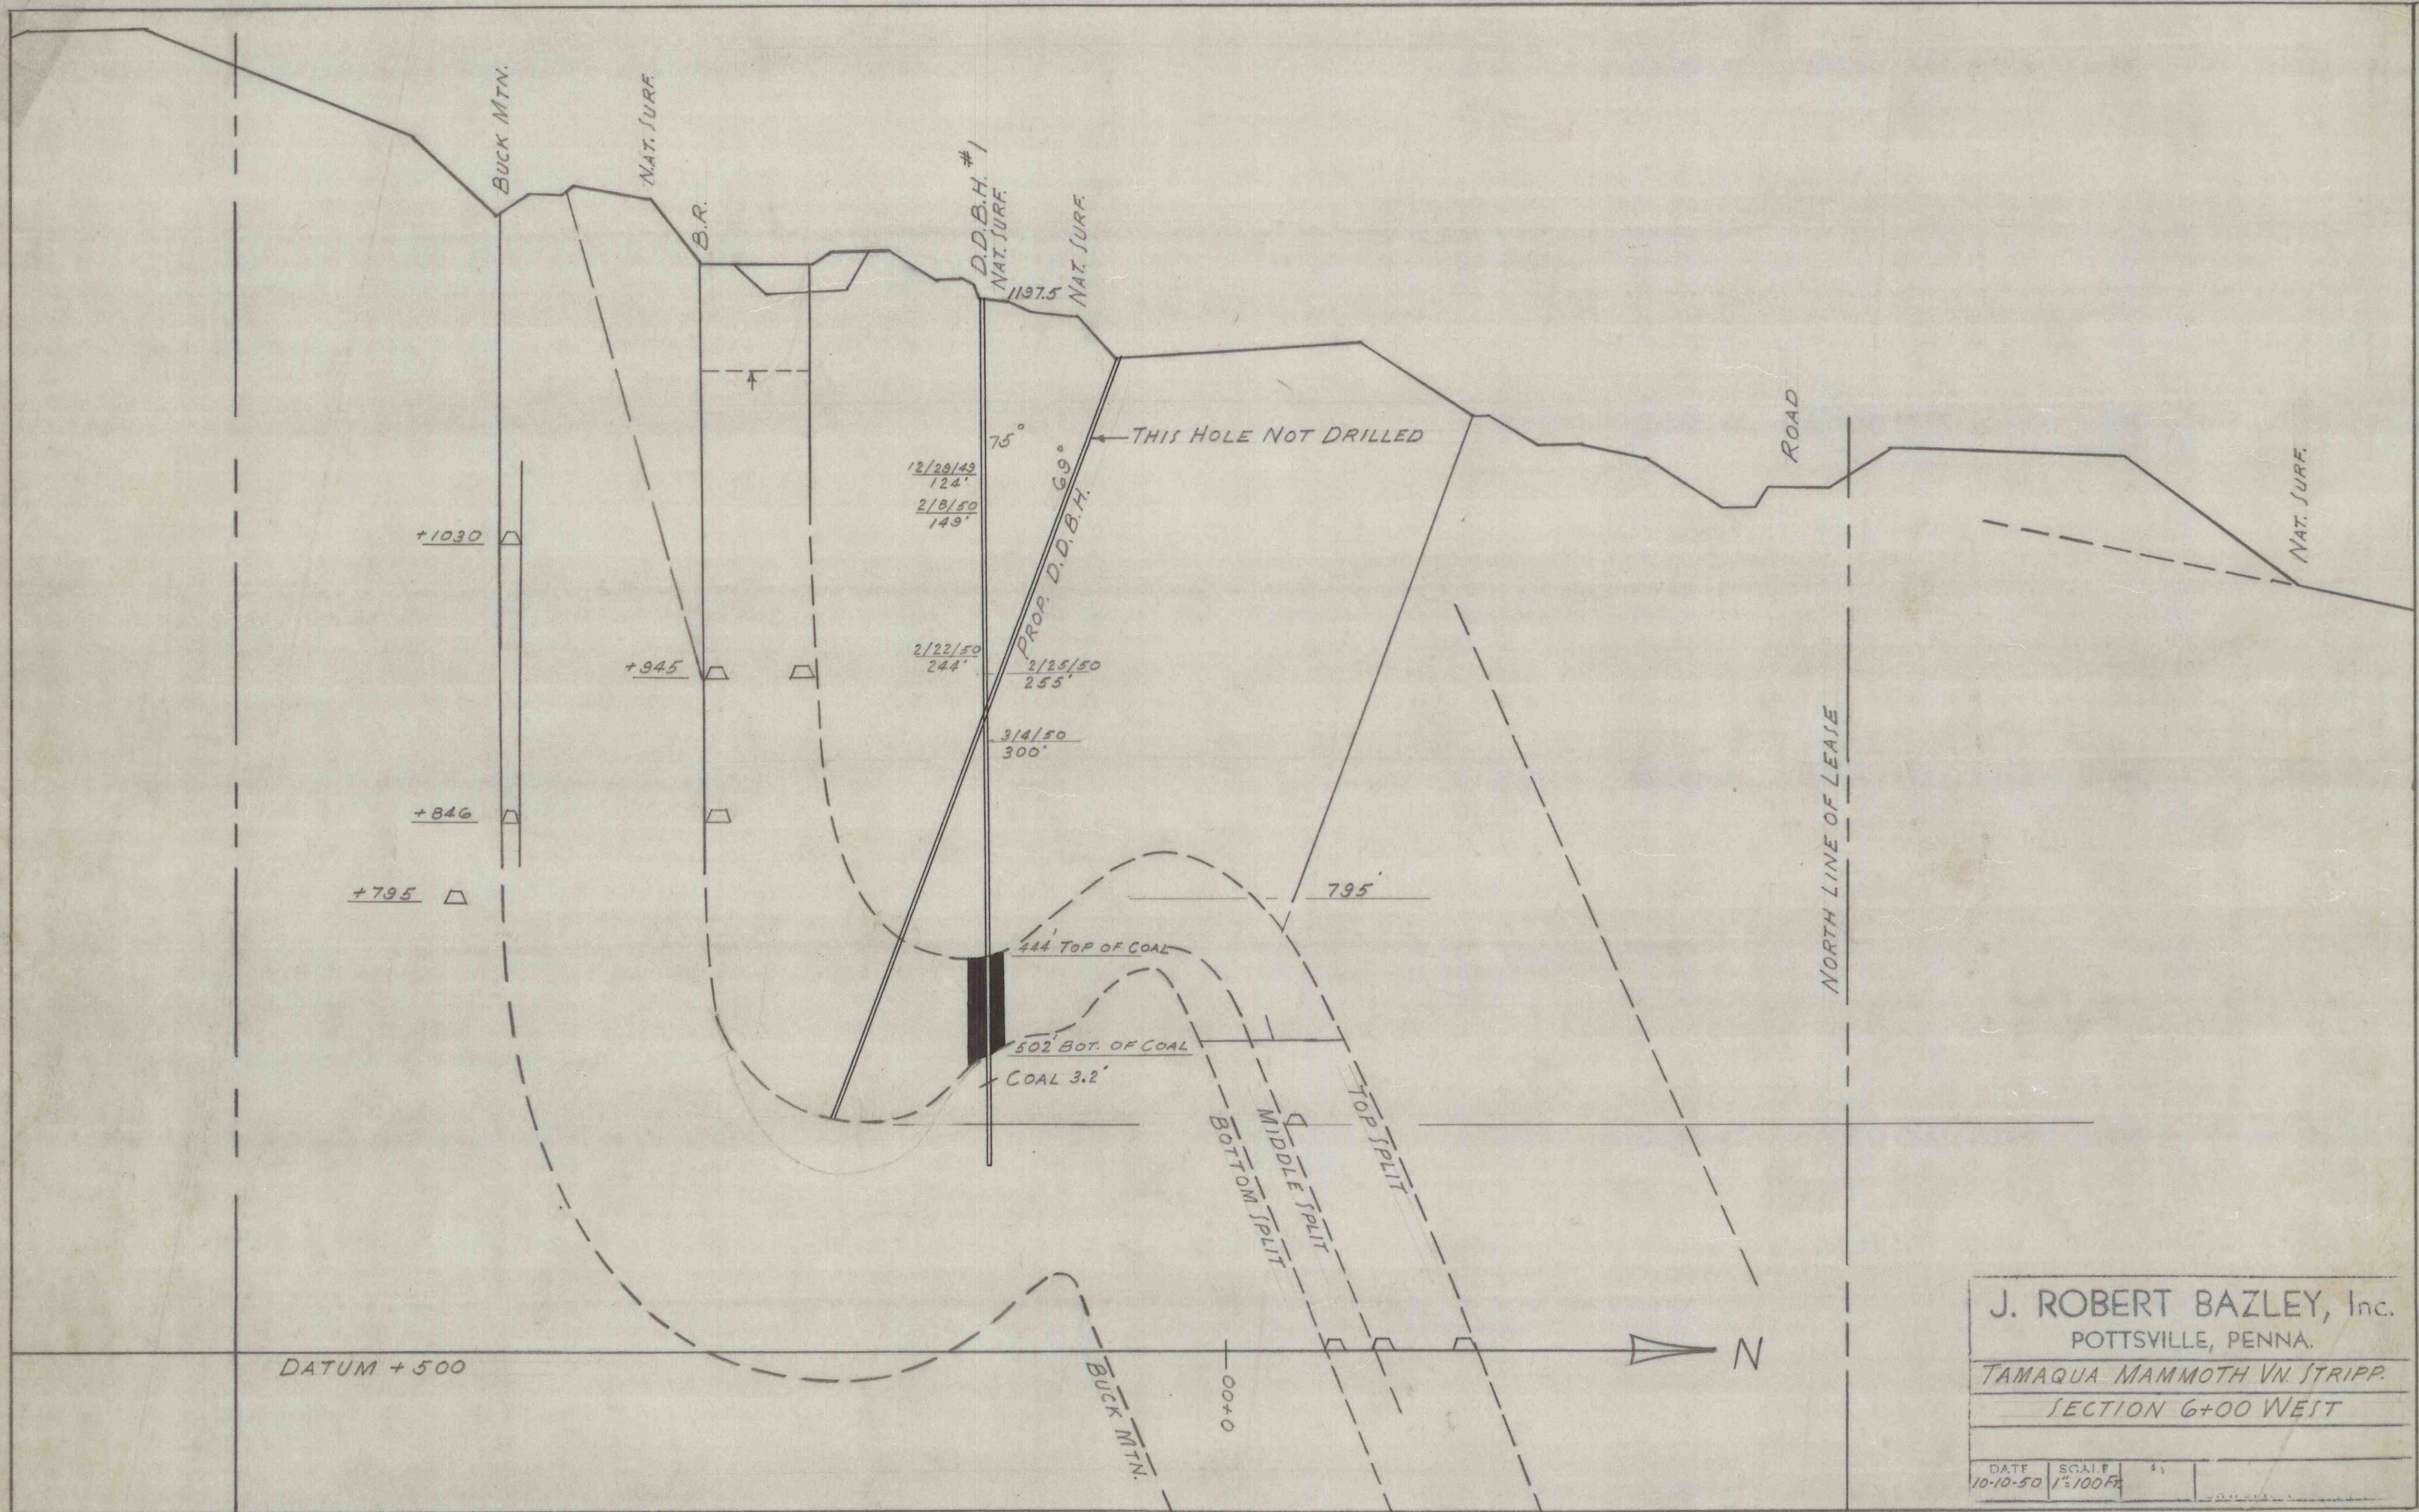

J. ROBERT BAZLEY, Inc.
POTTSVILLE, PENNA.
TAMAQUA MAMMOTH VN. STRIPP.
SECTION 6+00 WEST

DATE	SCALE	BY
10-10-50	1"=100 FT	