


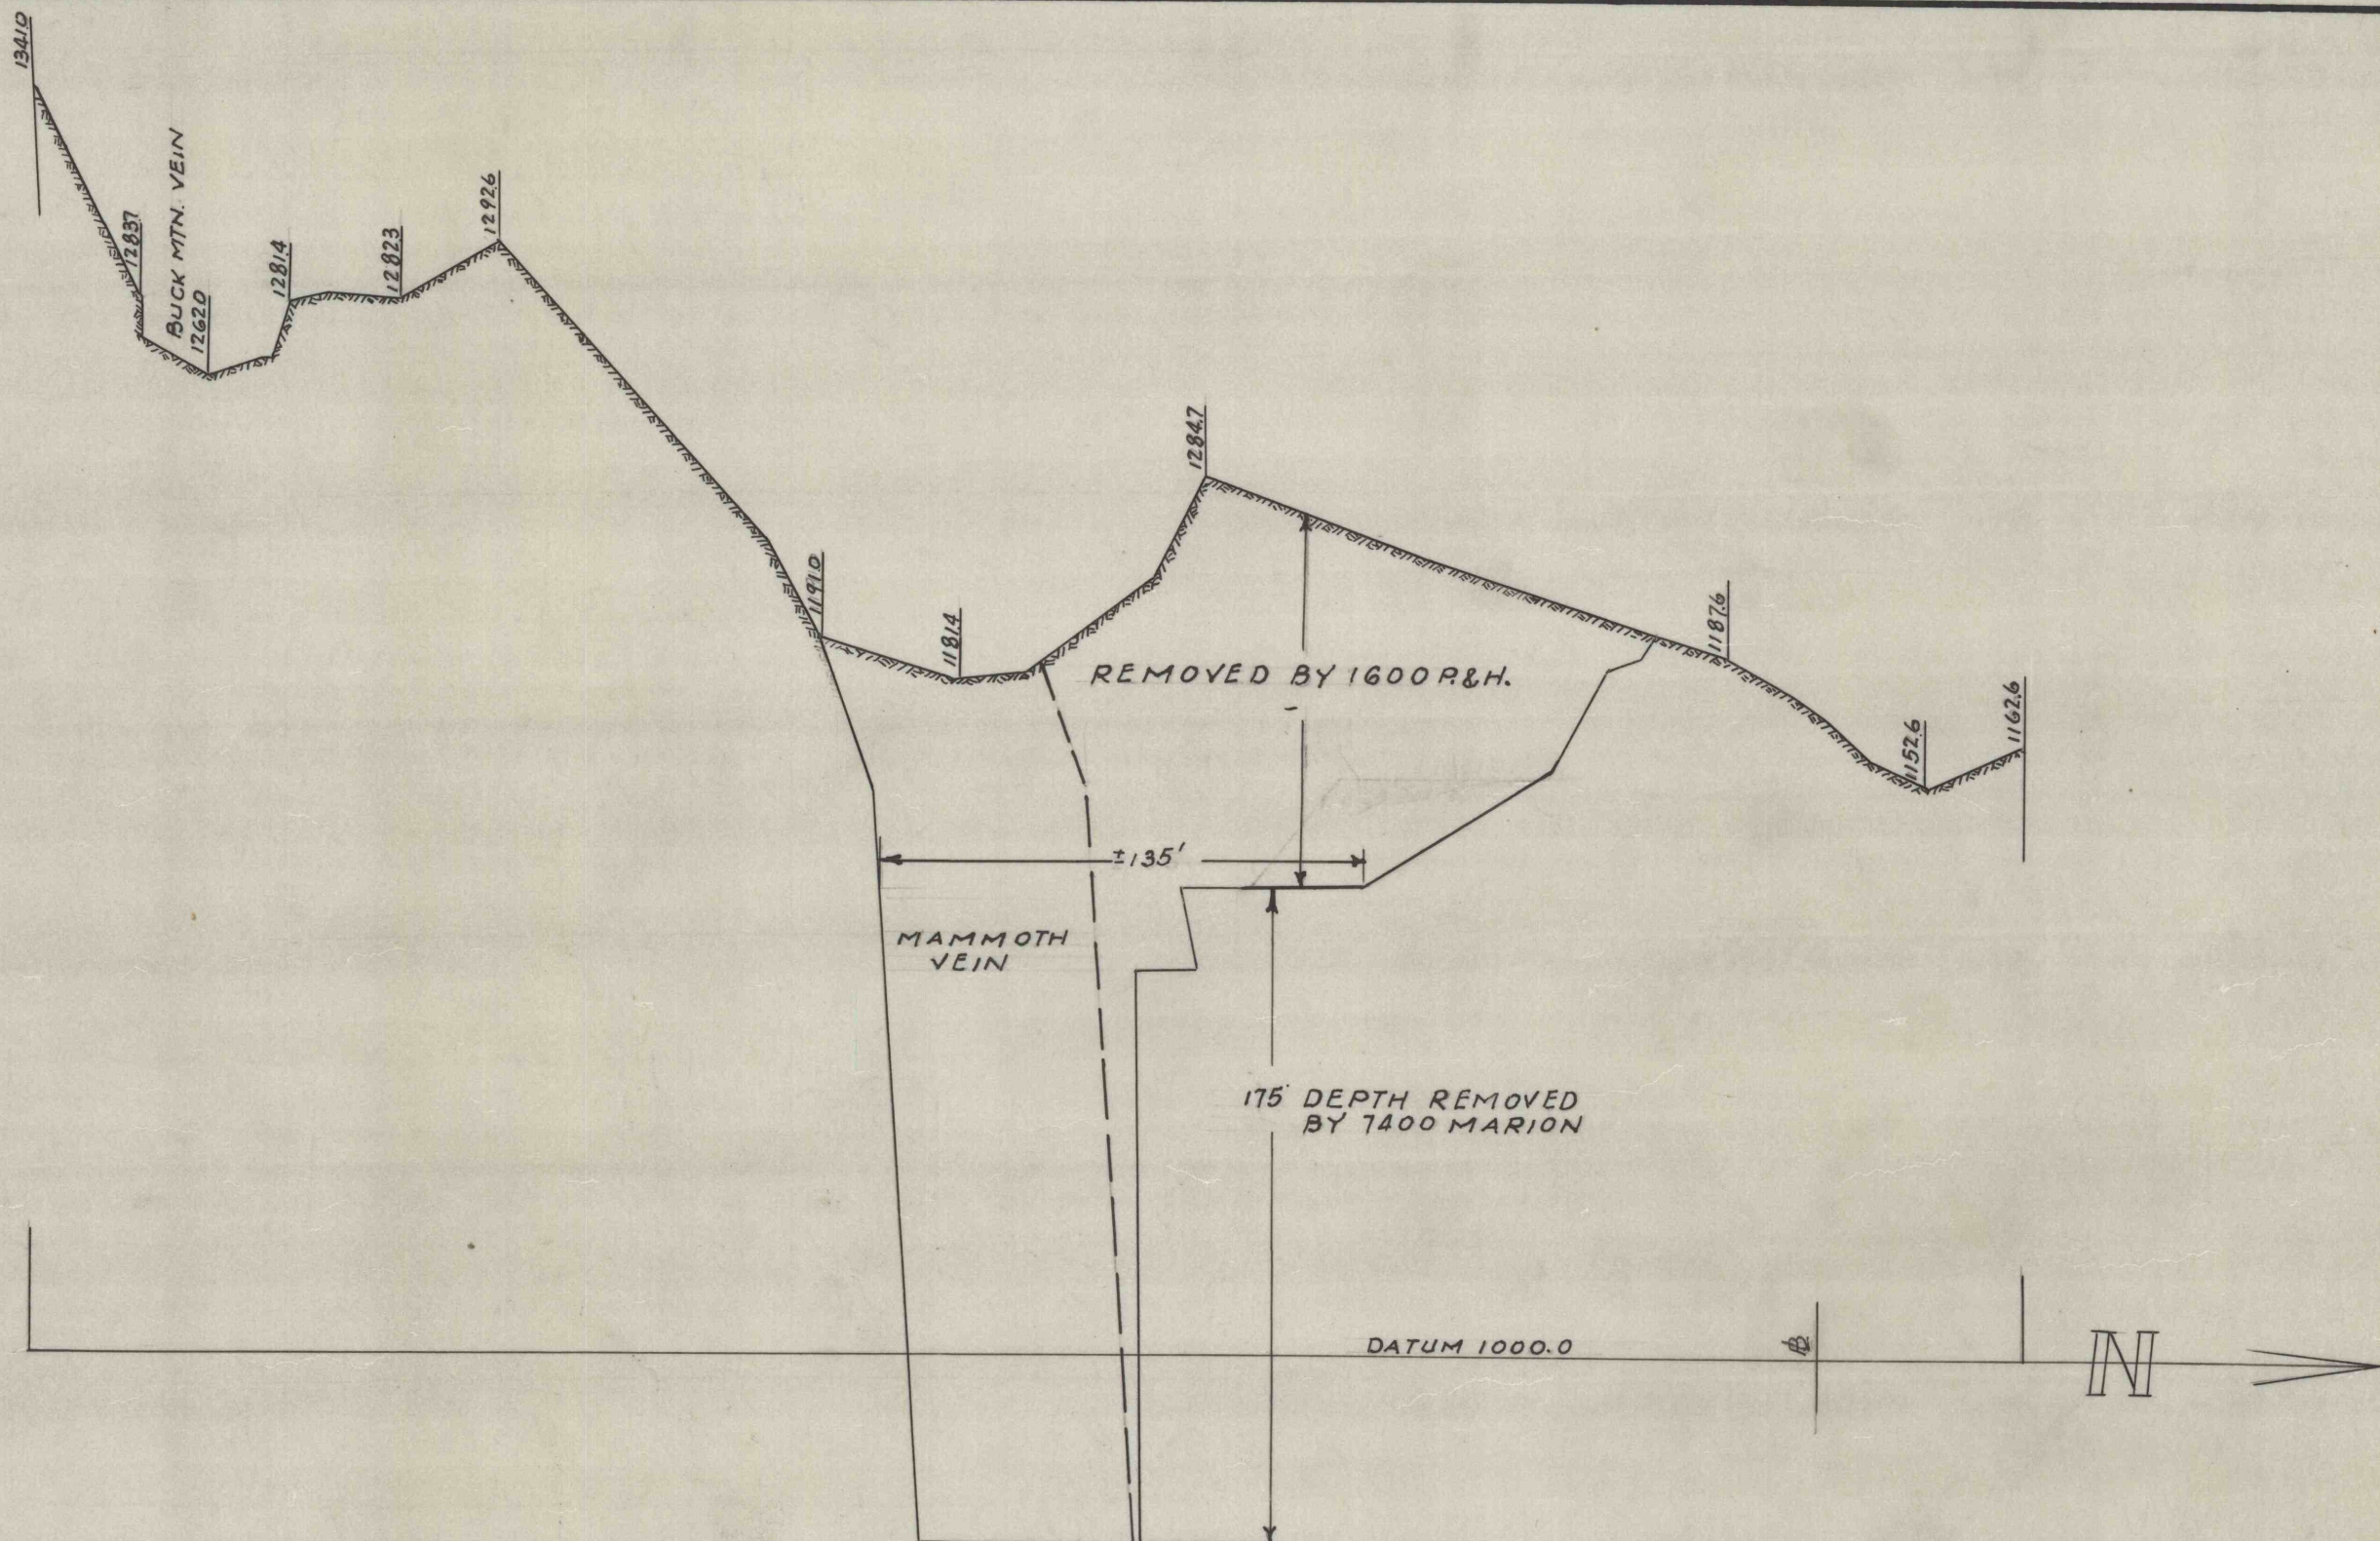

ASHTON SOUTH SIDE STRIPPING
 TYPICAL SECTION THROUGH
 COMPLETED STRIPPING
 SCALE 1"=50 FT. FEB. 6-1954
 ENG. DEPT. J. ROBERT BAZLEY INC.