


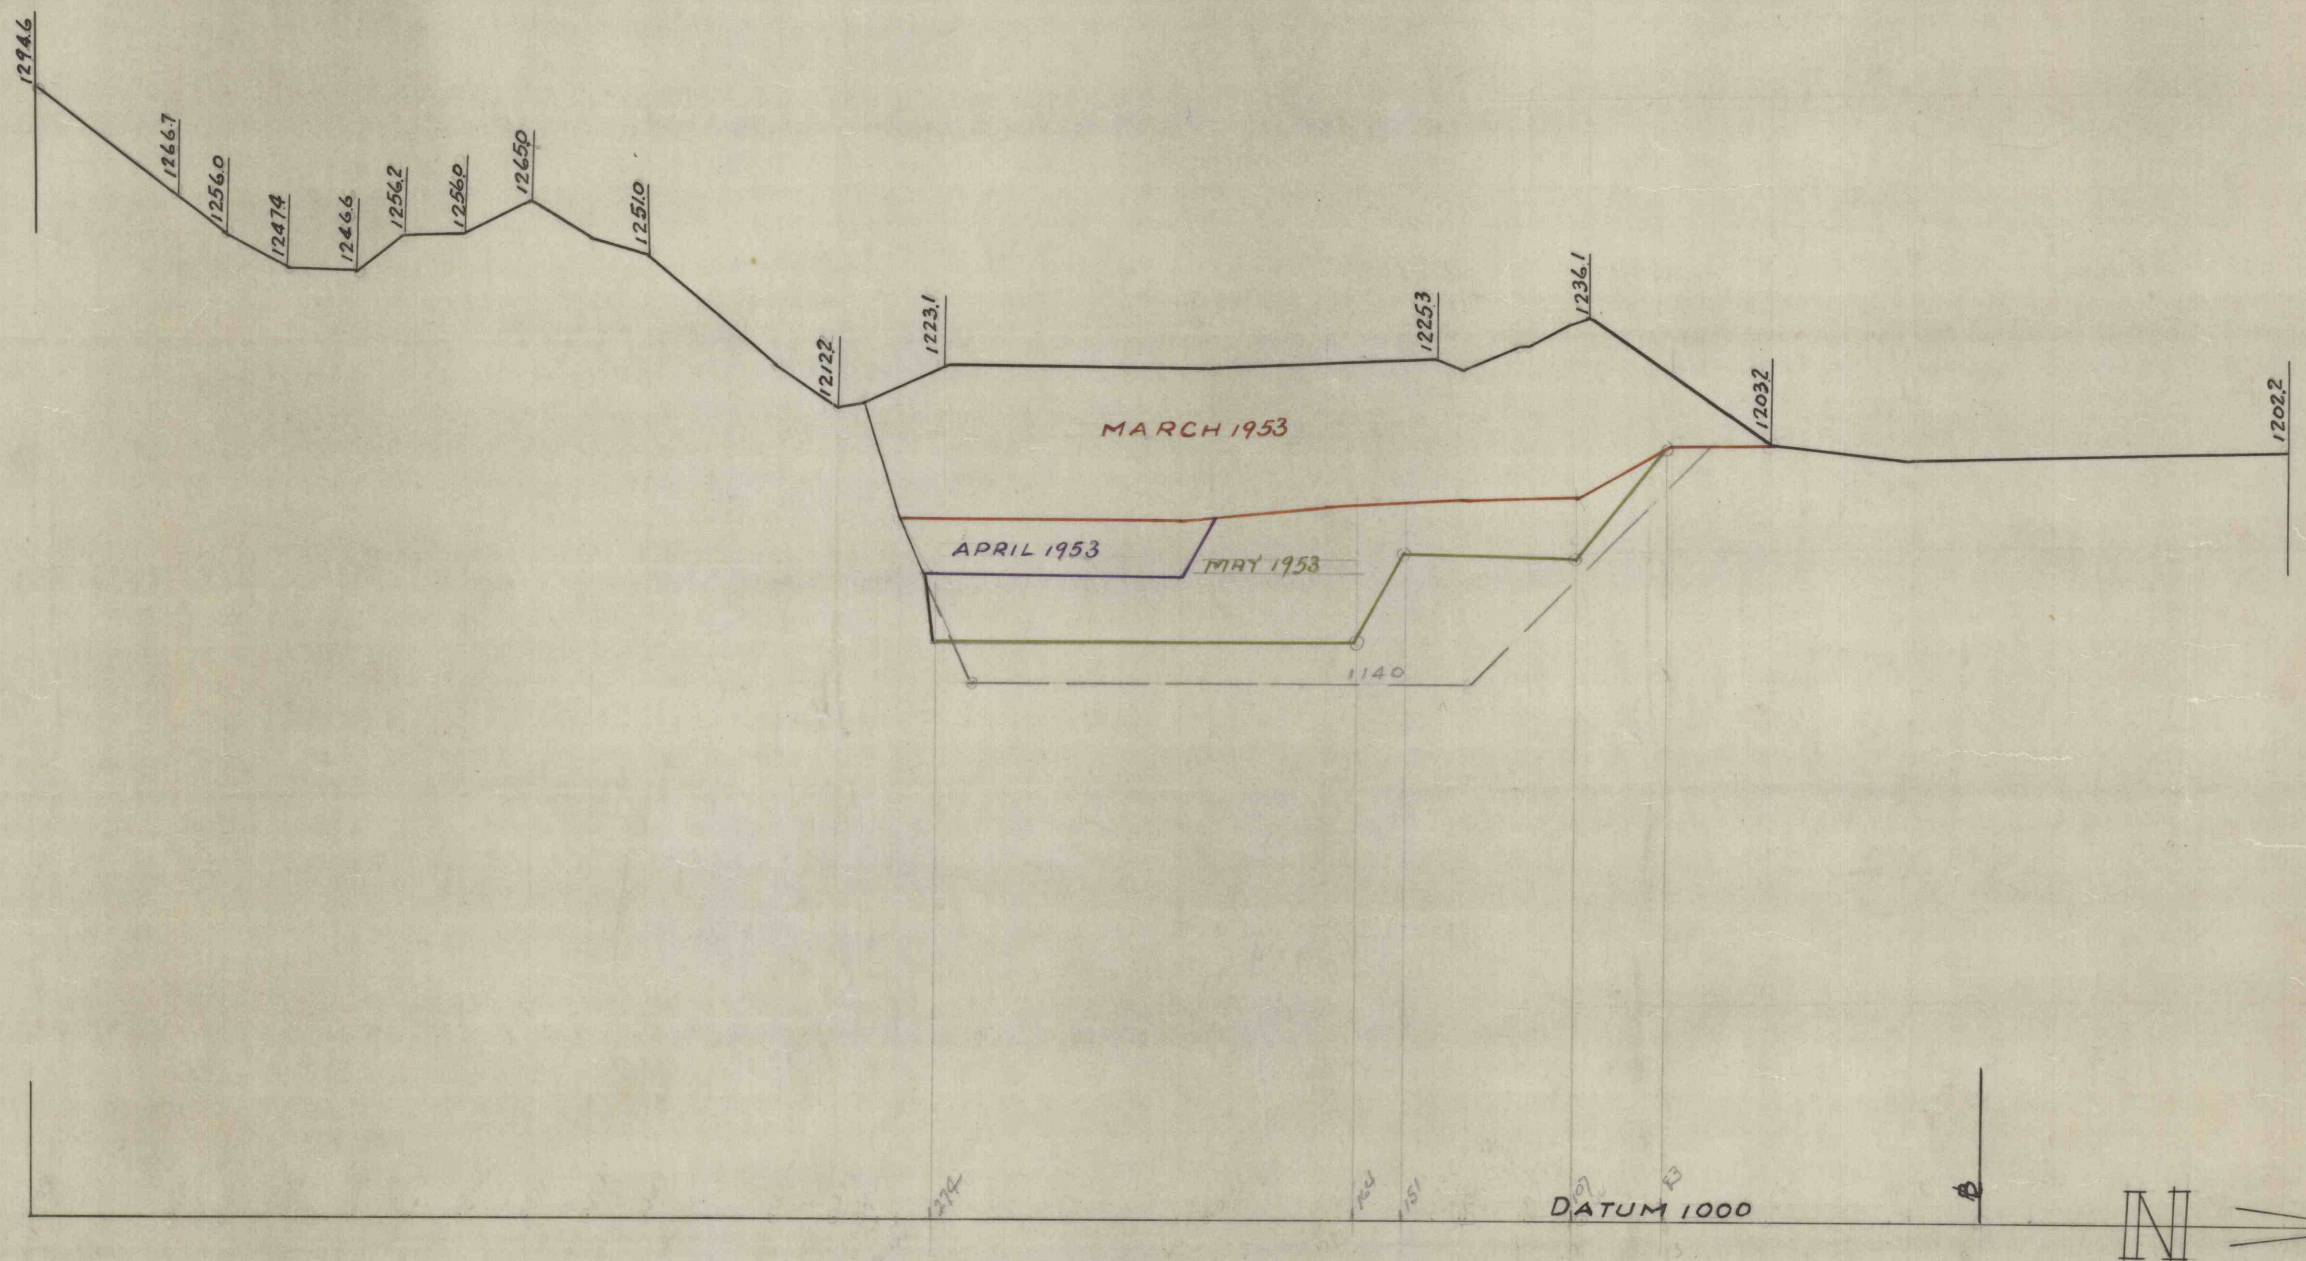

J. ROBERT BAZLEY, Inc.			
POTTSVILLE, PENNA.			
ASHTON SOUTH SIDE			
STRIPPING			
SECTION 11+00 WEST			
DATE	SCALE	BY	REVISION
5-26-53	1"=50'		

OPD-100-1000