


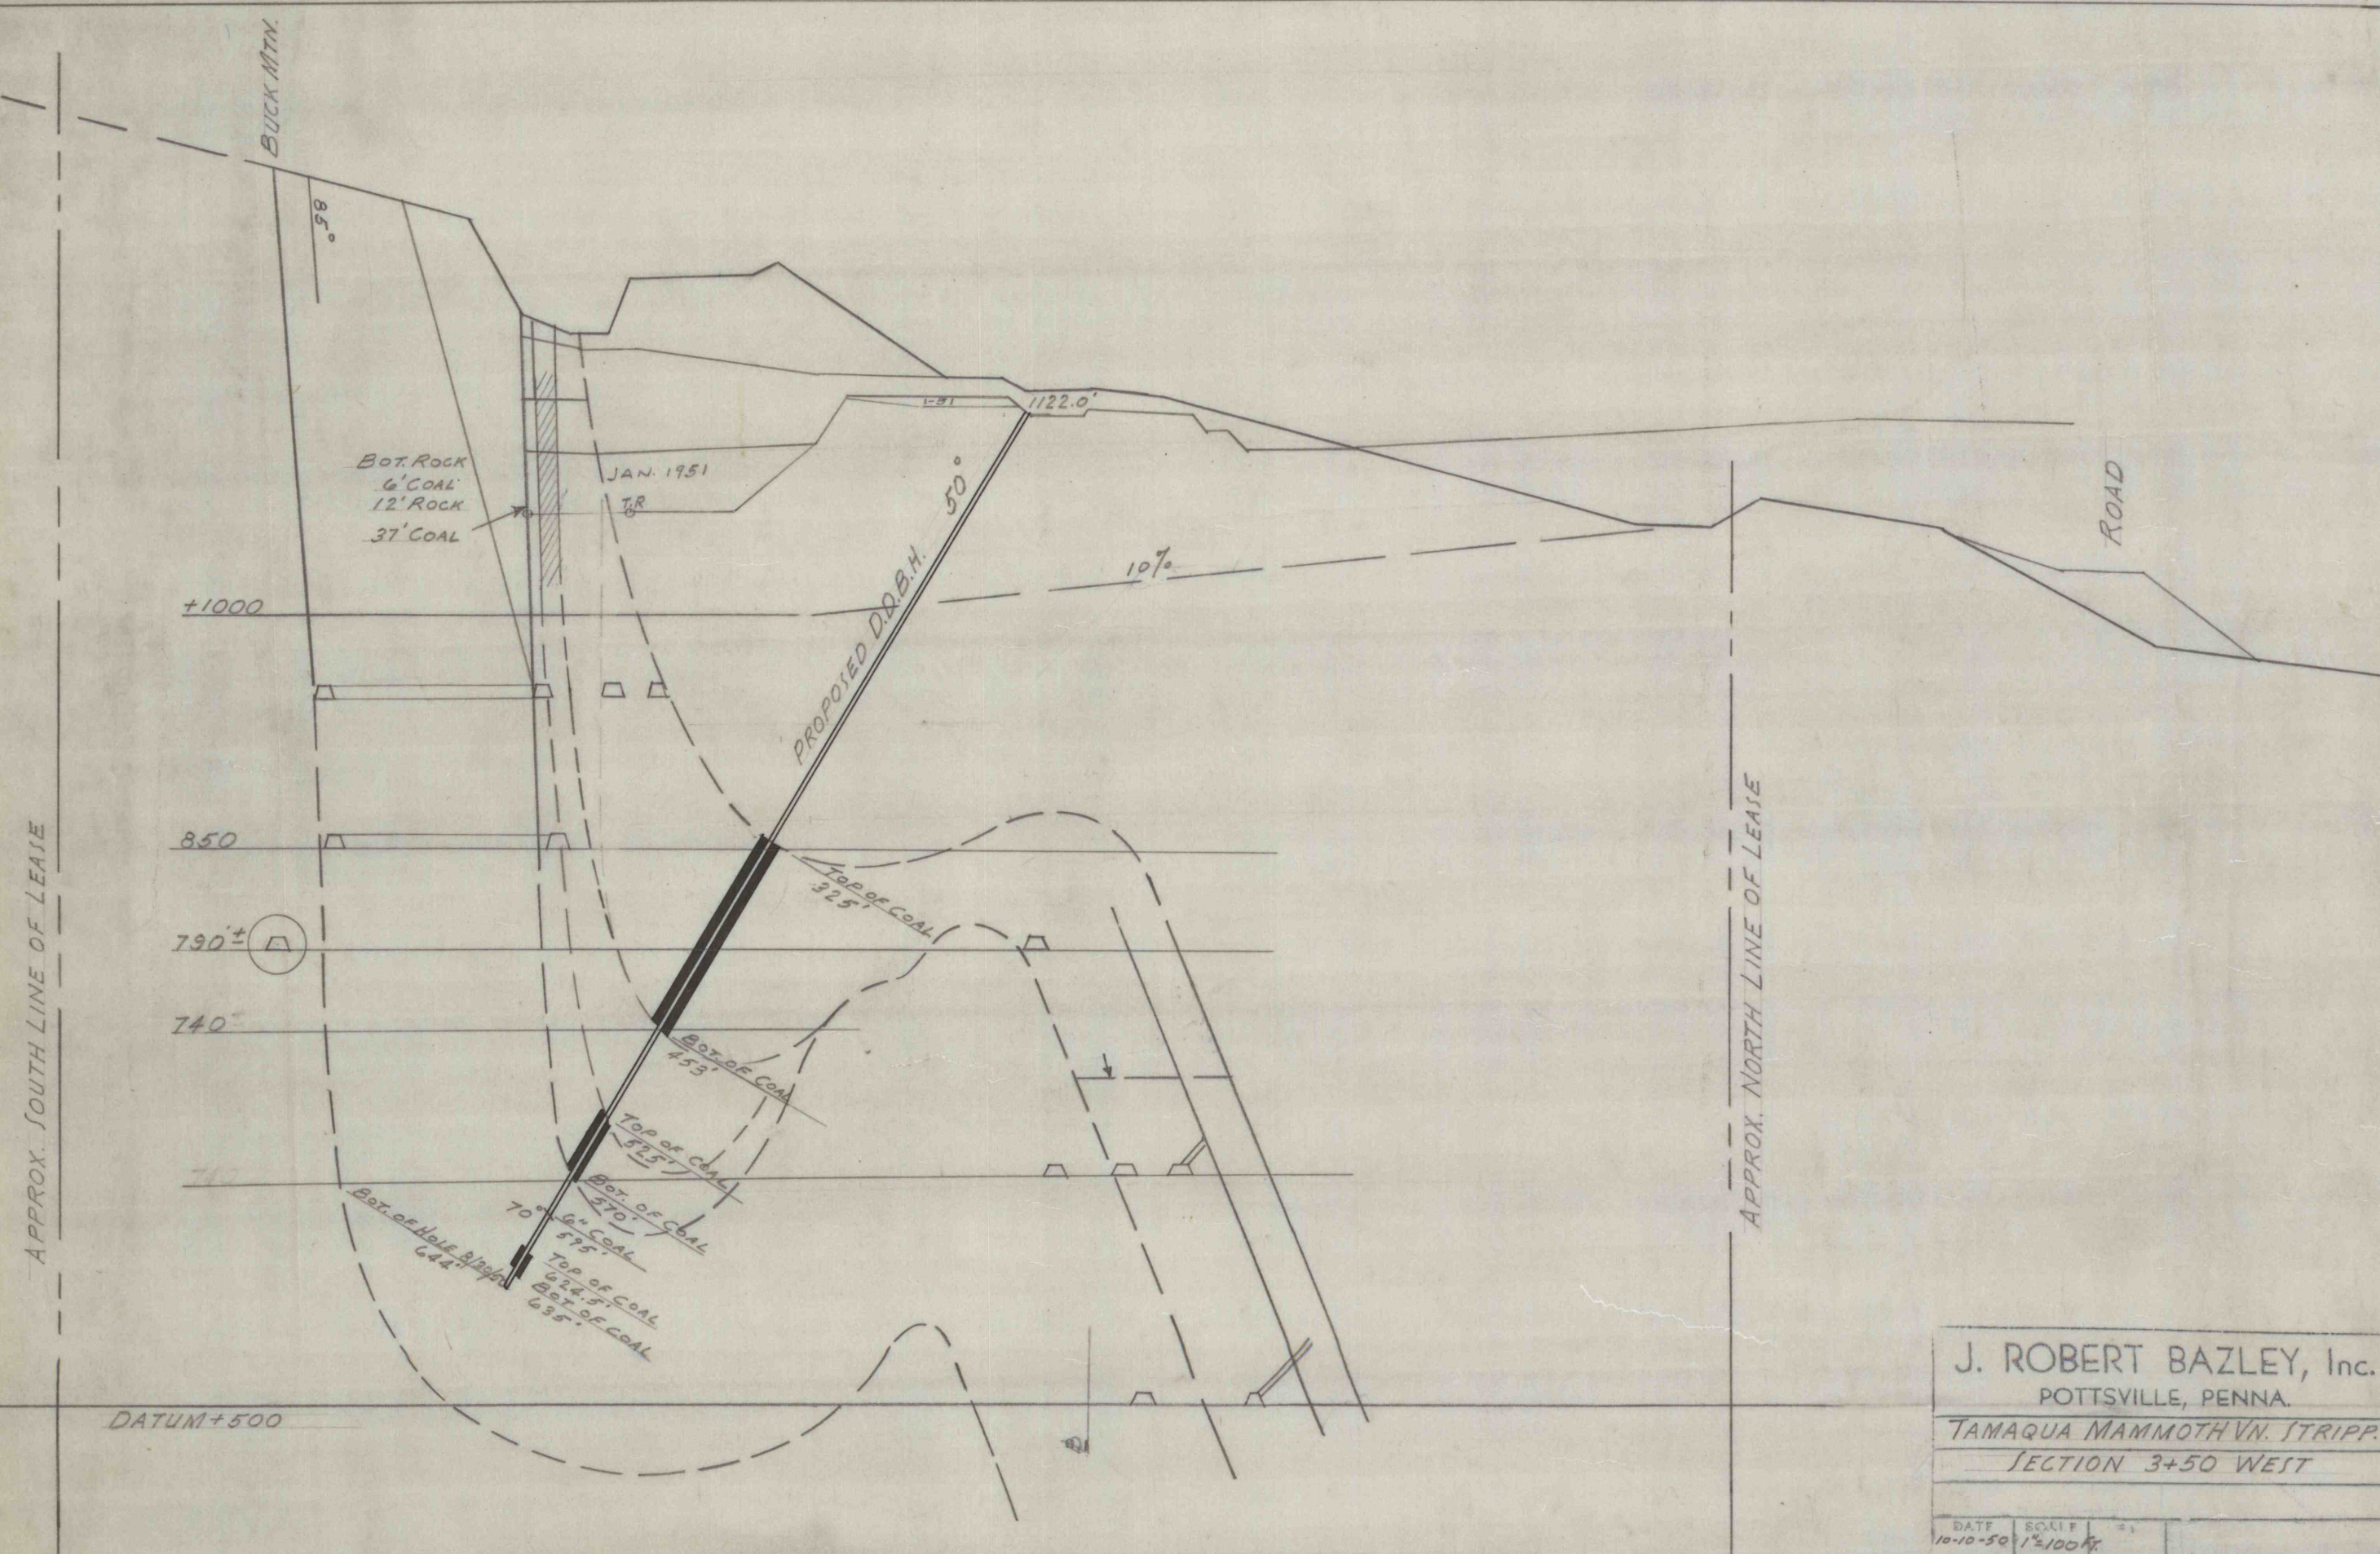

J. ROBERT BAZLEY, Inc.
POTTSVILLE, PENNA.
TAMAQUA MAMMOTH VN. STRIPP.
SECTION 3+50 WEST

DATE	SCALE
10-10-50	1"=100'