


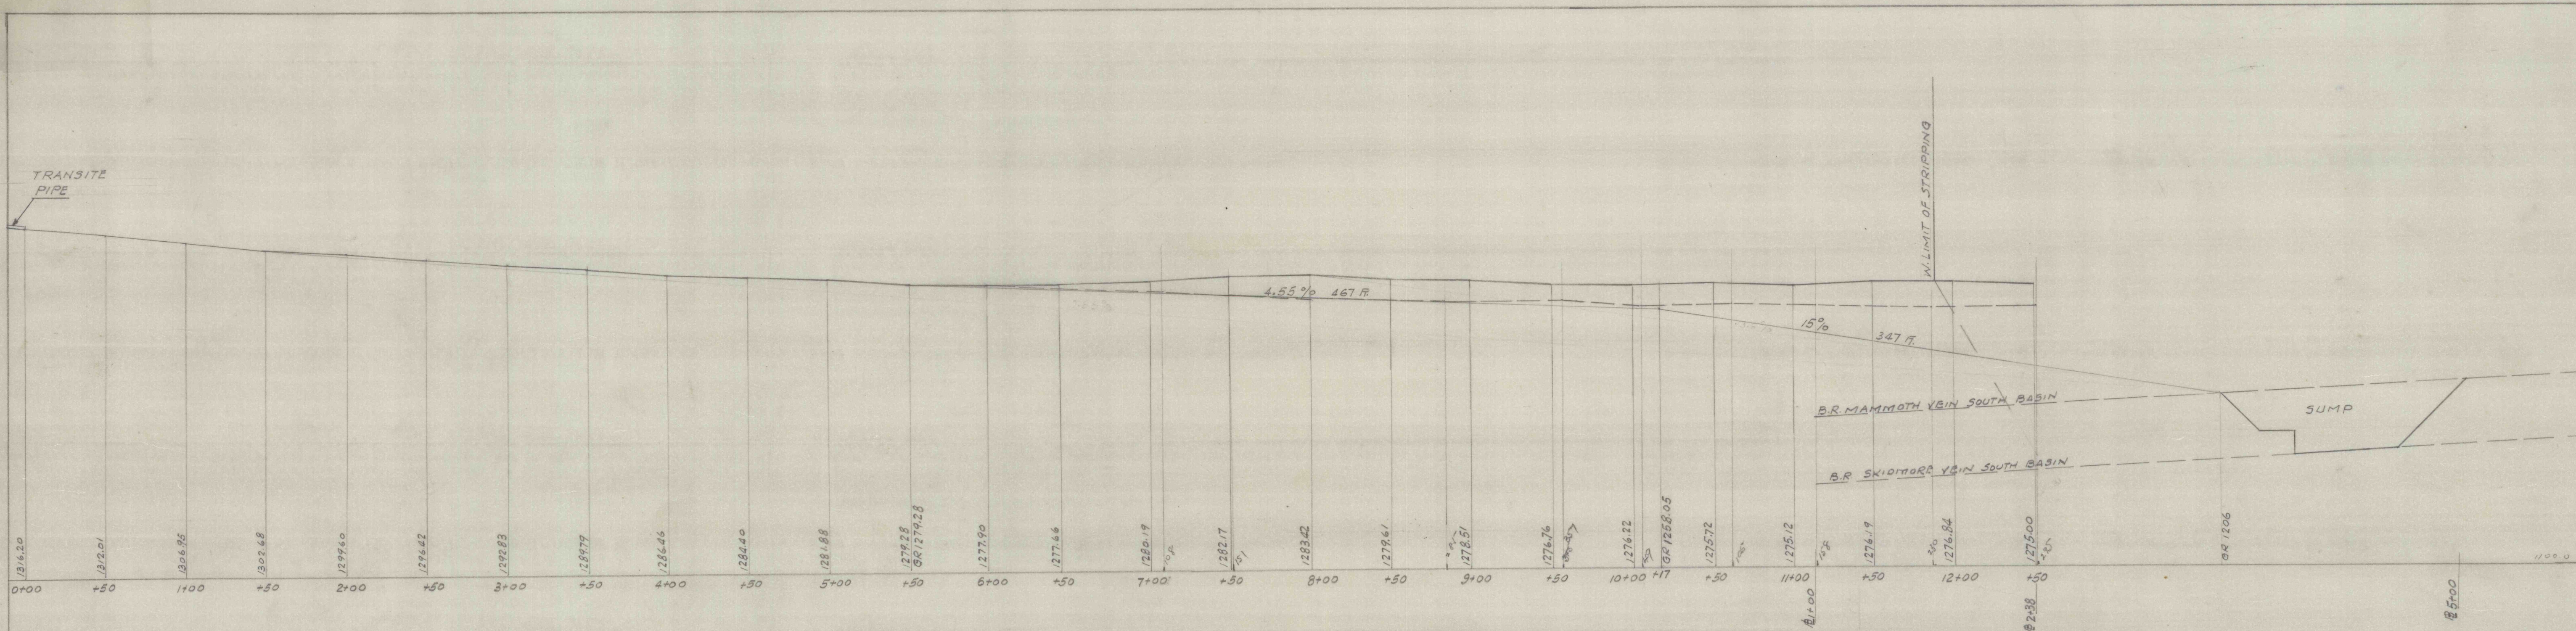

LOOKING NORTH

SEE REVISED DWG

MOREA STRIPPING
PROFILE FOR EXTENSION OF
24" TRANSITE COLUMN LINE
MAY 14, 1954
ENG. DEPT.
1 IN. = 50 FT.
J. ROBERT BAZLEY INC.
I-44A