


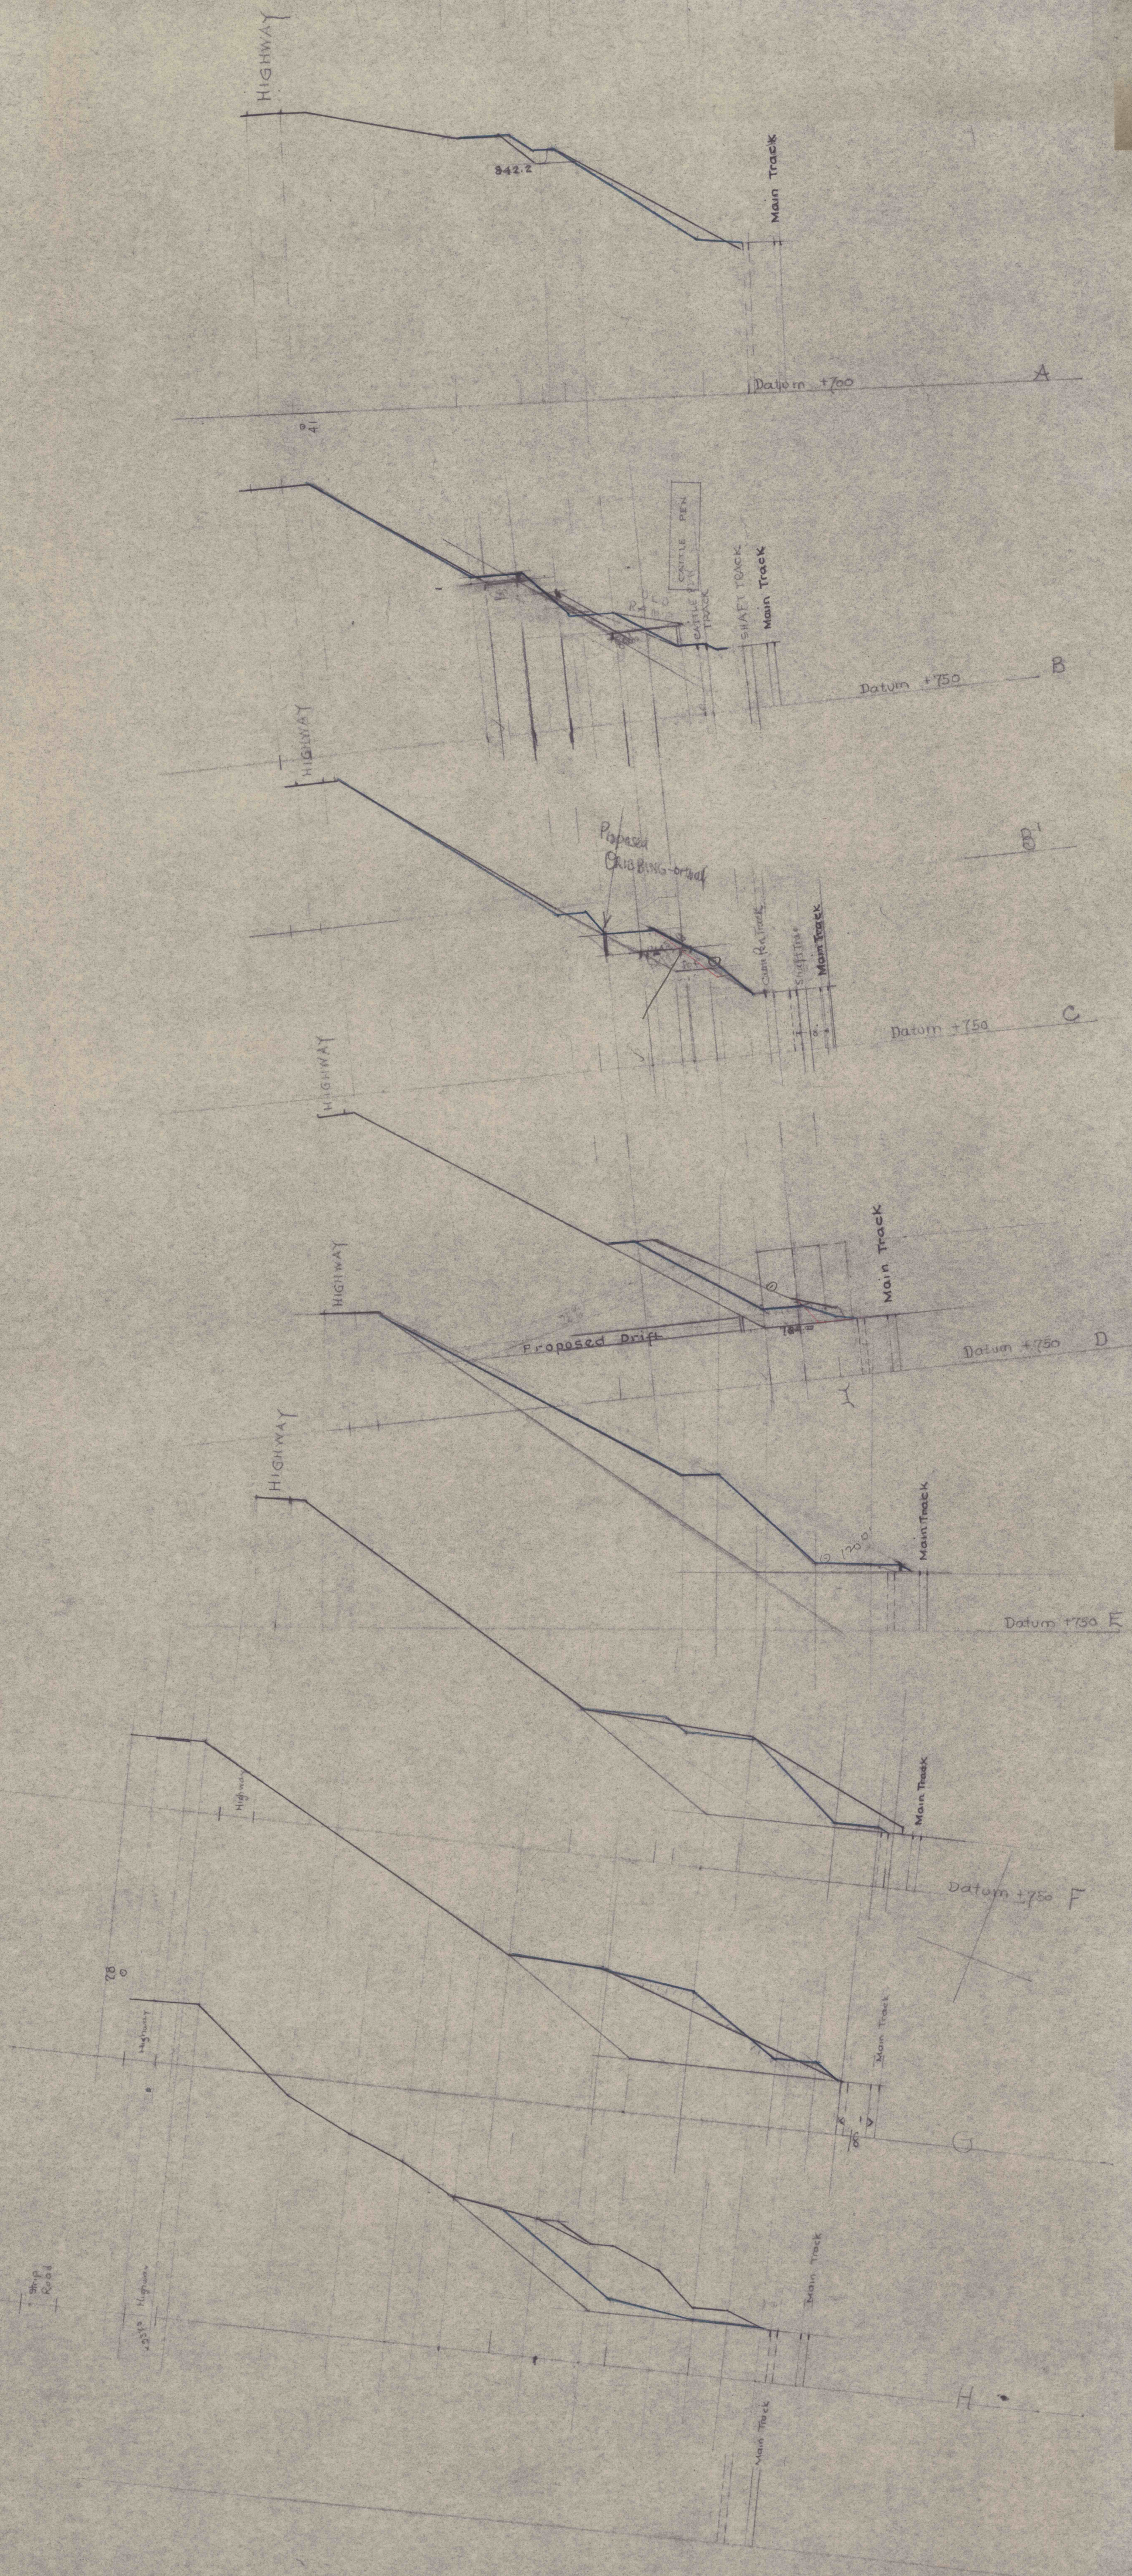

Scale 50' = 1"

Blue = Profile as of 11/13/50