


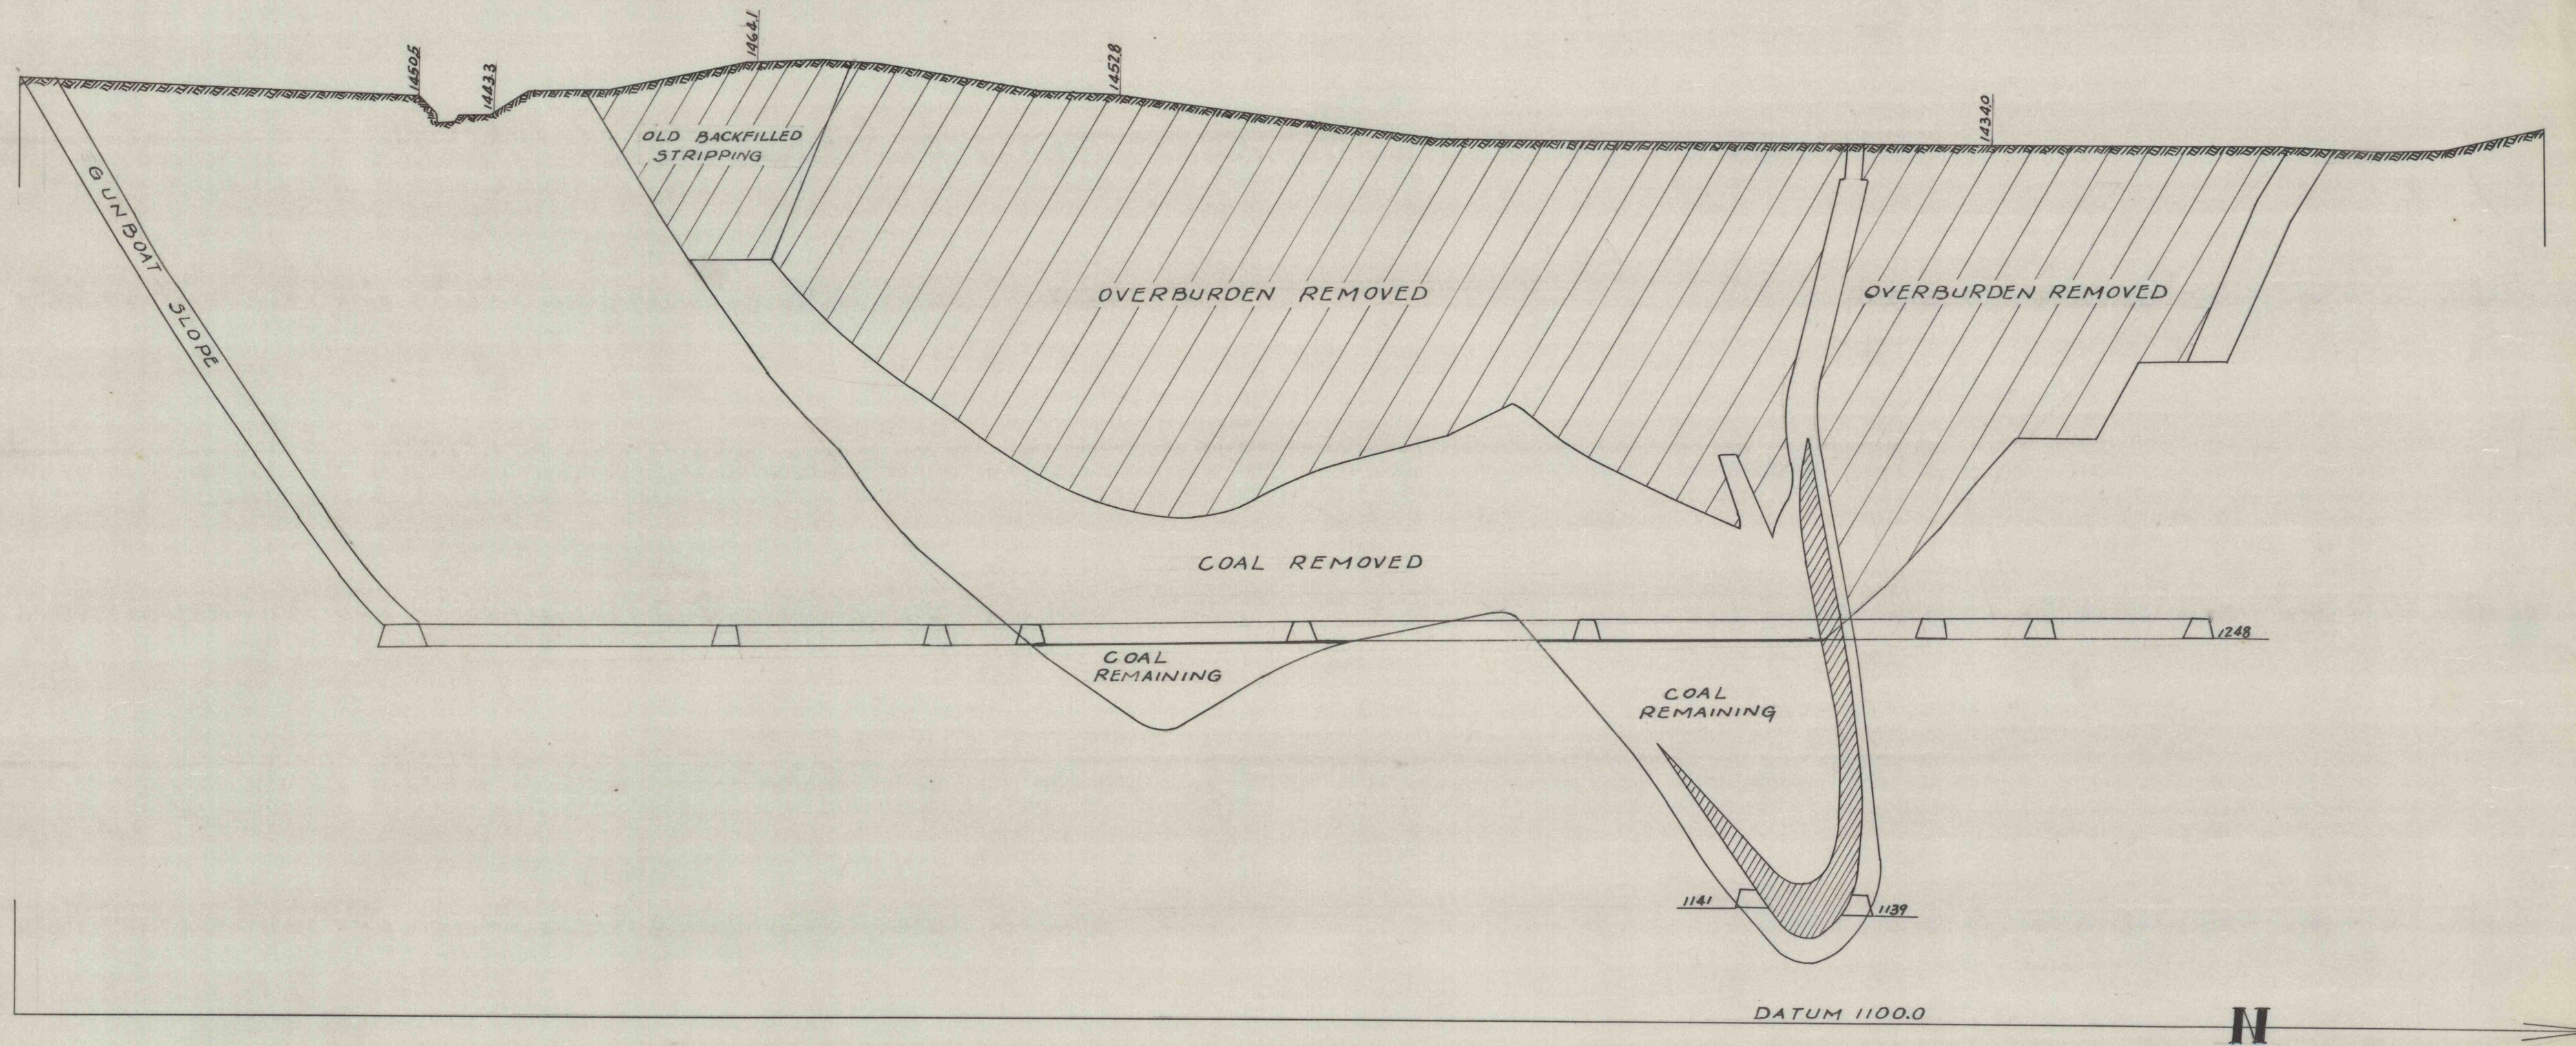

MOREA STRIPPING  
SECTION 7+00  
SCALE 1"=50' OCT. 1, 1954  
ENG. DEPT. J. ROBERT BAZLEY INC.