


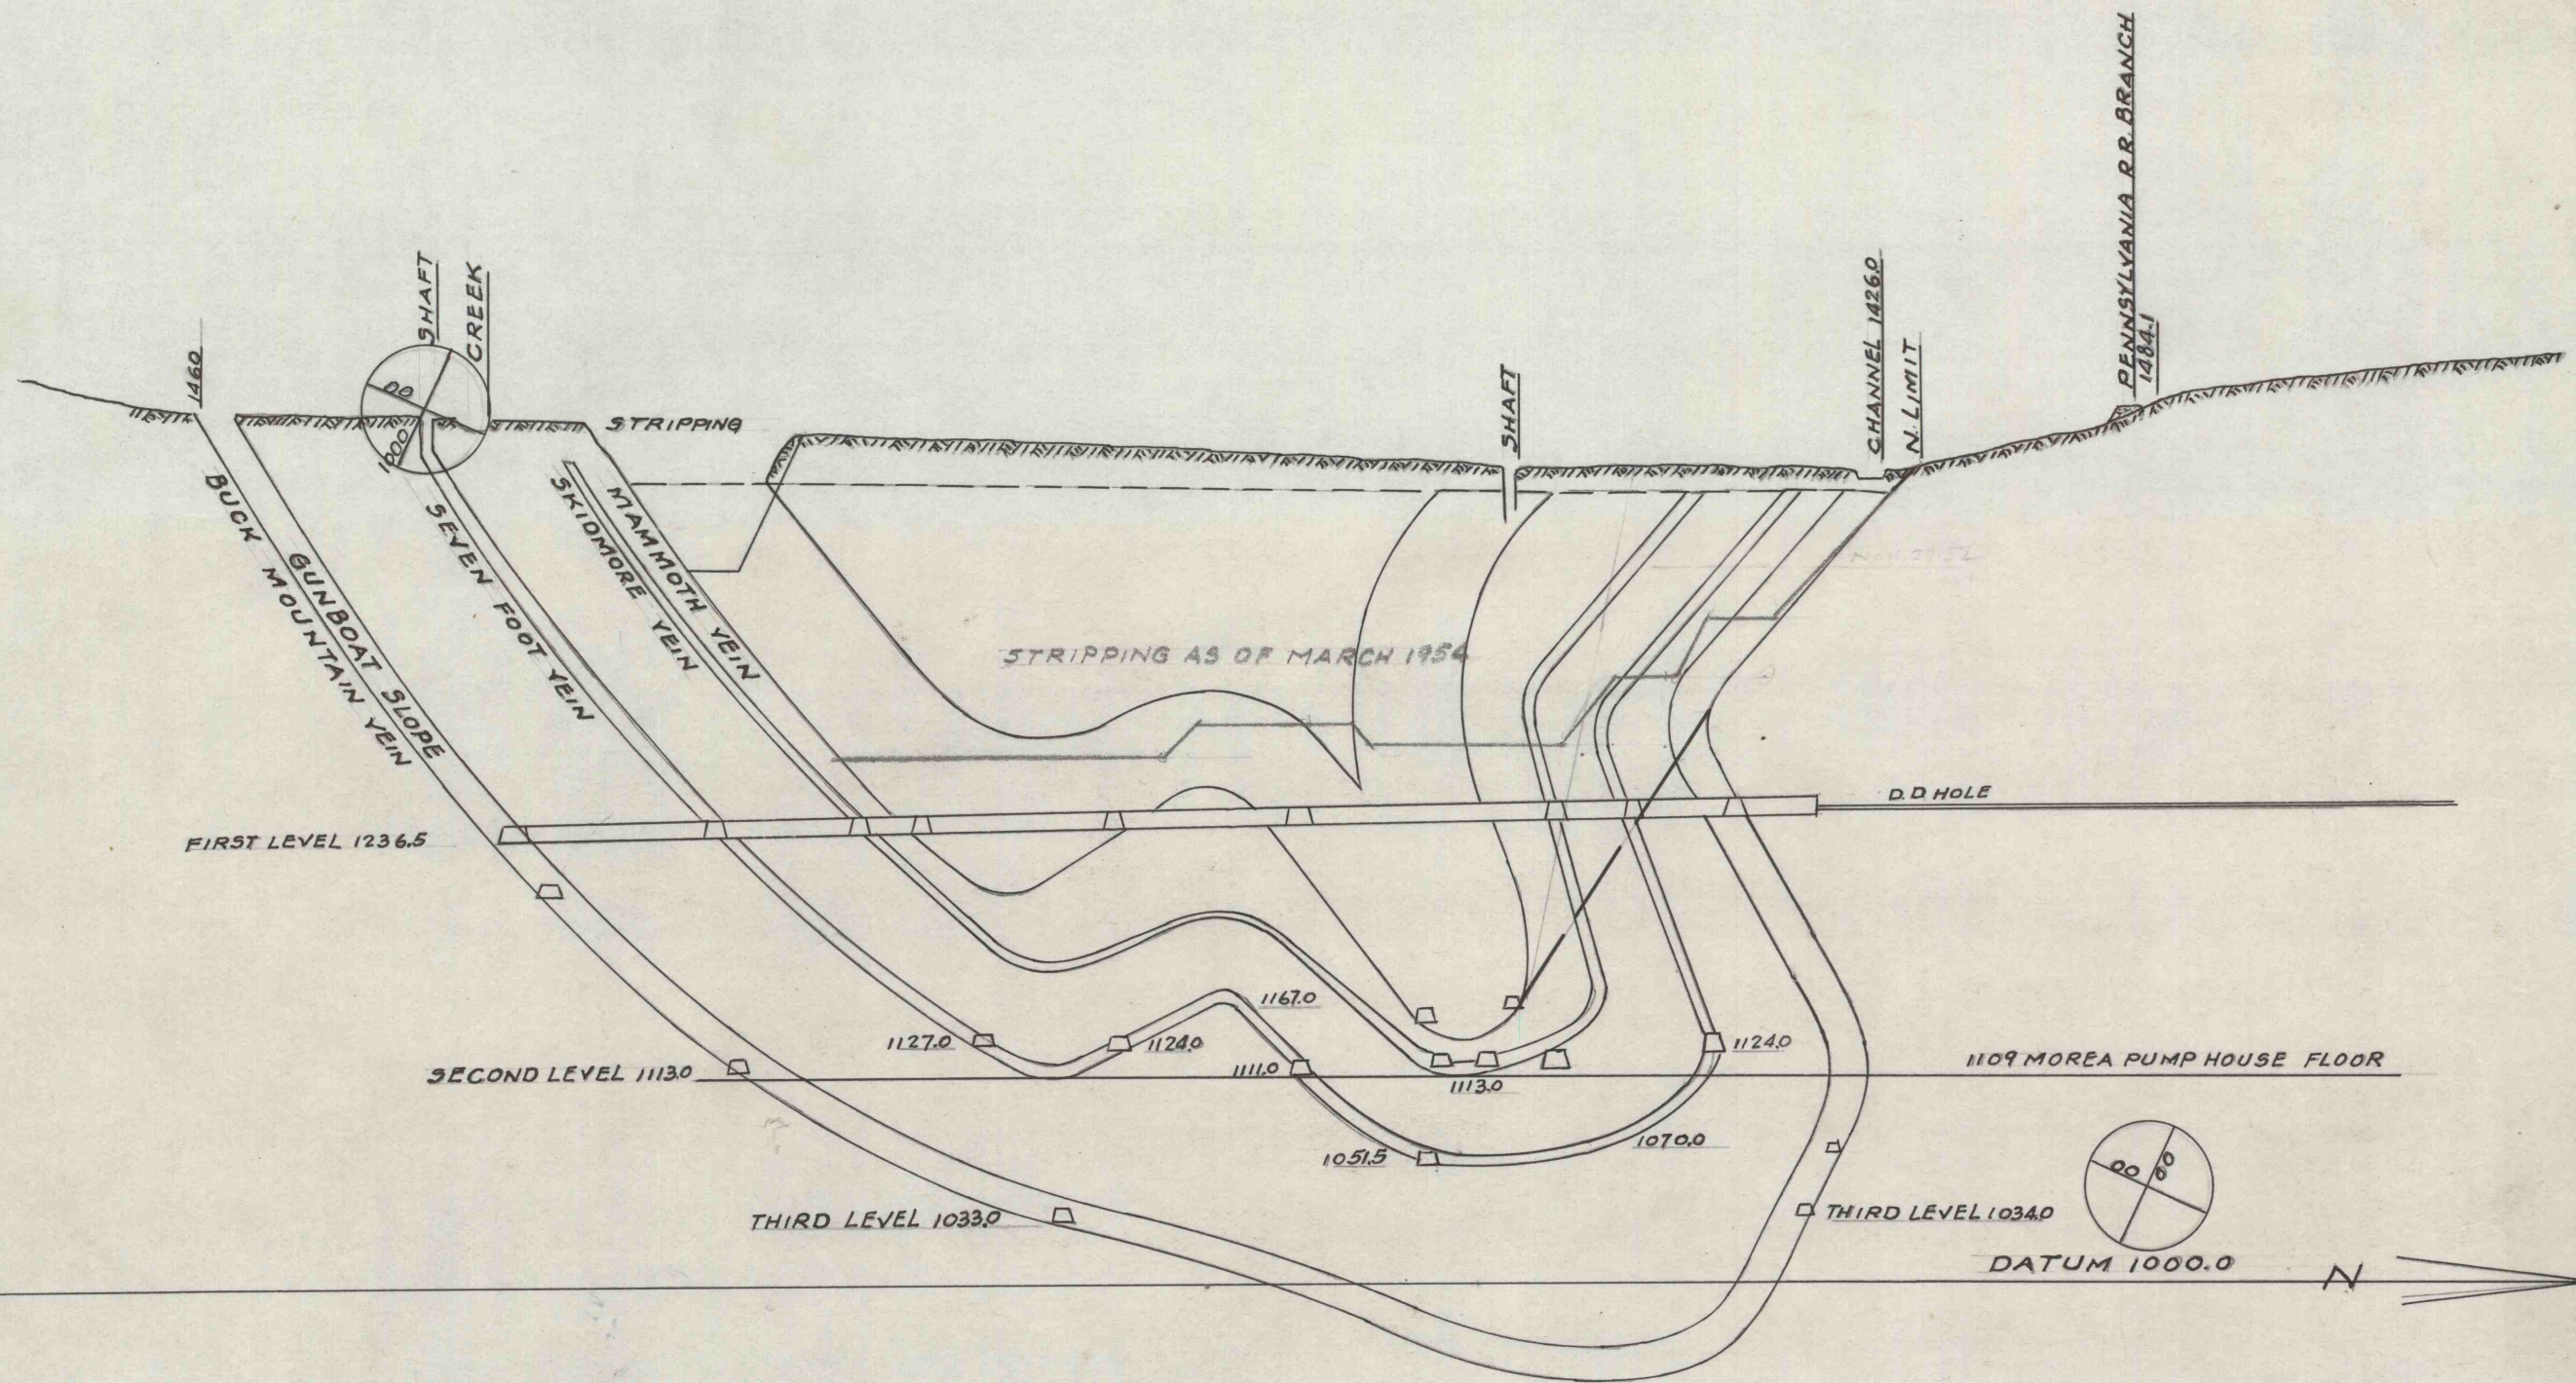

J. ROBERT BAZLEY, Inc.			
POTTSVILLE, PENNA.			
MOREA R.R. RESERVATION			
MAMMOTH VEIN STRIPP			
SECTION N ^o 18			
DATE	SCALE	BY	CHKD. NO.
7-11-49	1"=100'	M.K.	
COPIED FROM L.C.CO. DWG.			