


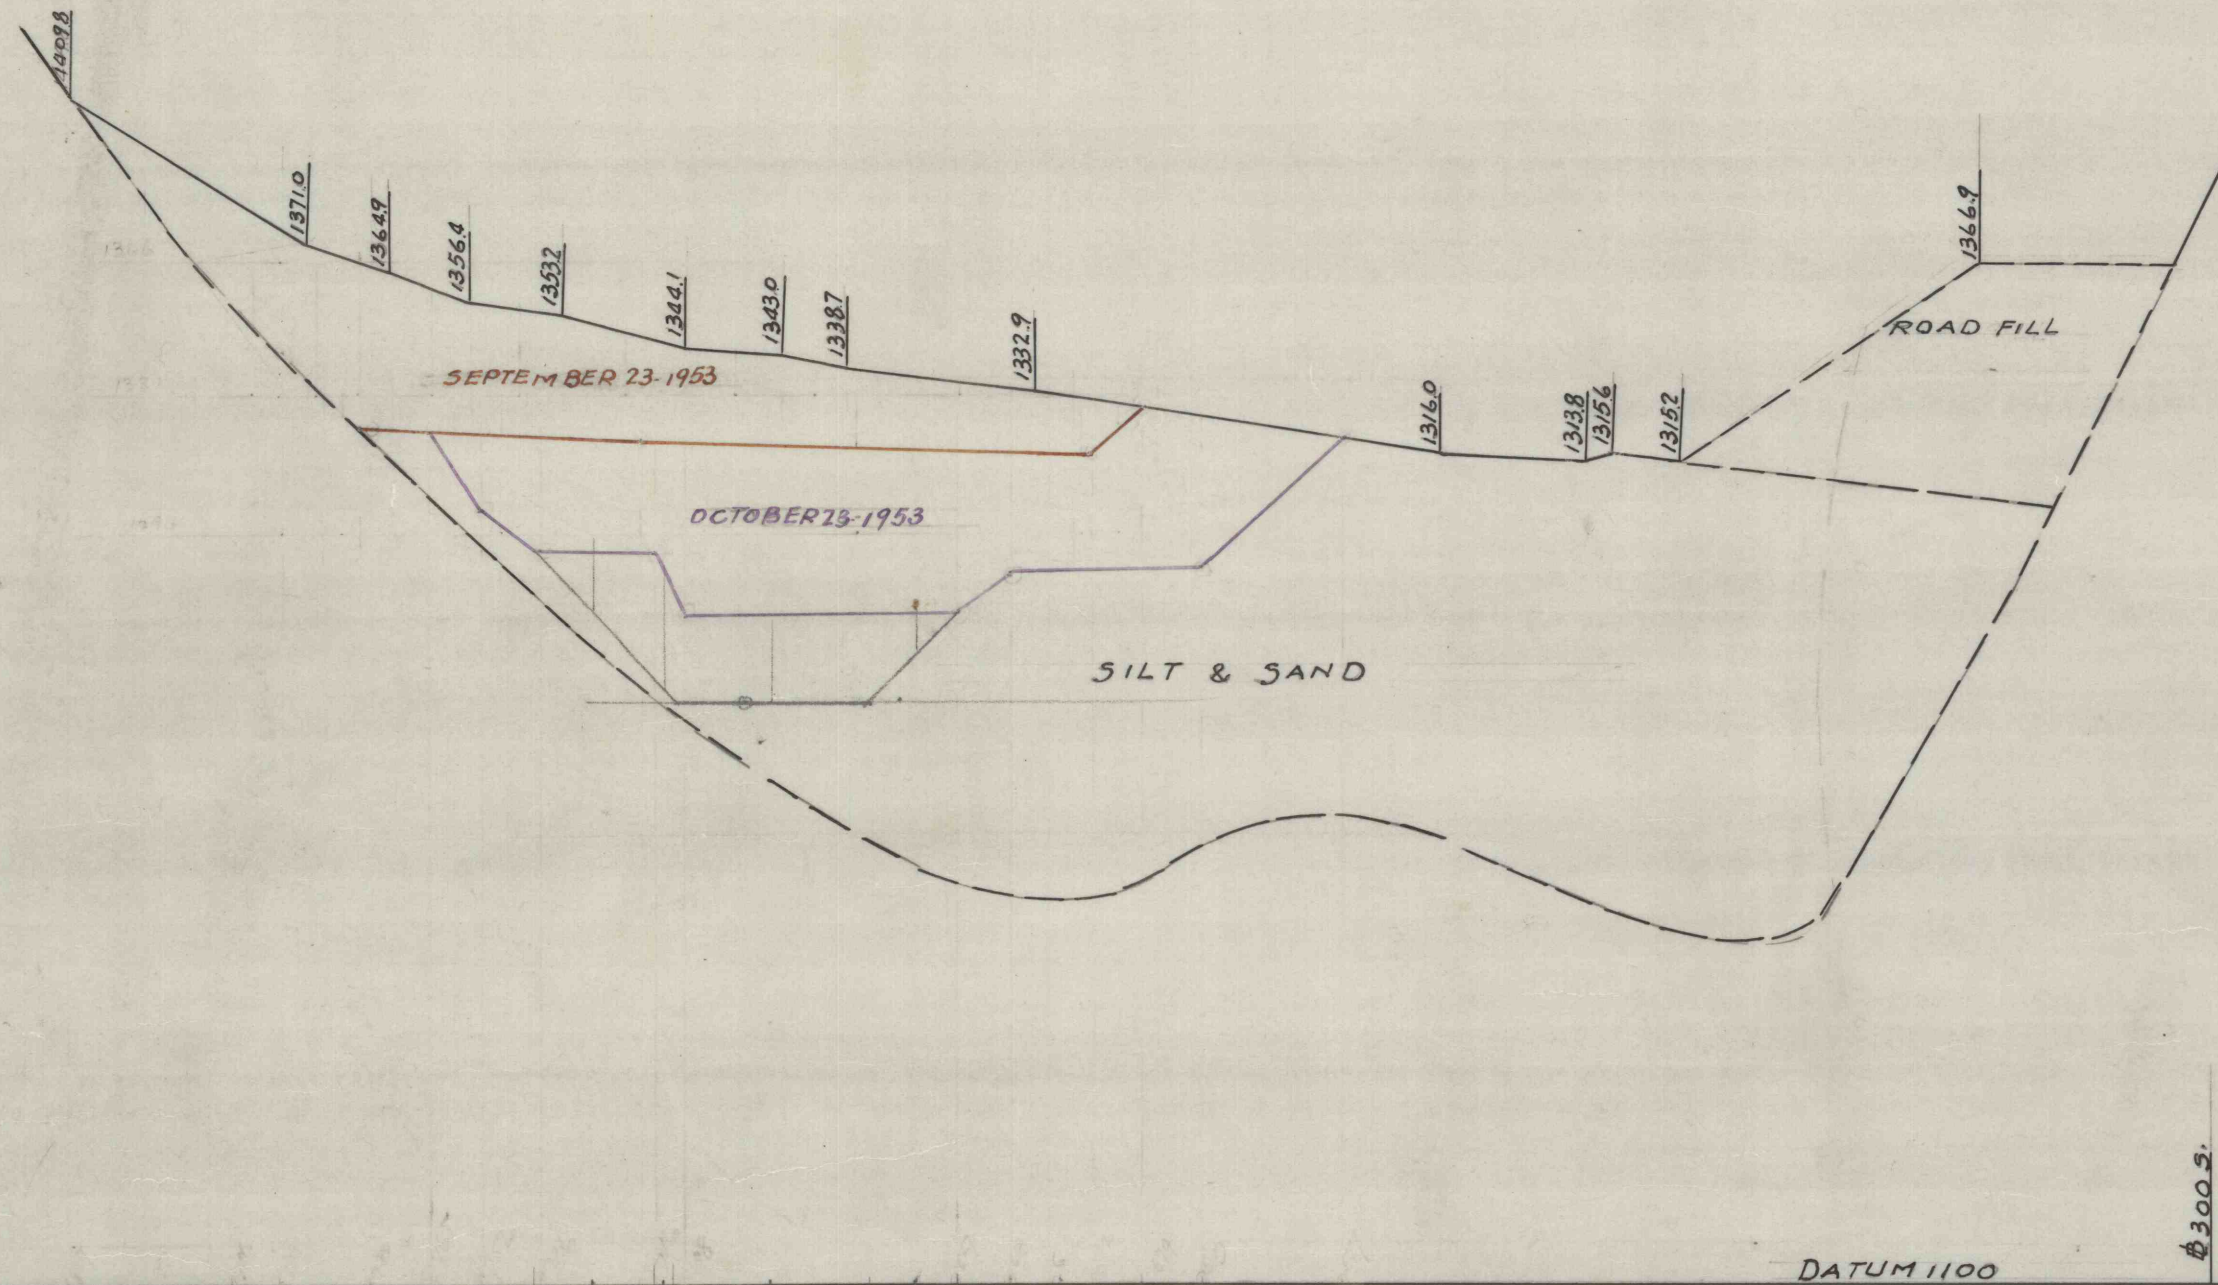

J. ROBERT BAZLEY, Inc.			
POTTSVILLE, PENNA.			
MOREA STRIPPING			
SECTION 0+00			
DATE	SCALE	BY	DATE
5-8-53	1"=50'		J-53