


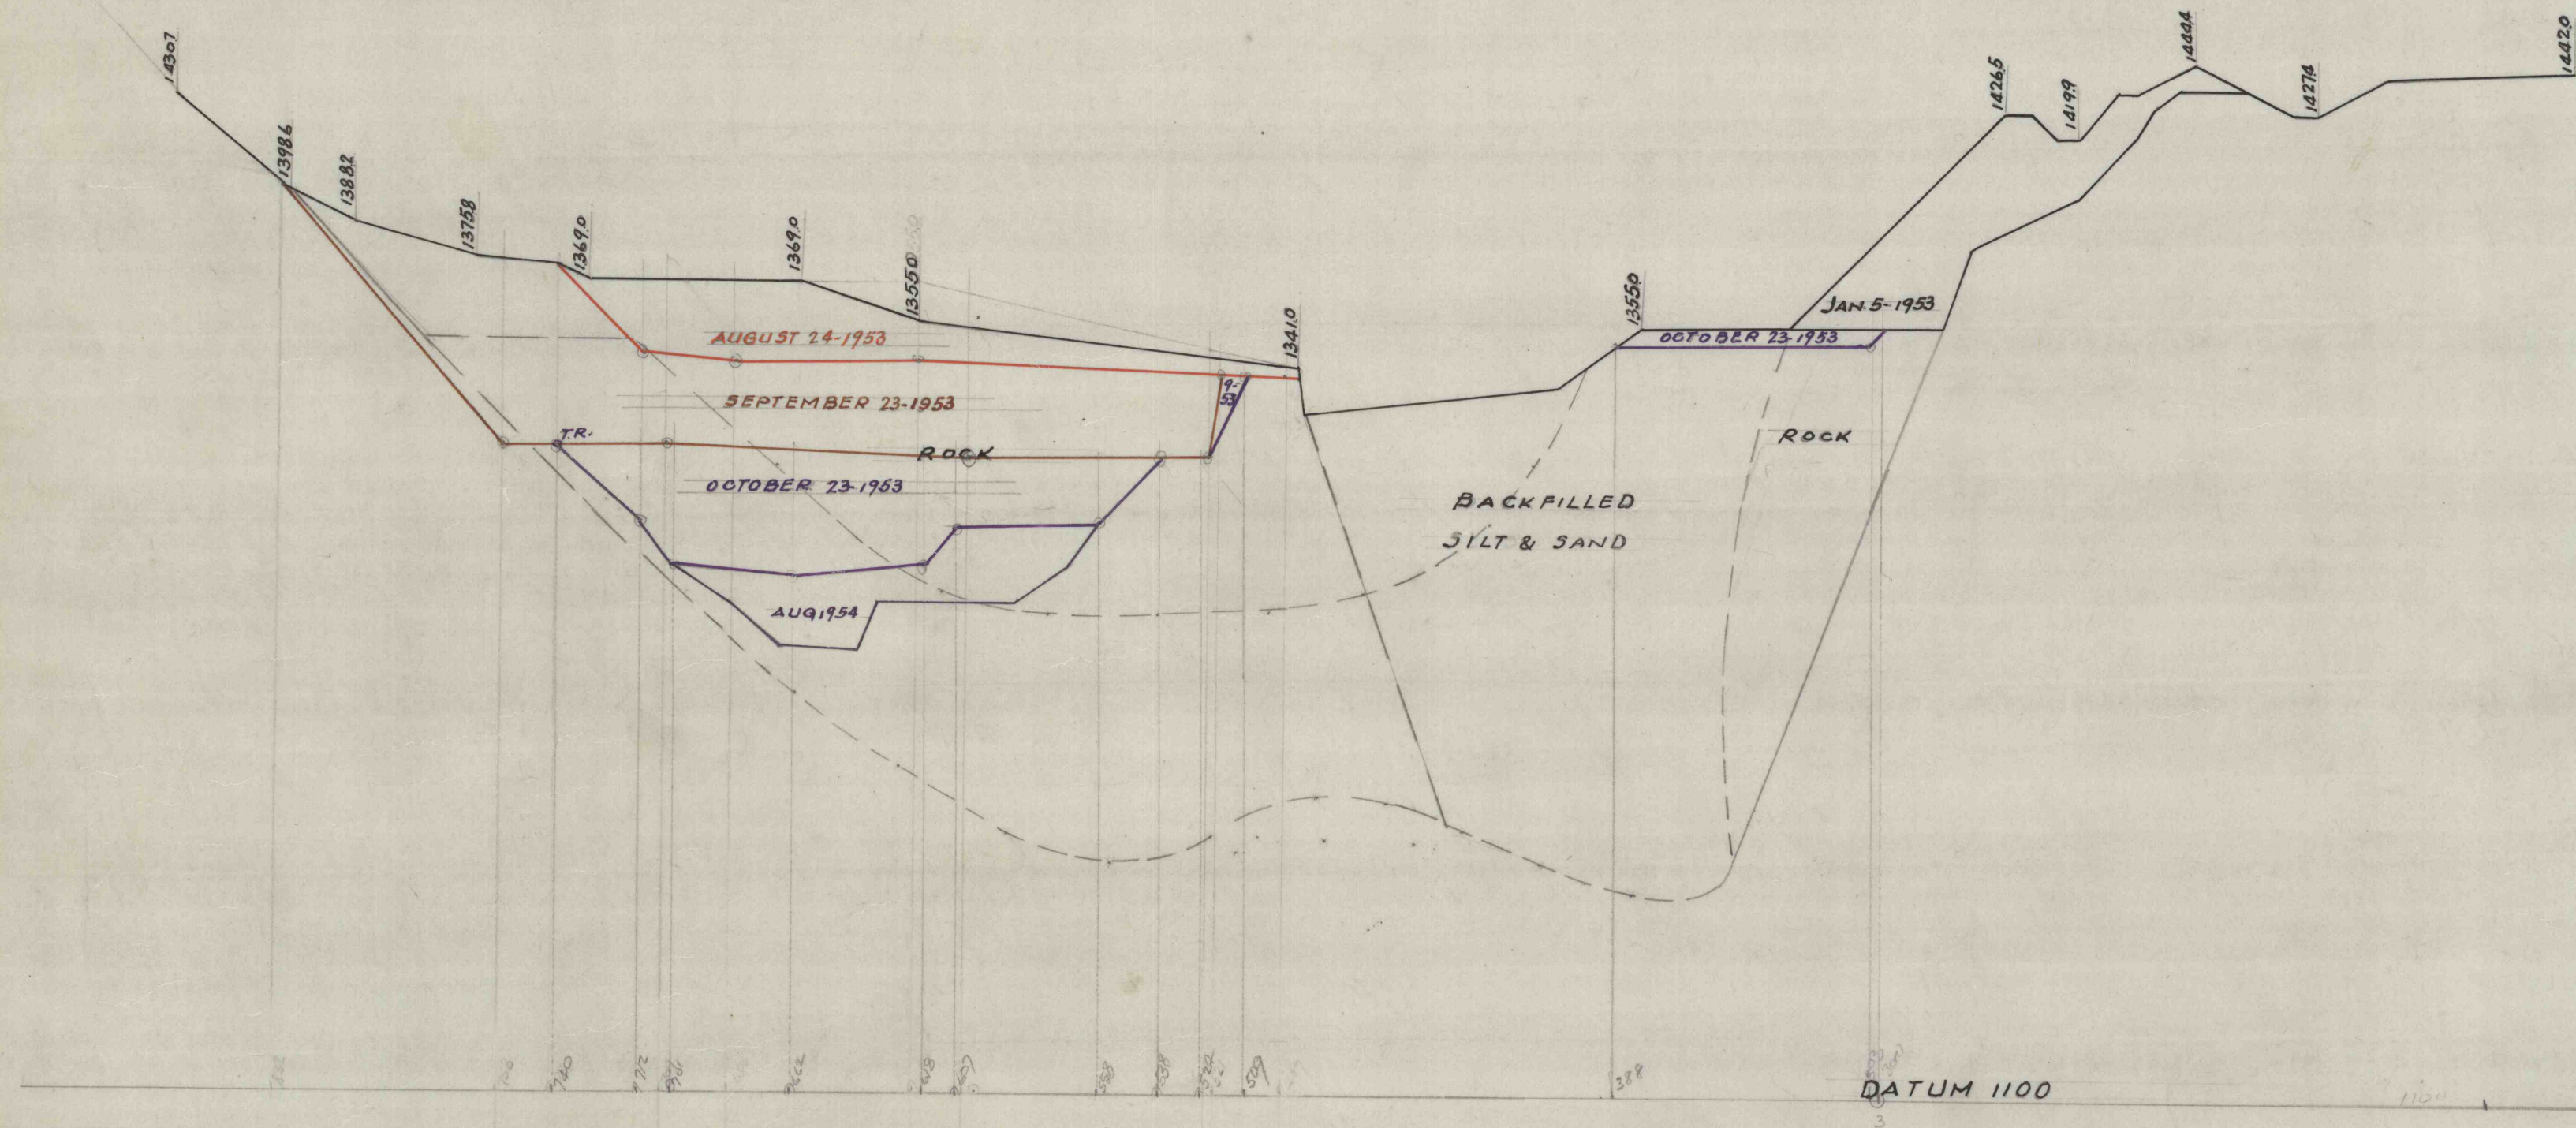

J. ROBERT BAZLEY, Inc.
POTTSVILLE, PENNA.

MOREA STRIPPING
SECTION 1400 EAST

DATE	SCALE	BY	REVISION
5-8-53	1"=50'		J-53