


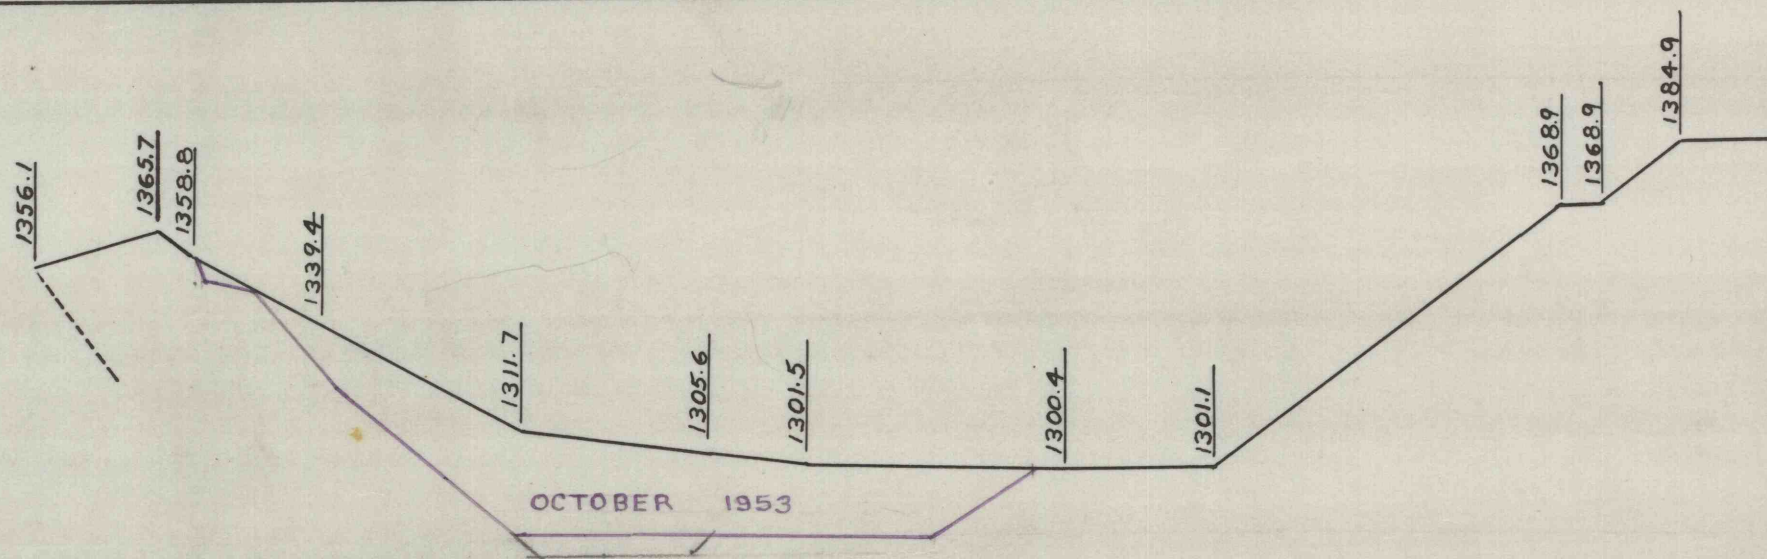

J. ROBERT BAZLEY, Inc.
POTTSVILLE, PENNA.
MOREA STRIPPING
SECTION 2+00WEST

DATE	SCALE	BY
11-19-53	1"=50'	J-53