


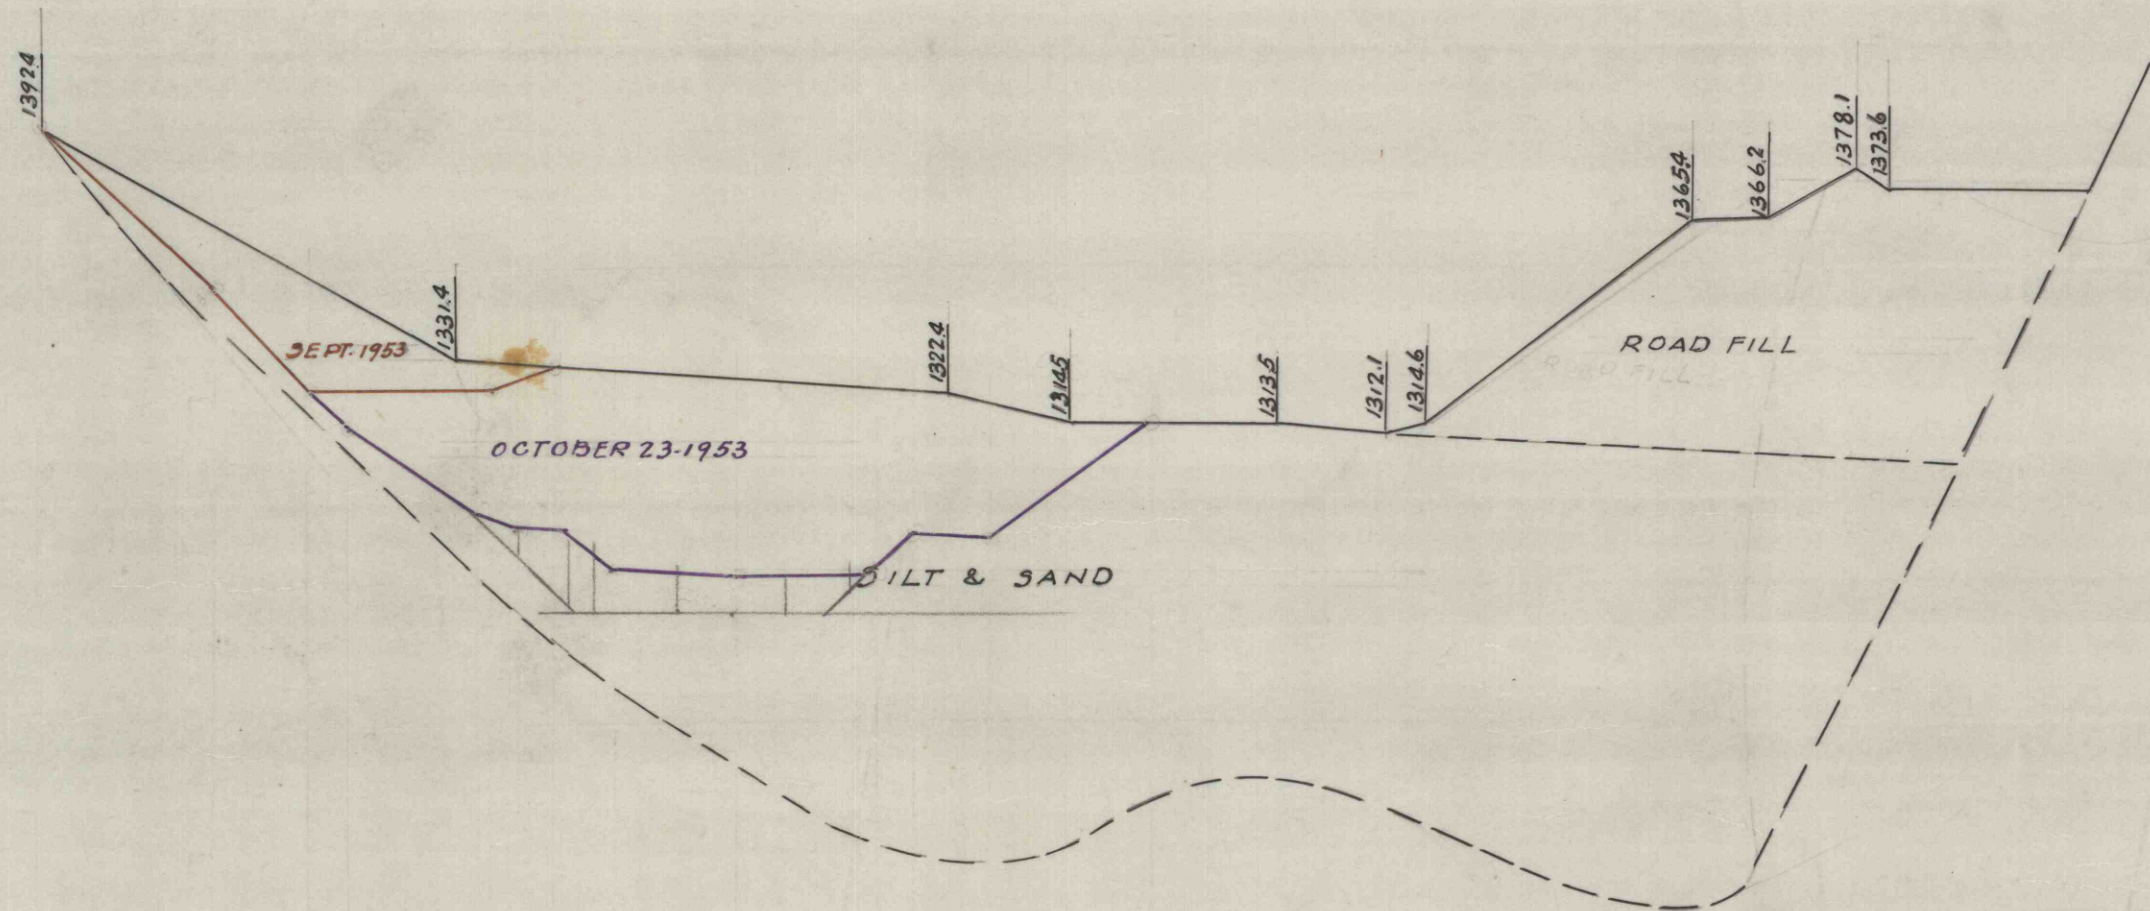

DATUM 1100

±300.9

N

J. ROBERT BAZLEY, Inc.			
POTTSVILLE, PENNA.			
MOREA STRIPPING			
SECTION 1+00 WEST			
DATE	SCALE	BY	REVISION
5-8-53	1"=50'		J-53