


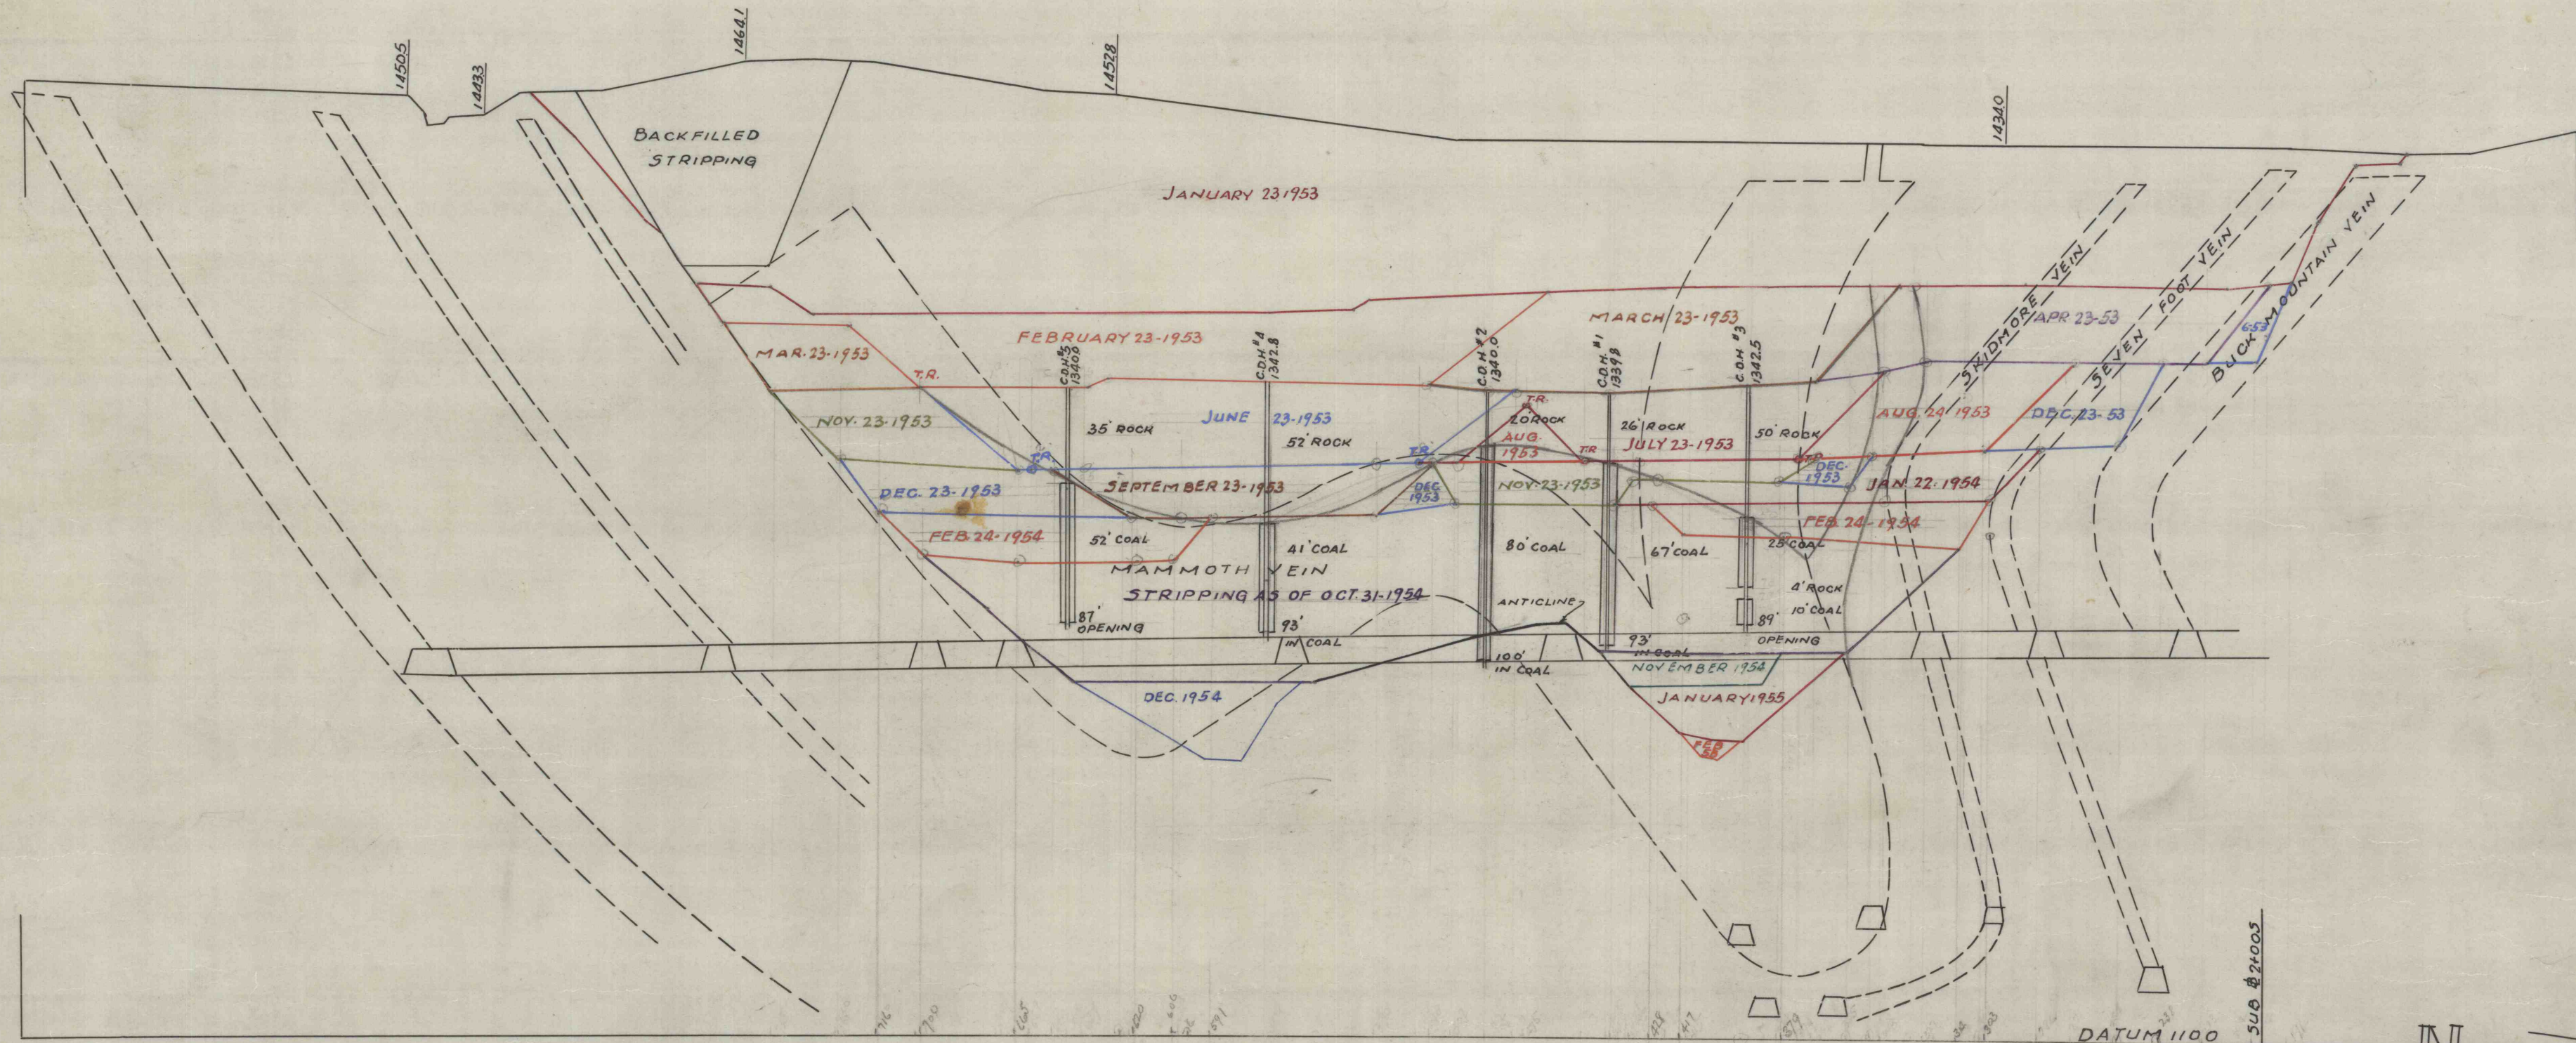

N

COPIED FROM L.C.C.O.

J. ROBERT BAZLEY, Inc.
POTTSVILLE, PENNA.

WESTON COLLIERY
MOREA STRIPPING
SECTION 7+00 EAST

DATE 1-53	SCALE 1"=50'	BY J.R.B.	144-A
--------------	-----------------	--------------	-------