



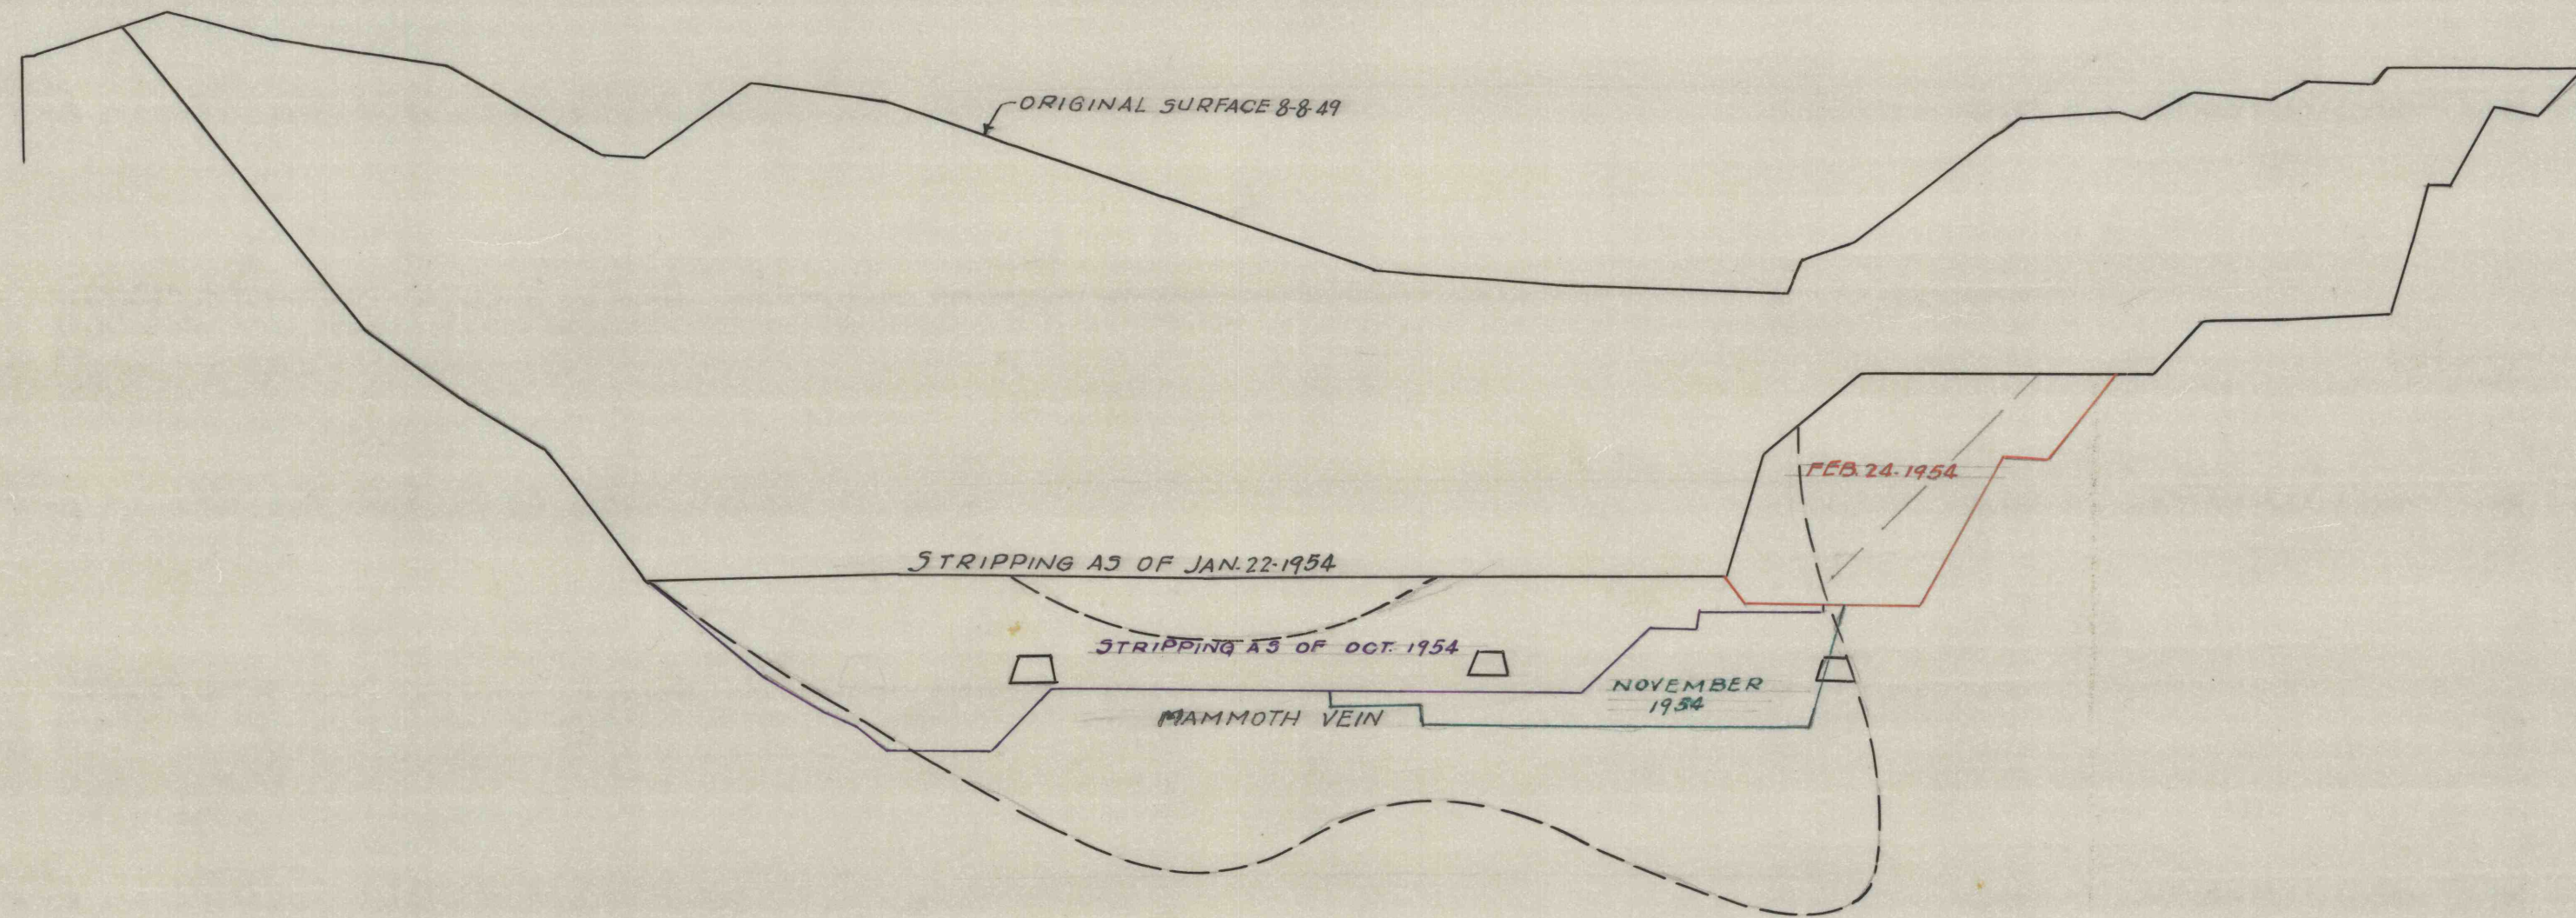

DATUM 1100

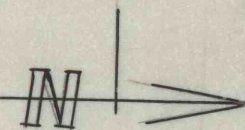

J. ROBERT BAZLEY, Inc.
POTTSVILLE, PENNA.
WESTON COAL CO.
MOREA STRIPPING
SECTION 2+00 EAST
DATE 2-19-54 SCALE 1"=50' BY I44A