


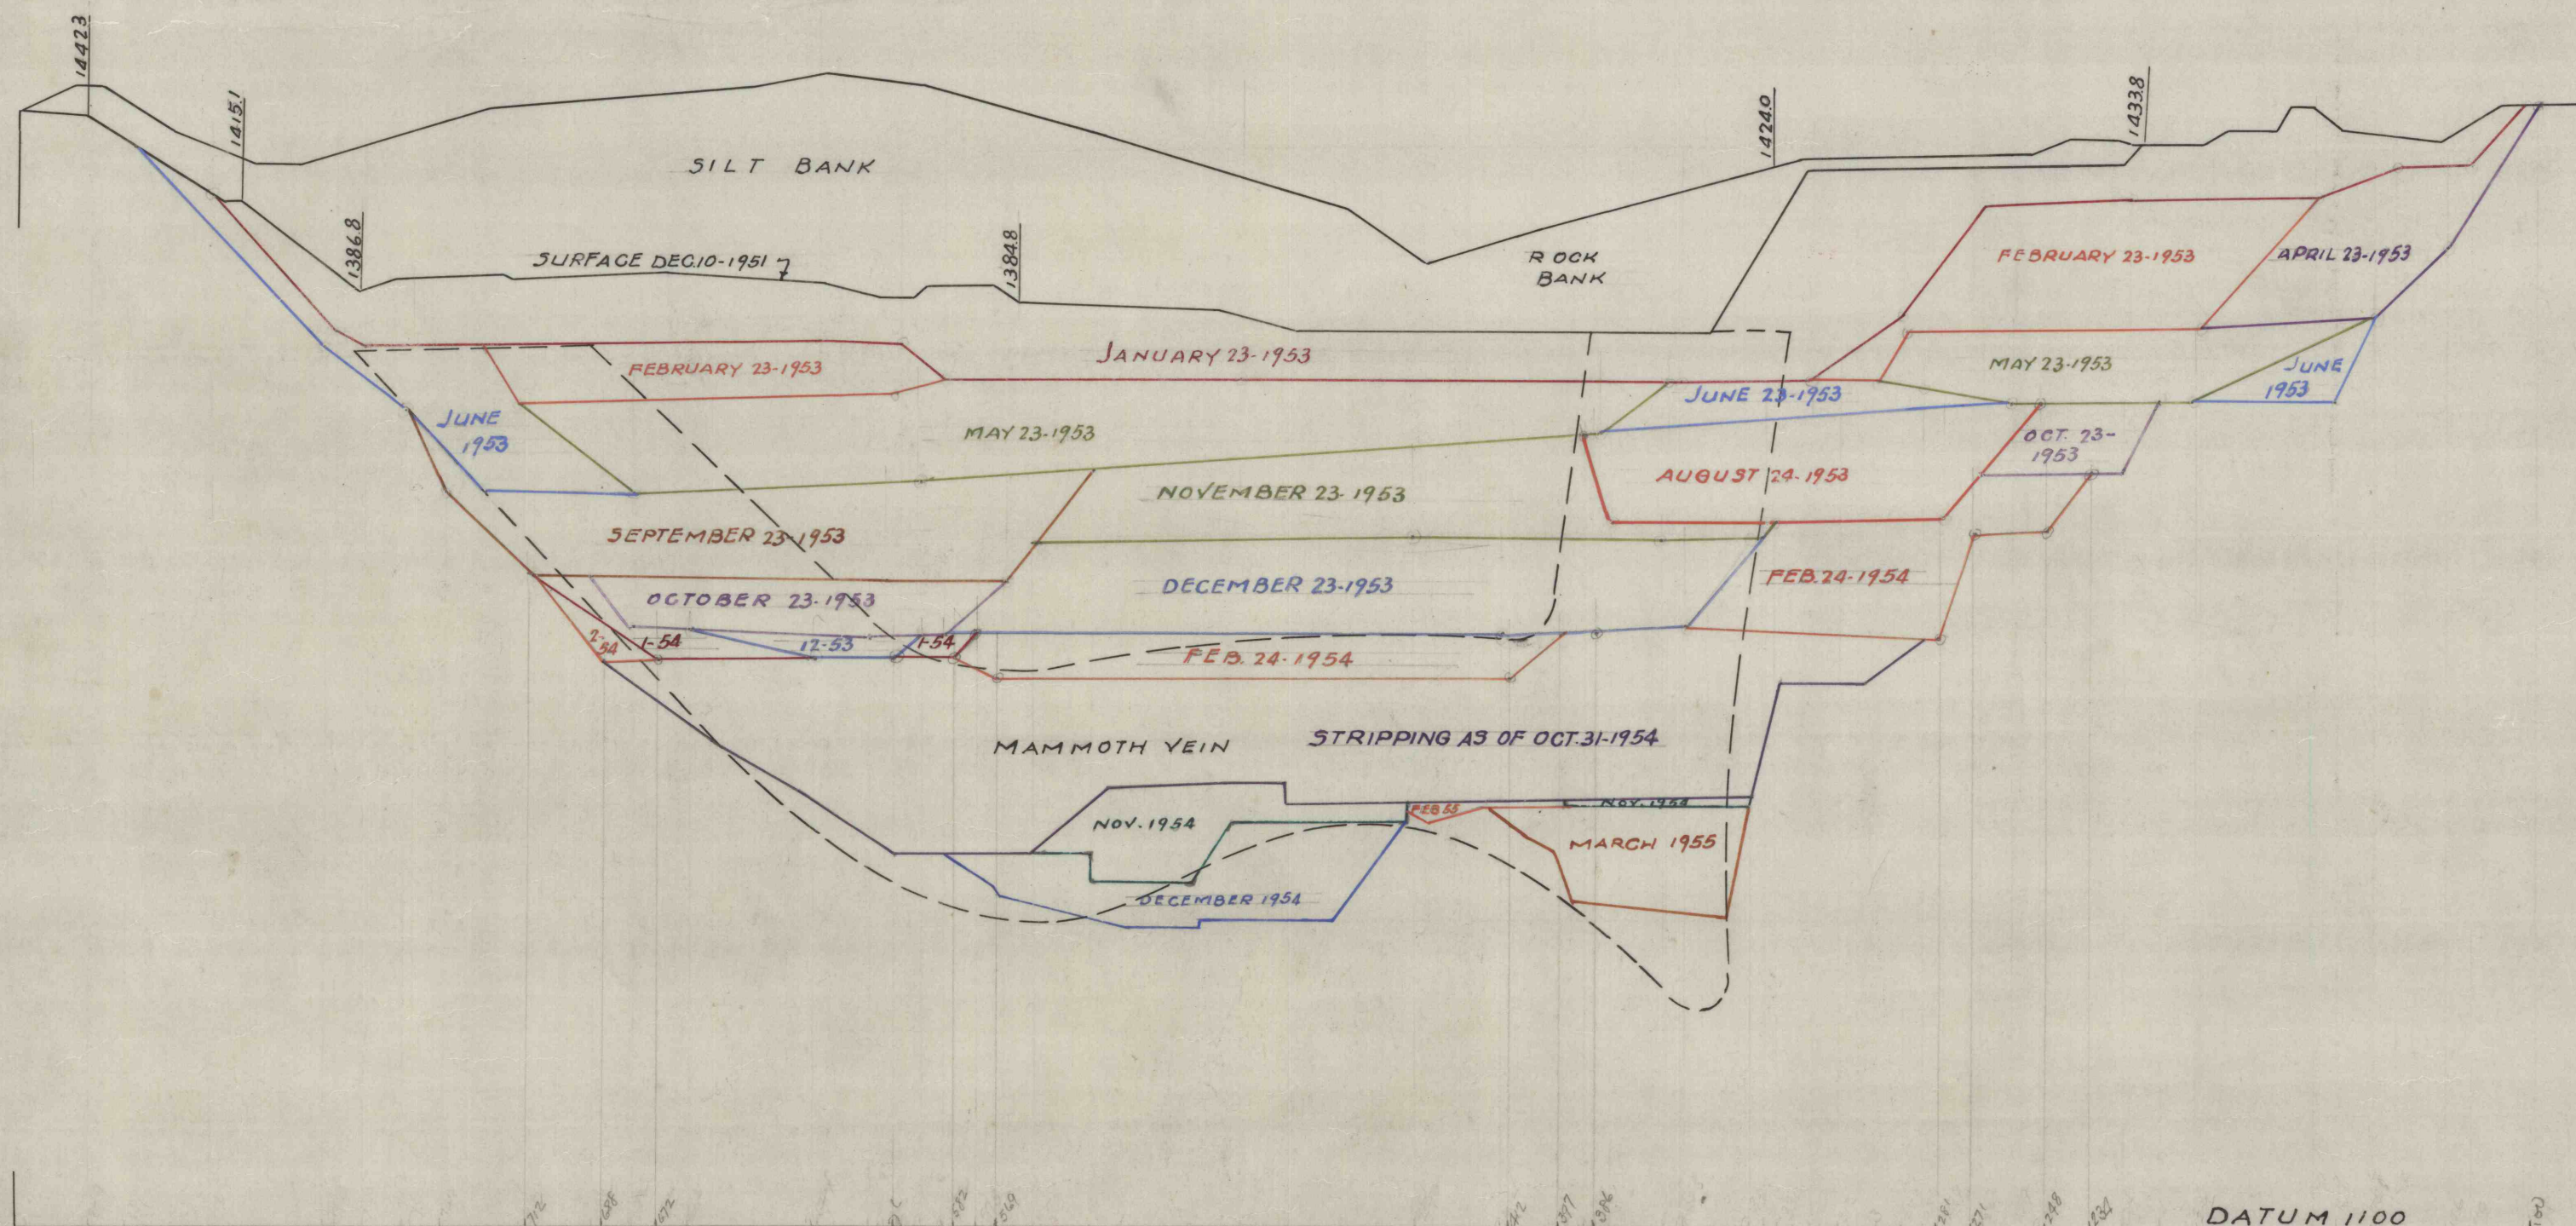

COPIED FROM L.C.CO.

J. ROBERT BAZLEY, Inc.			
POTTSVILLE, PENNA.			
WESTON COAL CO.			
MOREA STRIPPING			
SECTION 3+00 EAST			
DATE	SCALE	BY	
1-53	1"=50'	I-44A	