


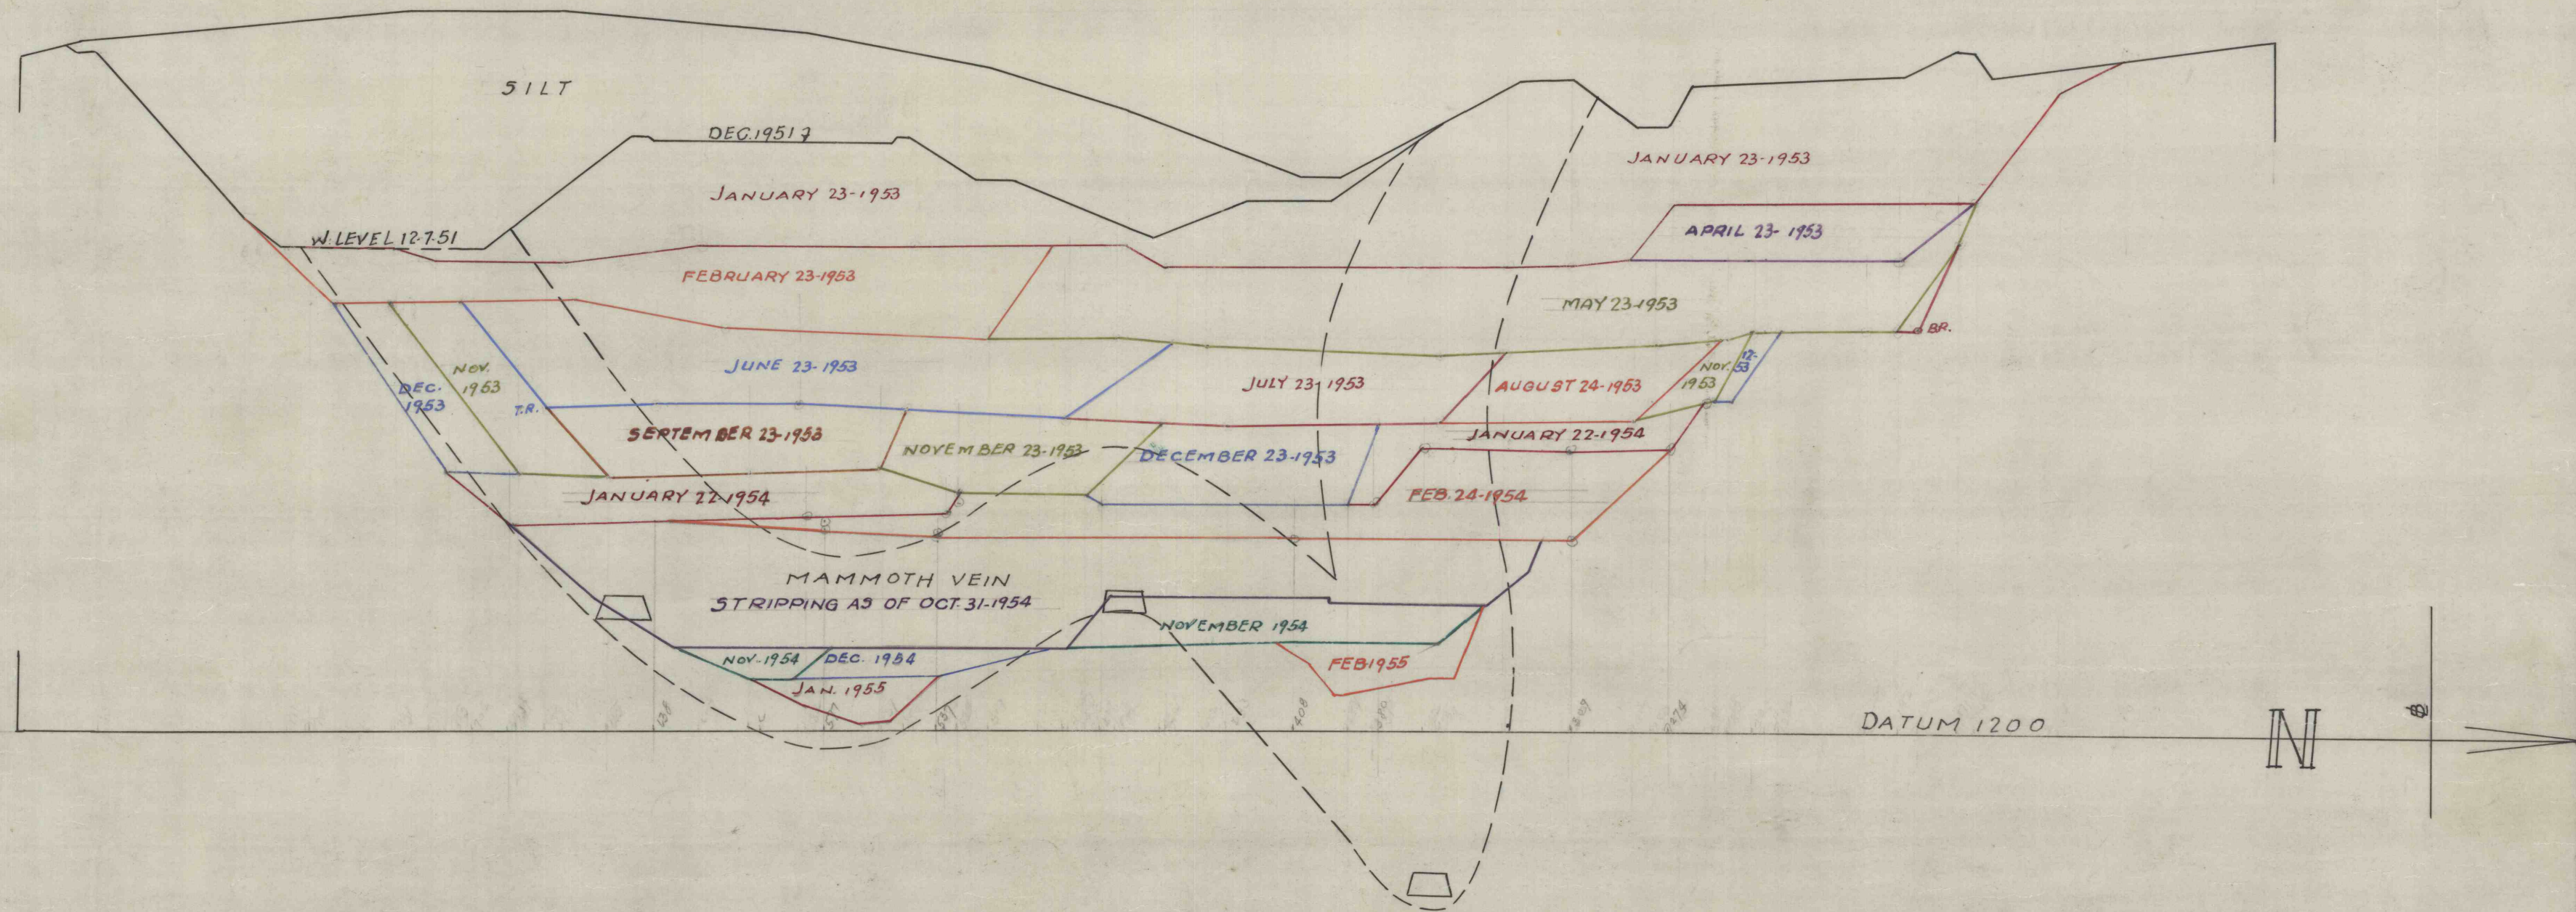

COPIED FROM L.C.CO.

J. ROBERT BAZLEY, Inc.
POTTSVILLE, PENNA.

WESTON COAL CO.
MOREA STRIPPING
SECTION 5+00 EAST

DATE	SCALE	BY	DRAWING
1-53	1"=50'		I-44A