


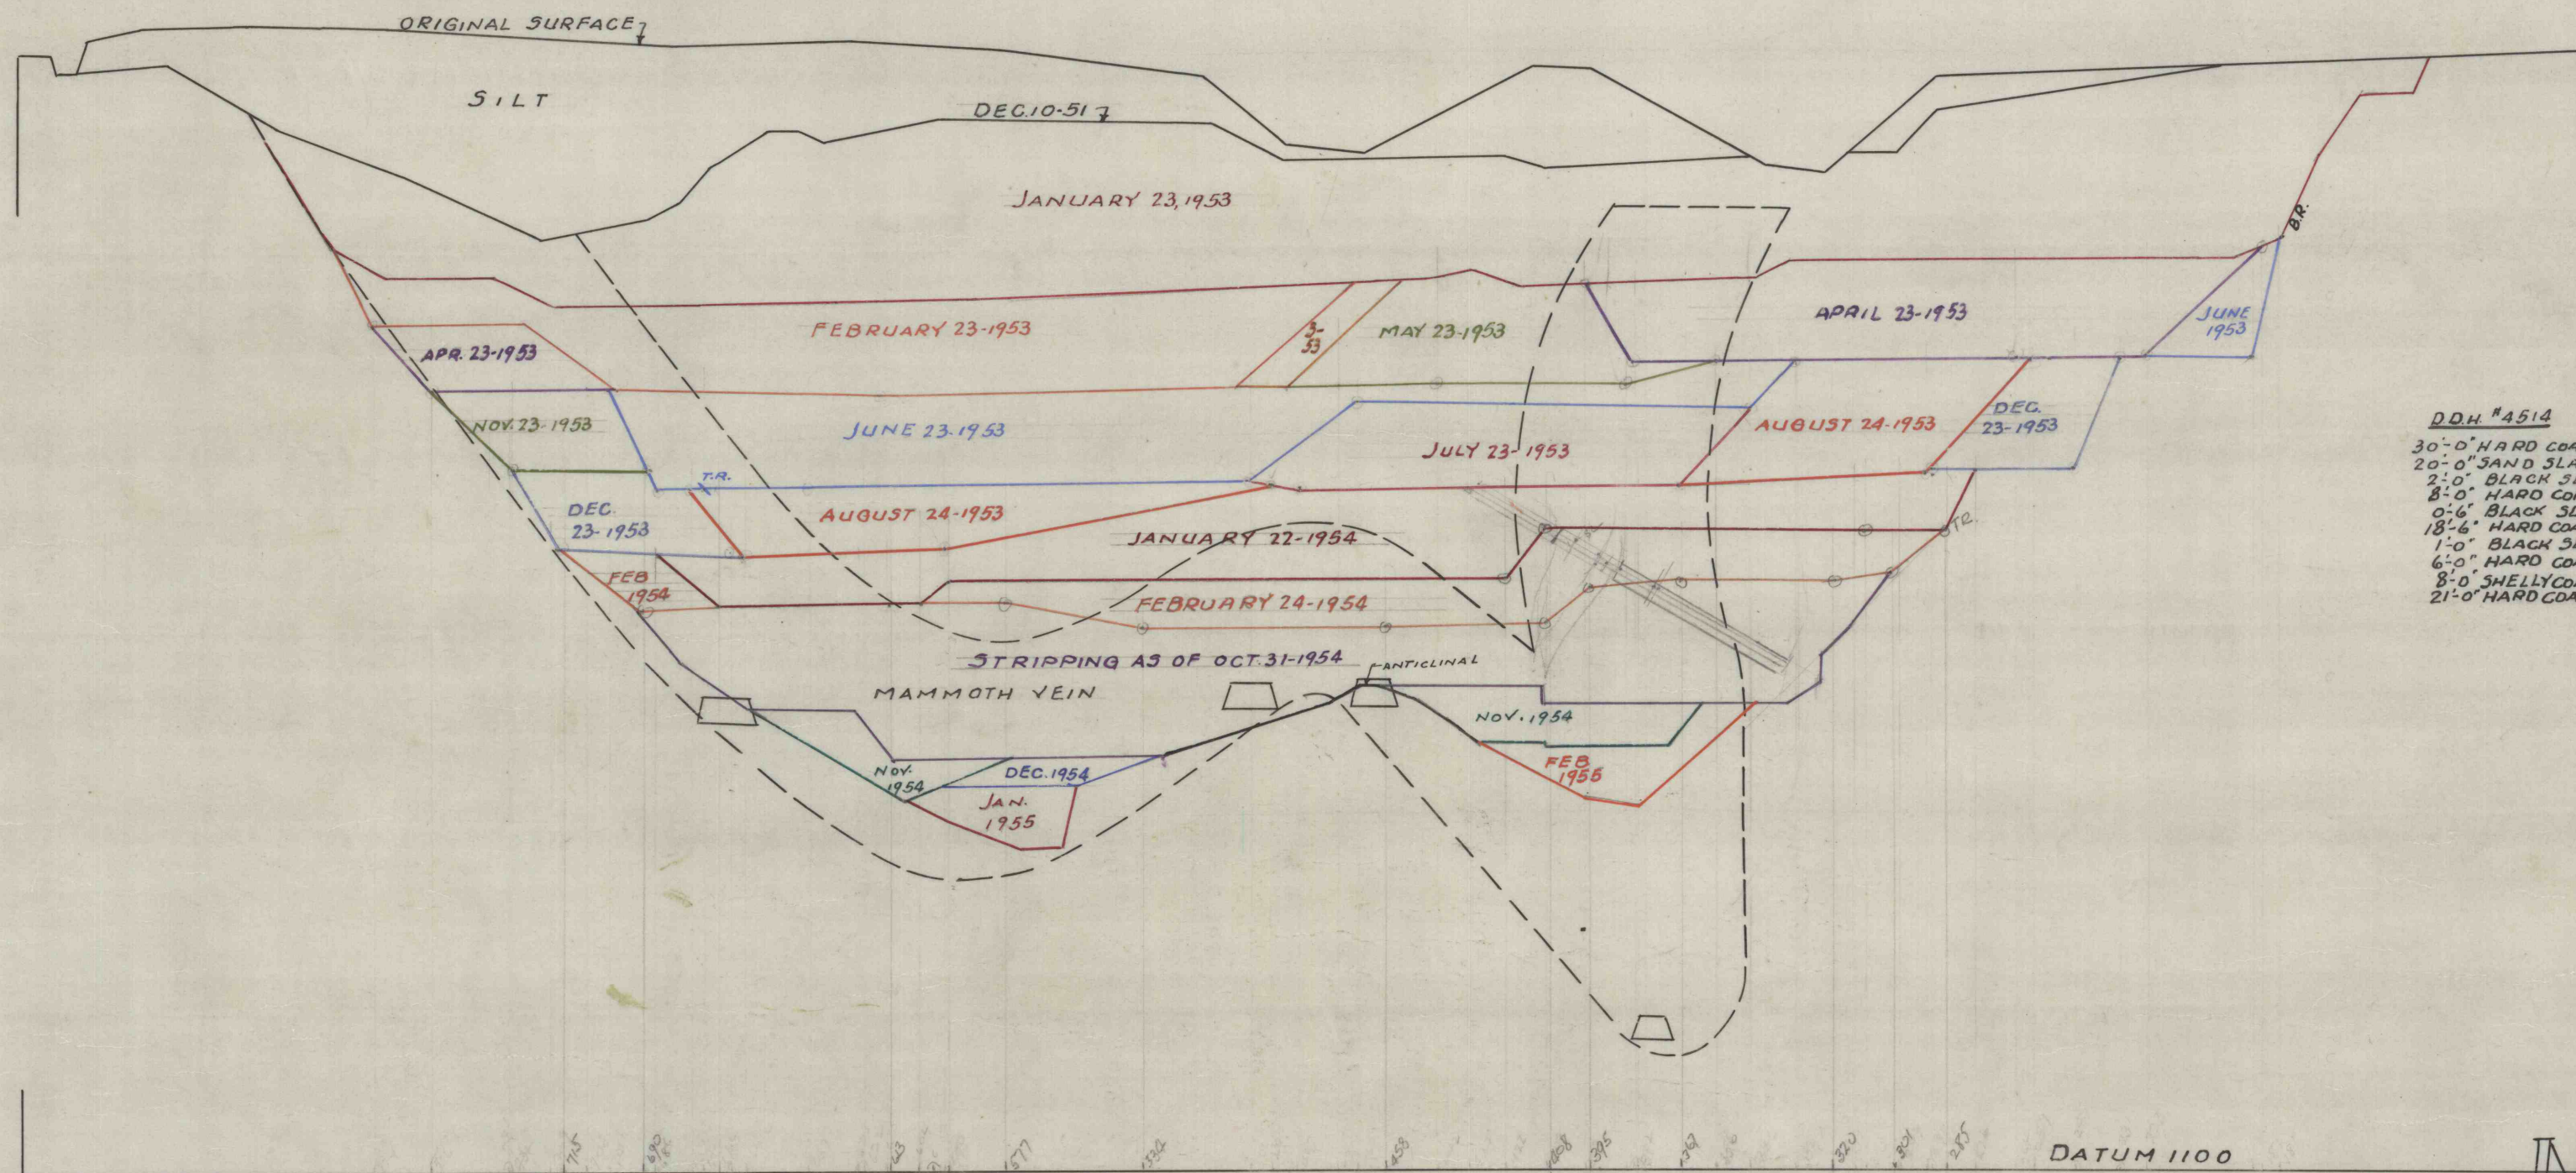

D.D.H. #4514
 30'-0" HARD COAL
 20'-0" SAND SLATE
 2'-0" BLACK SLATE
 8'-0" HARD COAL
 0'-6" BLACK SLATE
 18'-6" HARD COAL
 1'-0" BLACK SLATE
 6'-0" HARD COAL
 8'-0" SHELLY COAL
 21'-0" HARD COAL

J. ROBERT BAZLEY, Inc.
 POTTSVILLE, PENNA.
 WESTON COAL CO.
 MOREA STRIPPING
 SECTION 6+00 EAST

DATE	SCALE	BY	
1-53	1"=50'		I 44A