


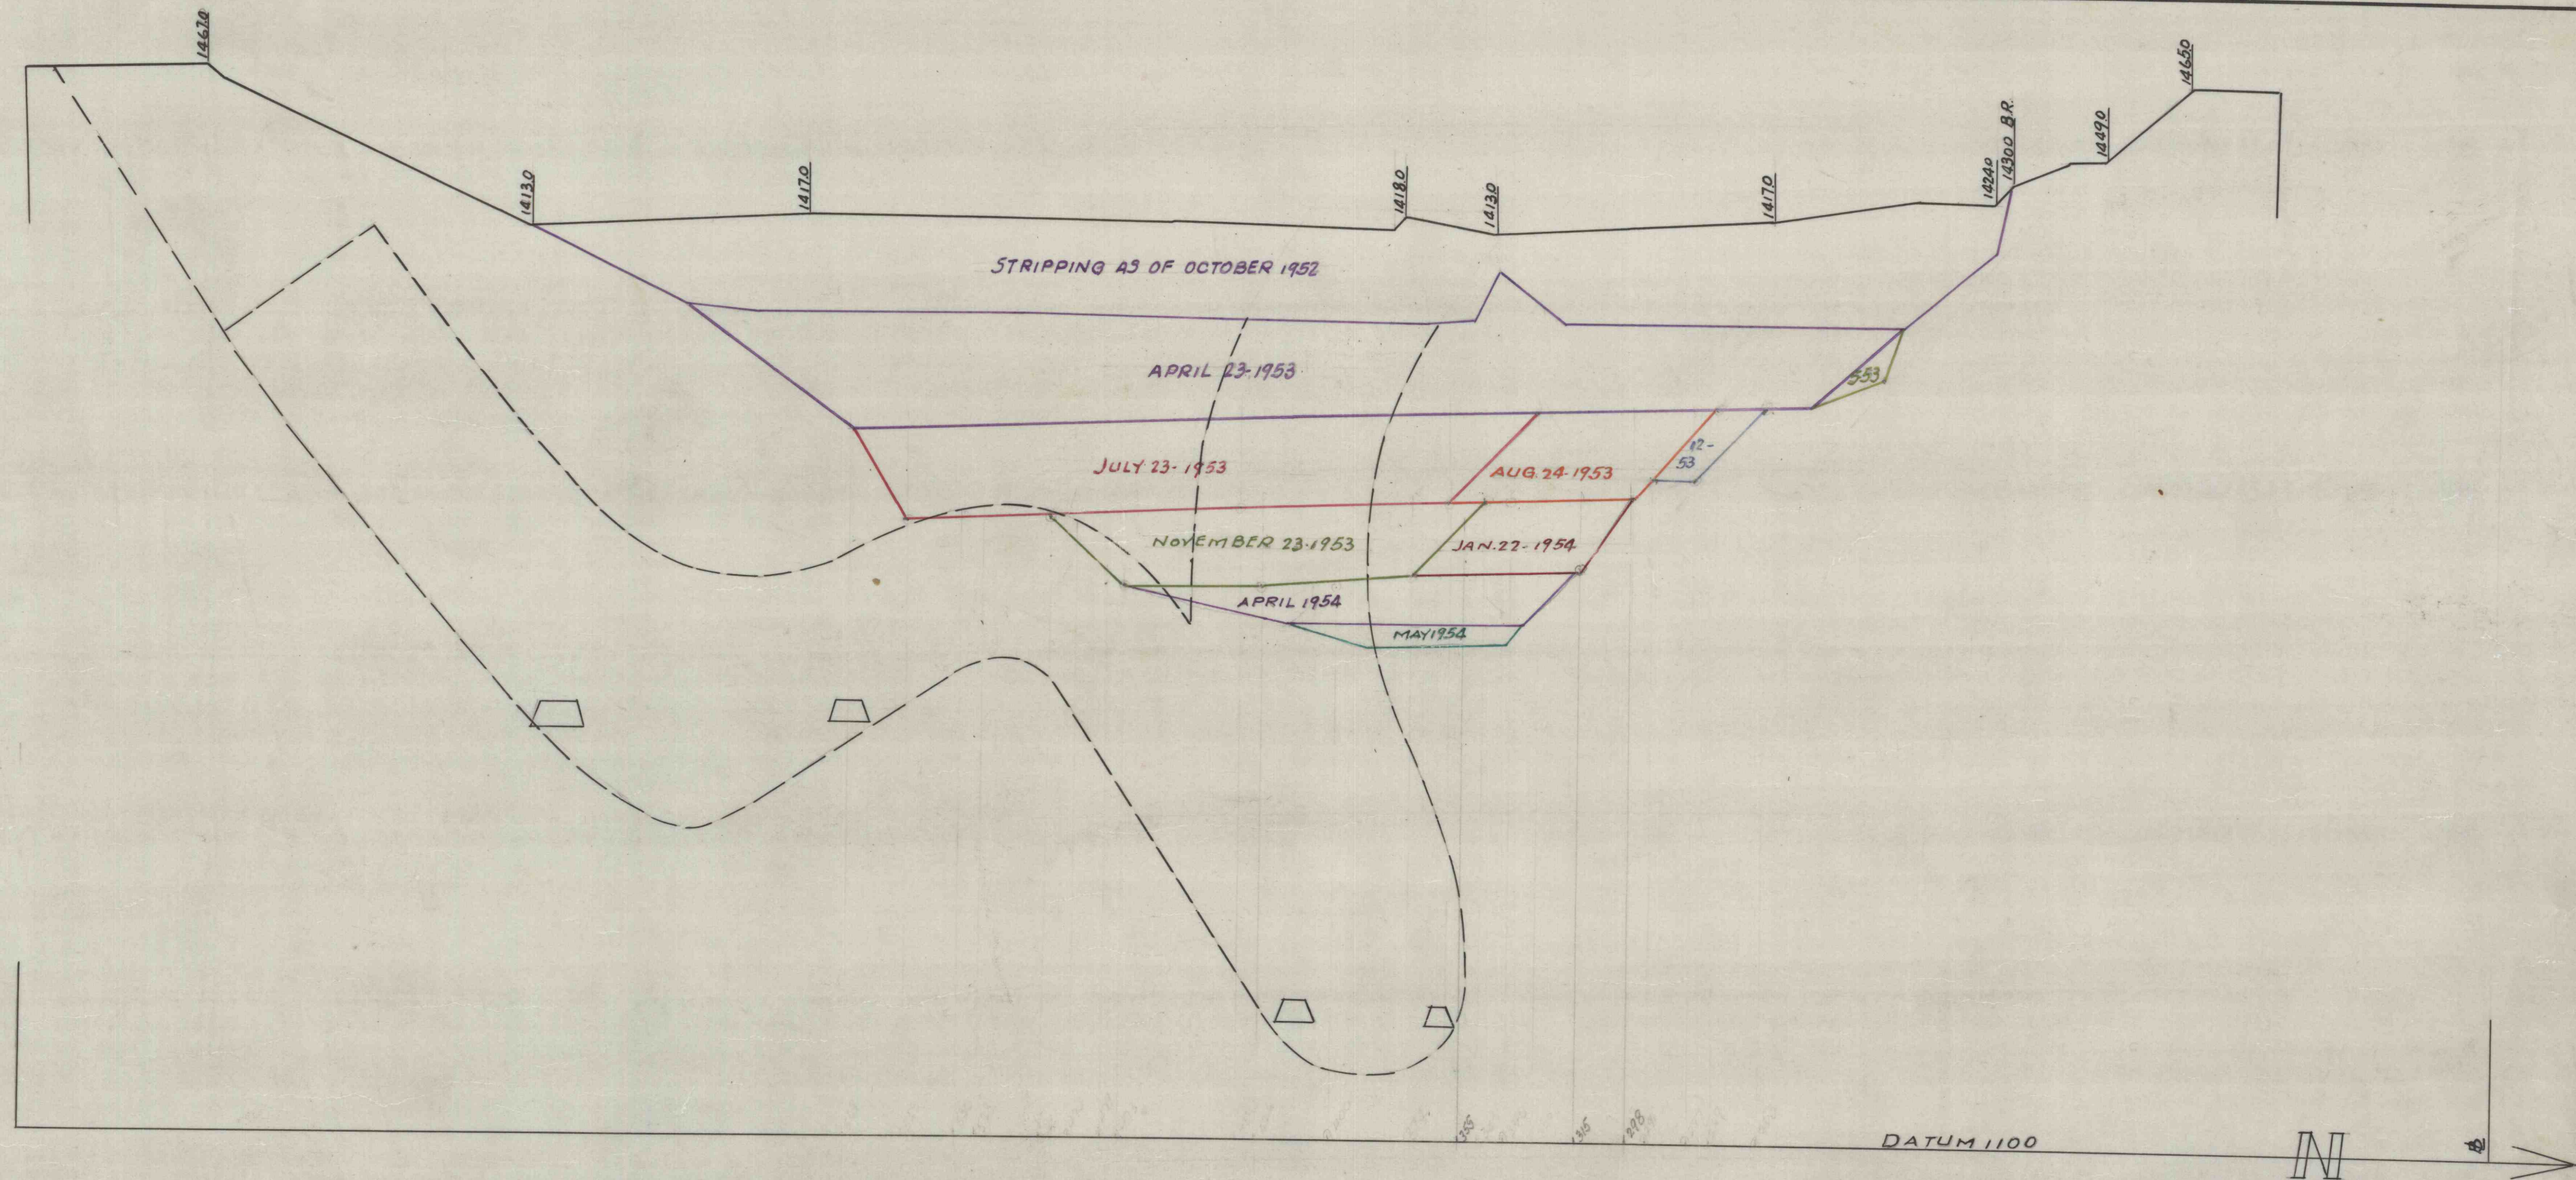

J. ROBERT BAZLEY, Inc.
POTTSVILLE, PENNA.
WESTON COAL CO.
MOREA STRIPPING
SECTION 10+00 EAST
DATE 6-9-53 SCALE 1"=50' BY DATA NO. I-44A