


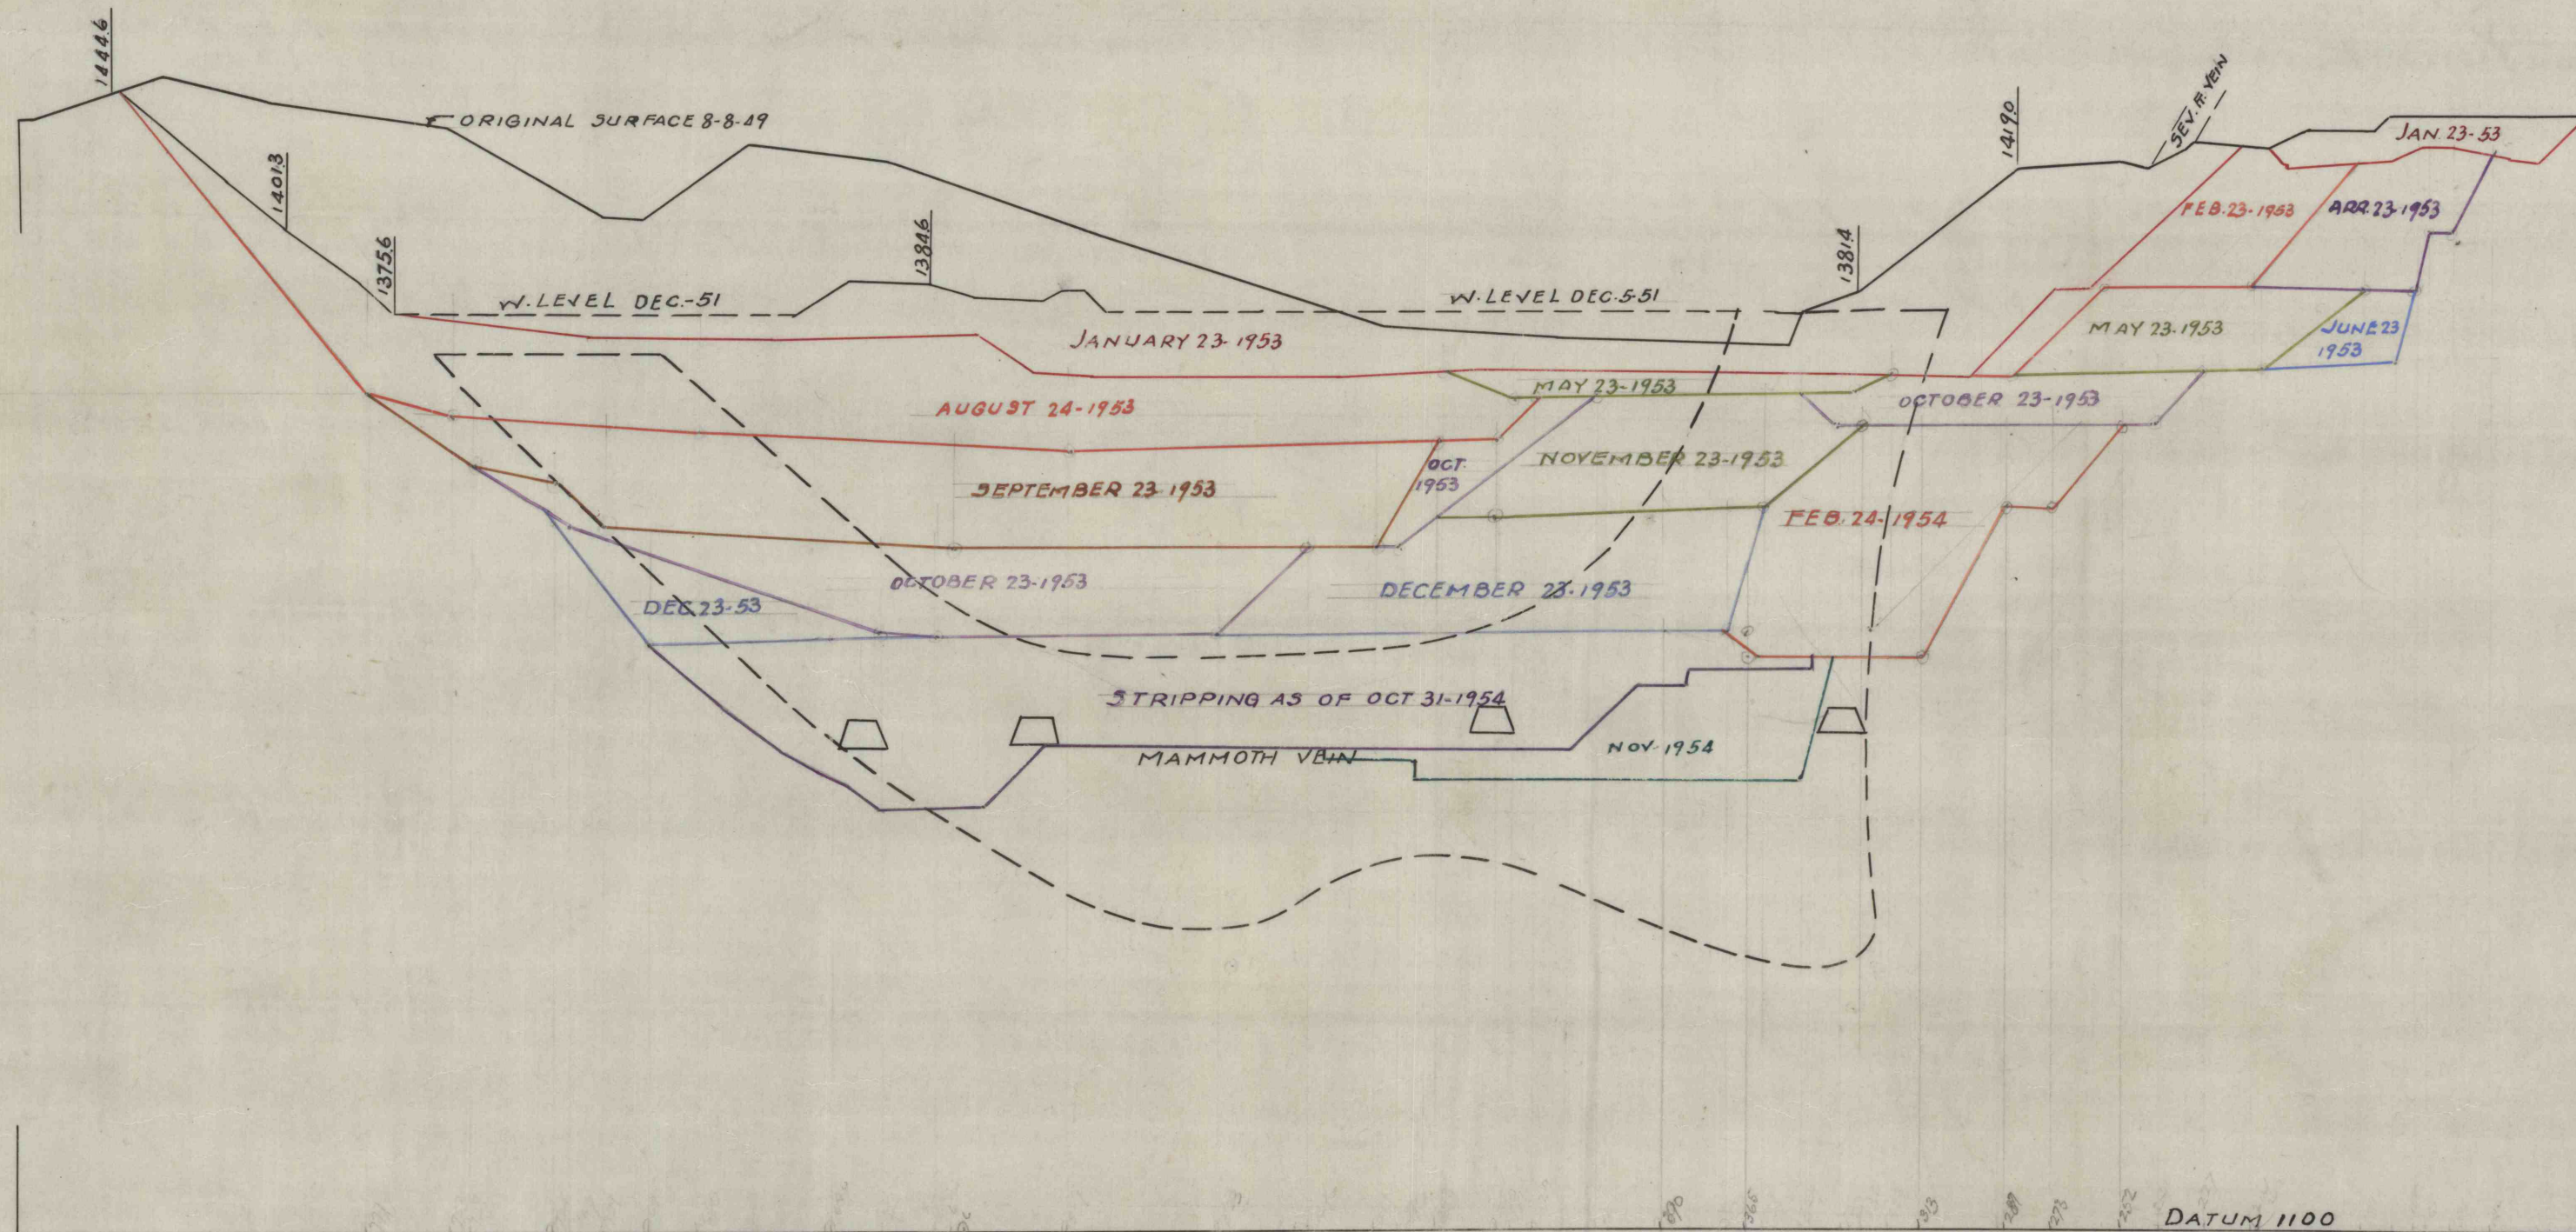

COPIED FROM L.C.CO.

J. ROBERT BAZLEY, Inc.
POTTSVILLE, PENNA.

WESTON COAL CO.
MOREA STRIPPING
SECTION 2+00 EAST

DATE 1-53 SCALE 1"=50' BY I-44A