


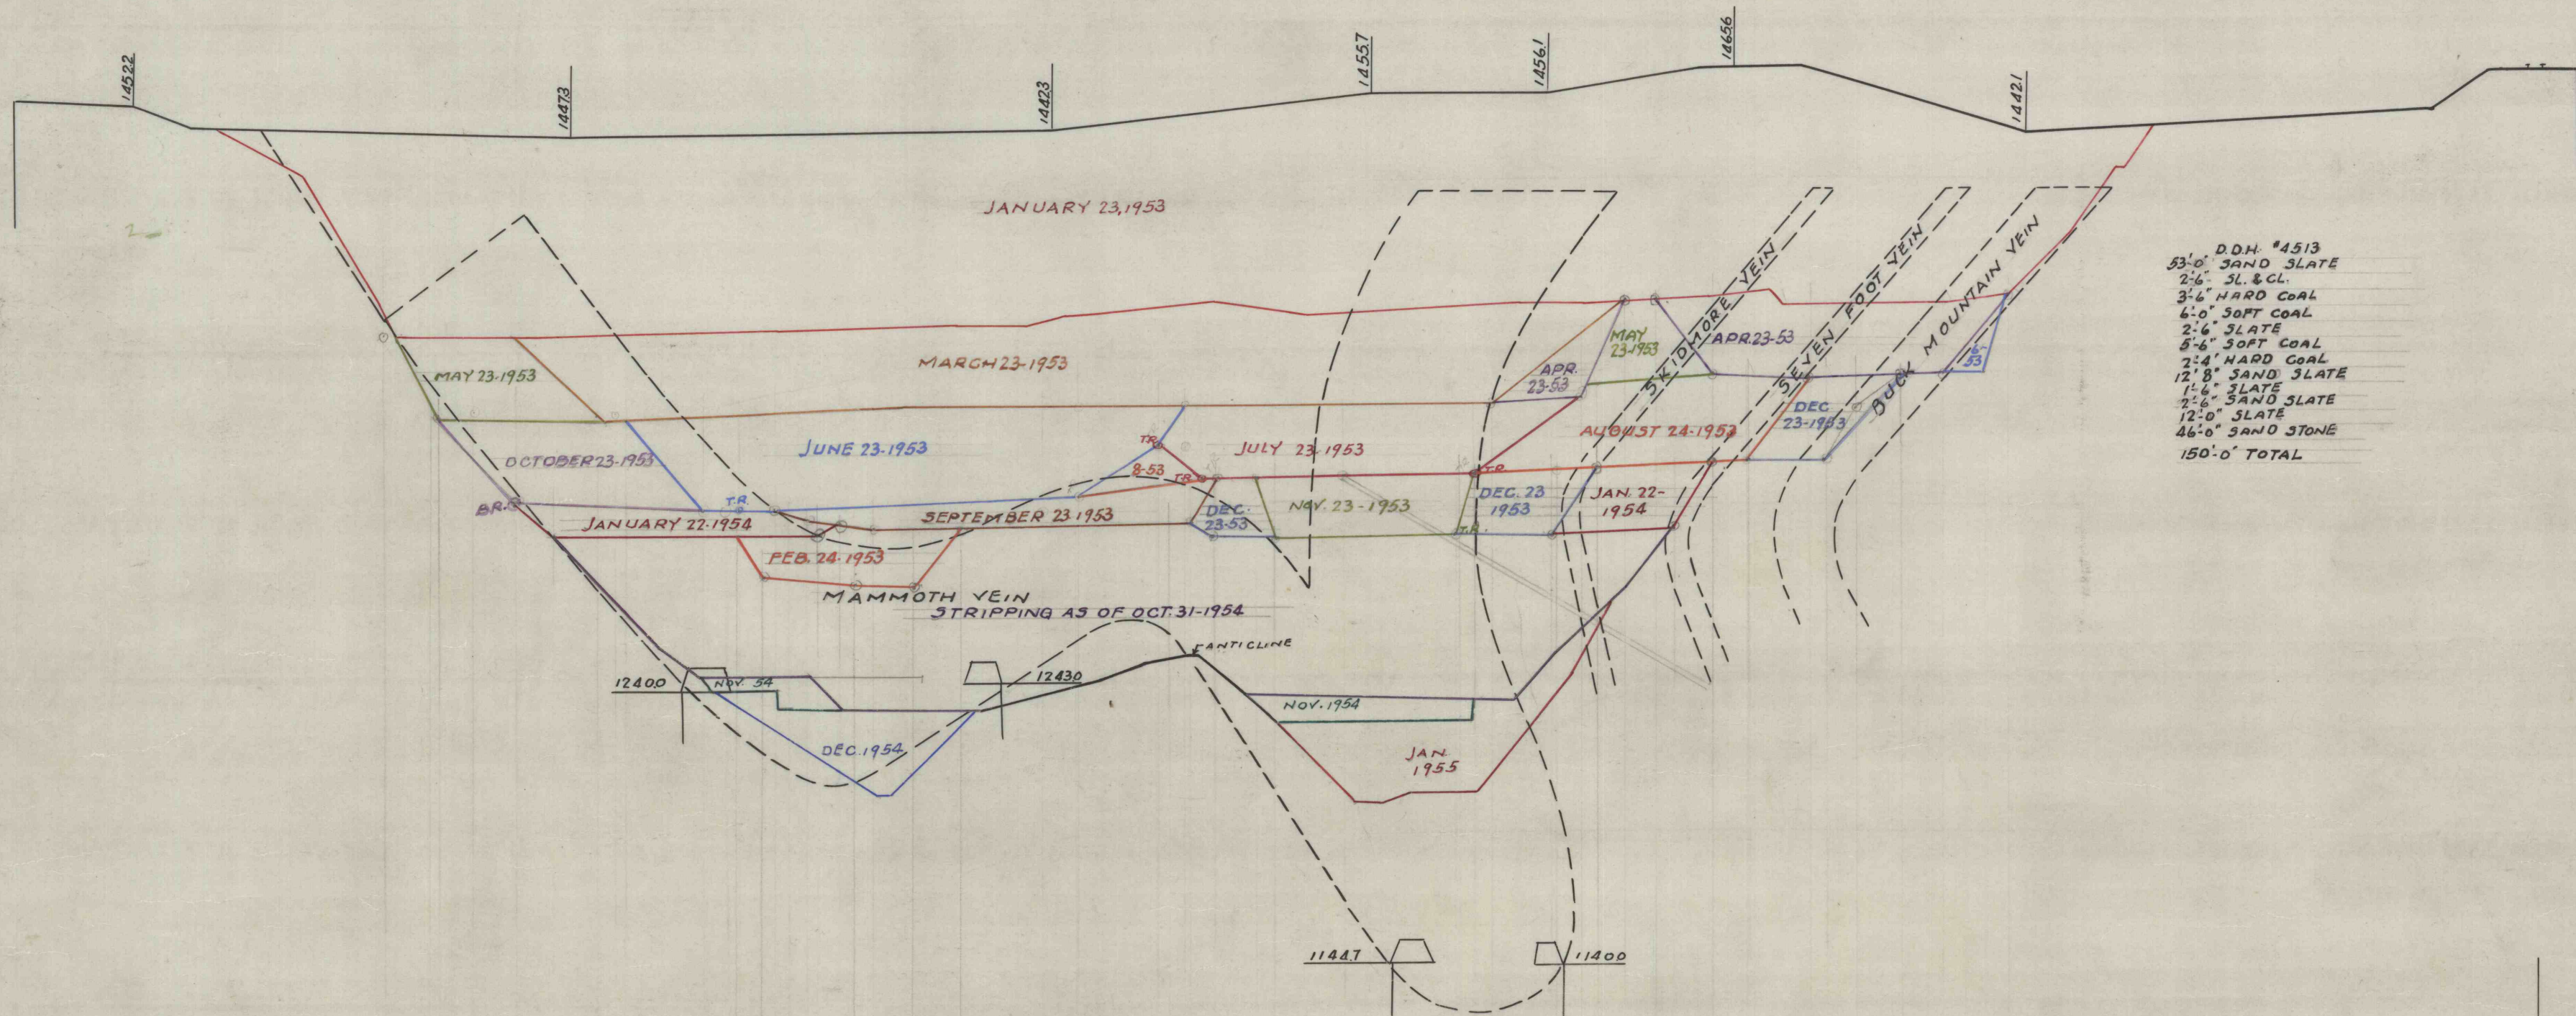

D.D.H. #4513
 53'-0" SAND SLATE
 2'-6" SL. & CL.
 3'-6" HARD COAL
 6'-0" SOFT COAL
 2'-6" SLATE
 5'-6" SOFT COAL
 2'-4" HARD COAL
 12'-8" SAND SLATE
 1'-6" SLATE
 2'-6" SAND SLATE
 12'-0" SLATE
 46'-0" SAND STONE
 150'-0" TOTAL

DATUM 1100

N

COPIED FROM L.C.CO.

J. ROBERT BAZLEY, Inc.
 POTTSVILLE, PENNA.

WESTON COAL CO.
 MOREA STRIPPING
 SECTION 8+00 EAST

DATE 1-53	SCALE 1"=50'	BY I-44A
--------------	-----------------	-------------