


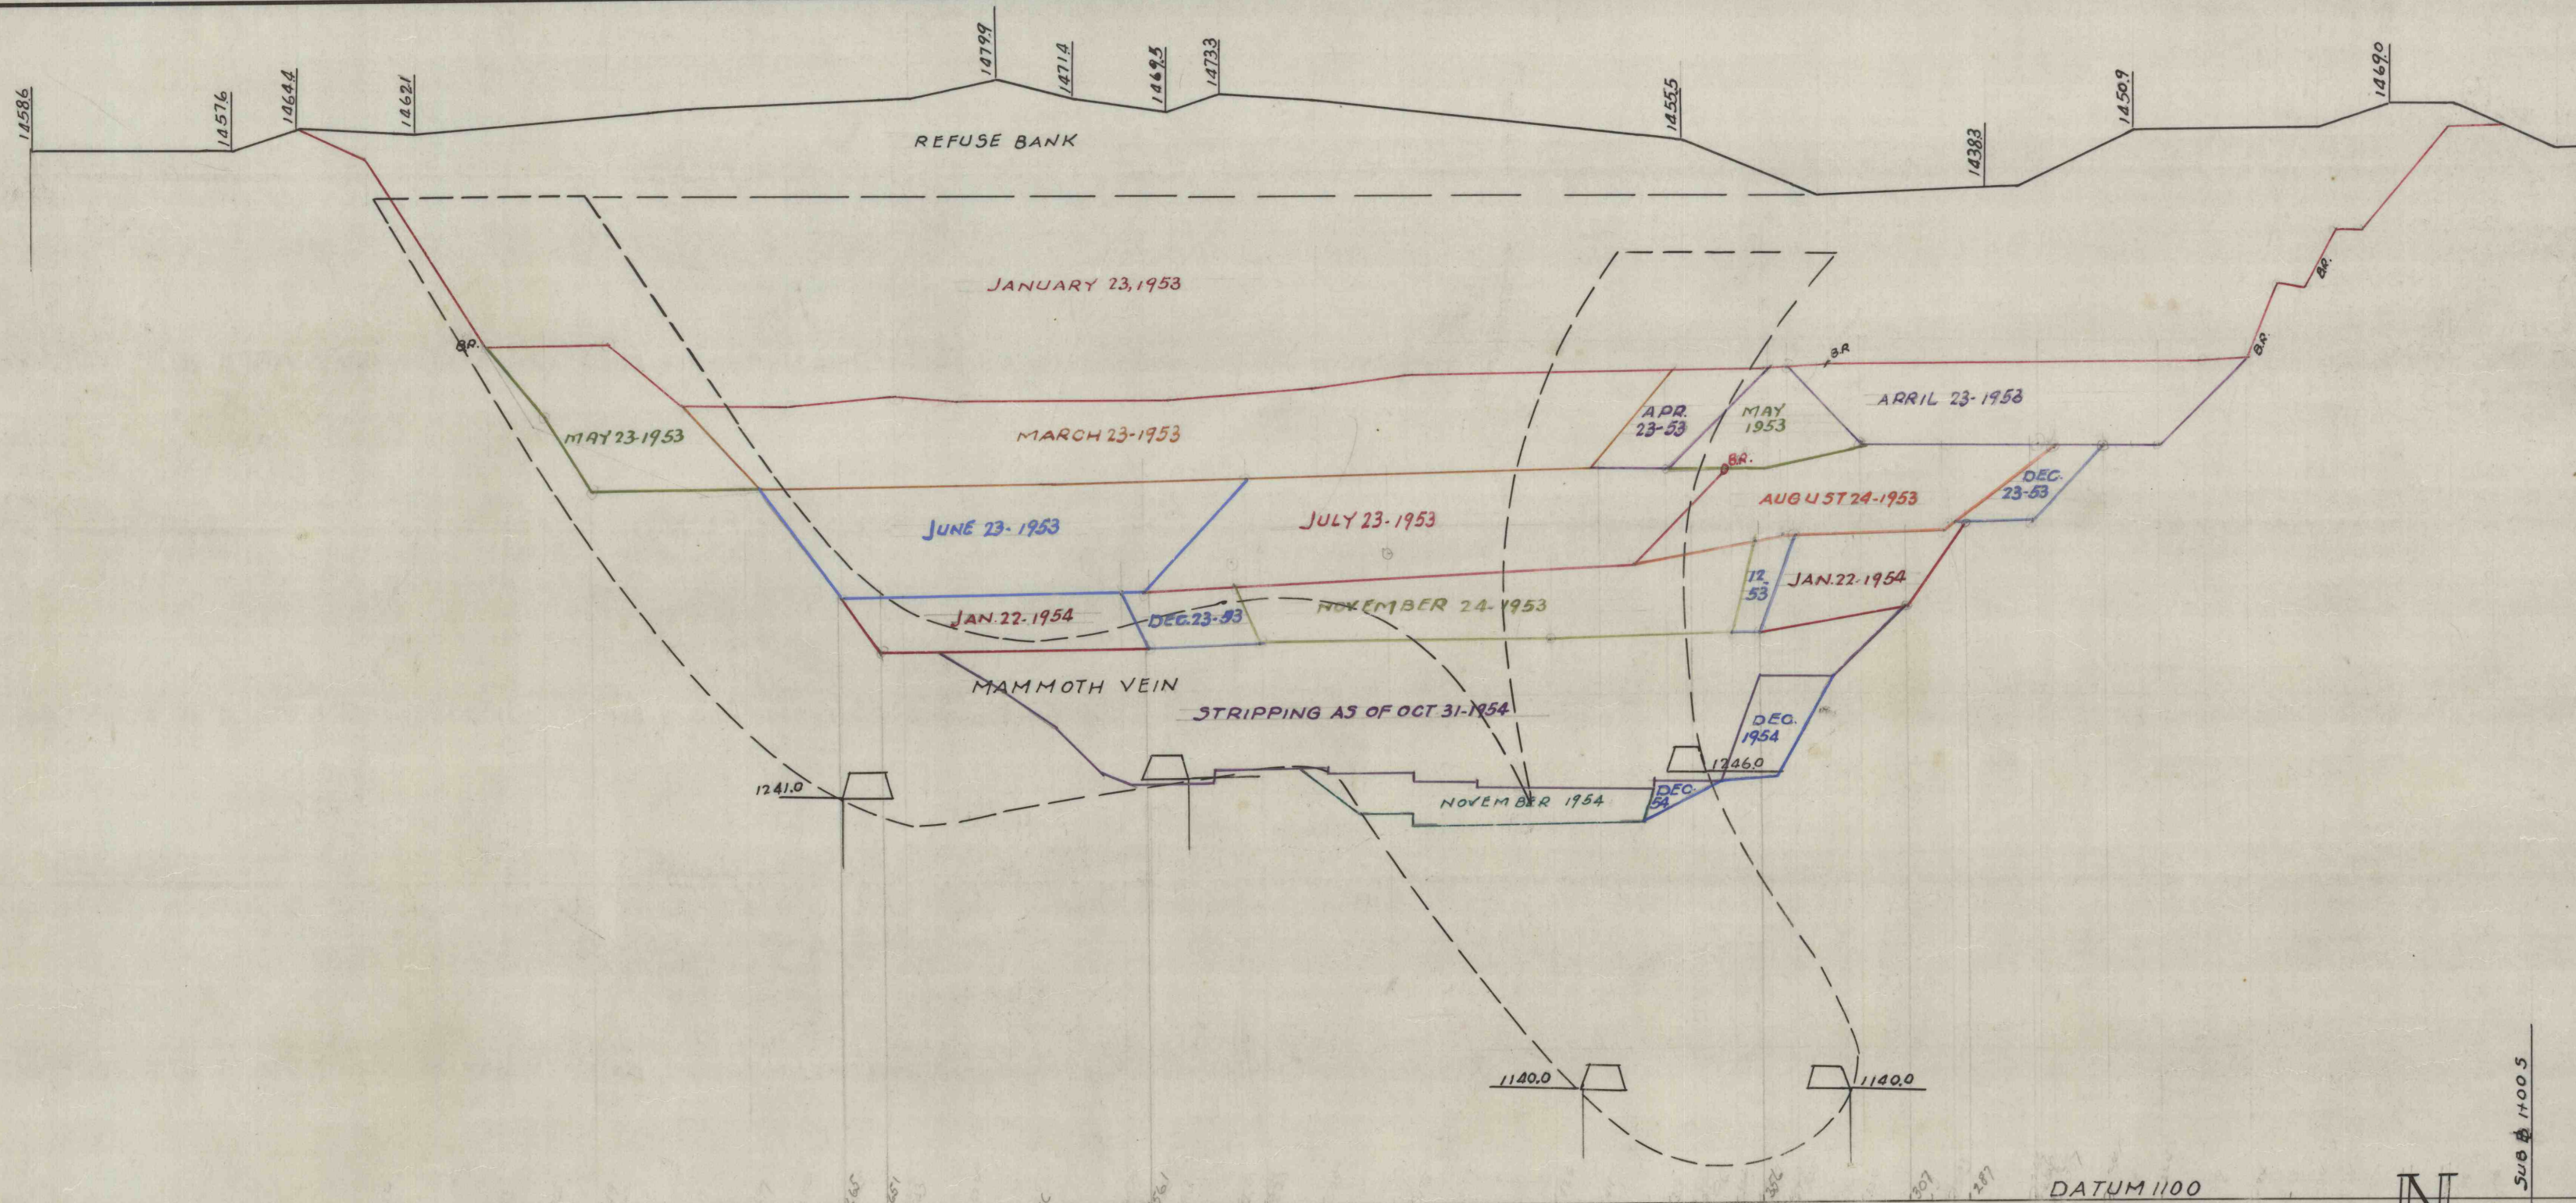

N

COPIED FROM L.C.CO.

J. ROBERT BAZLEY, Inc.
POTTSVILLE, PENNA.

WESTON COAL CO.
MOREA STRIPPING
SECTION 9+00 EAST

DATE 2-53	SCALE 1"=50'	BY I-44A
--------------	-----------------	-------------

SUB 1400 S