


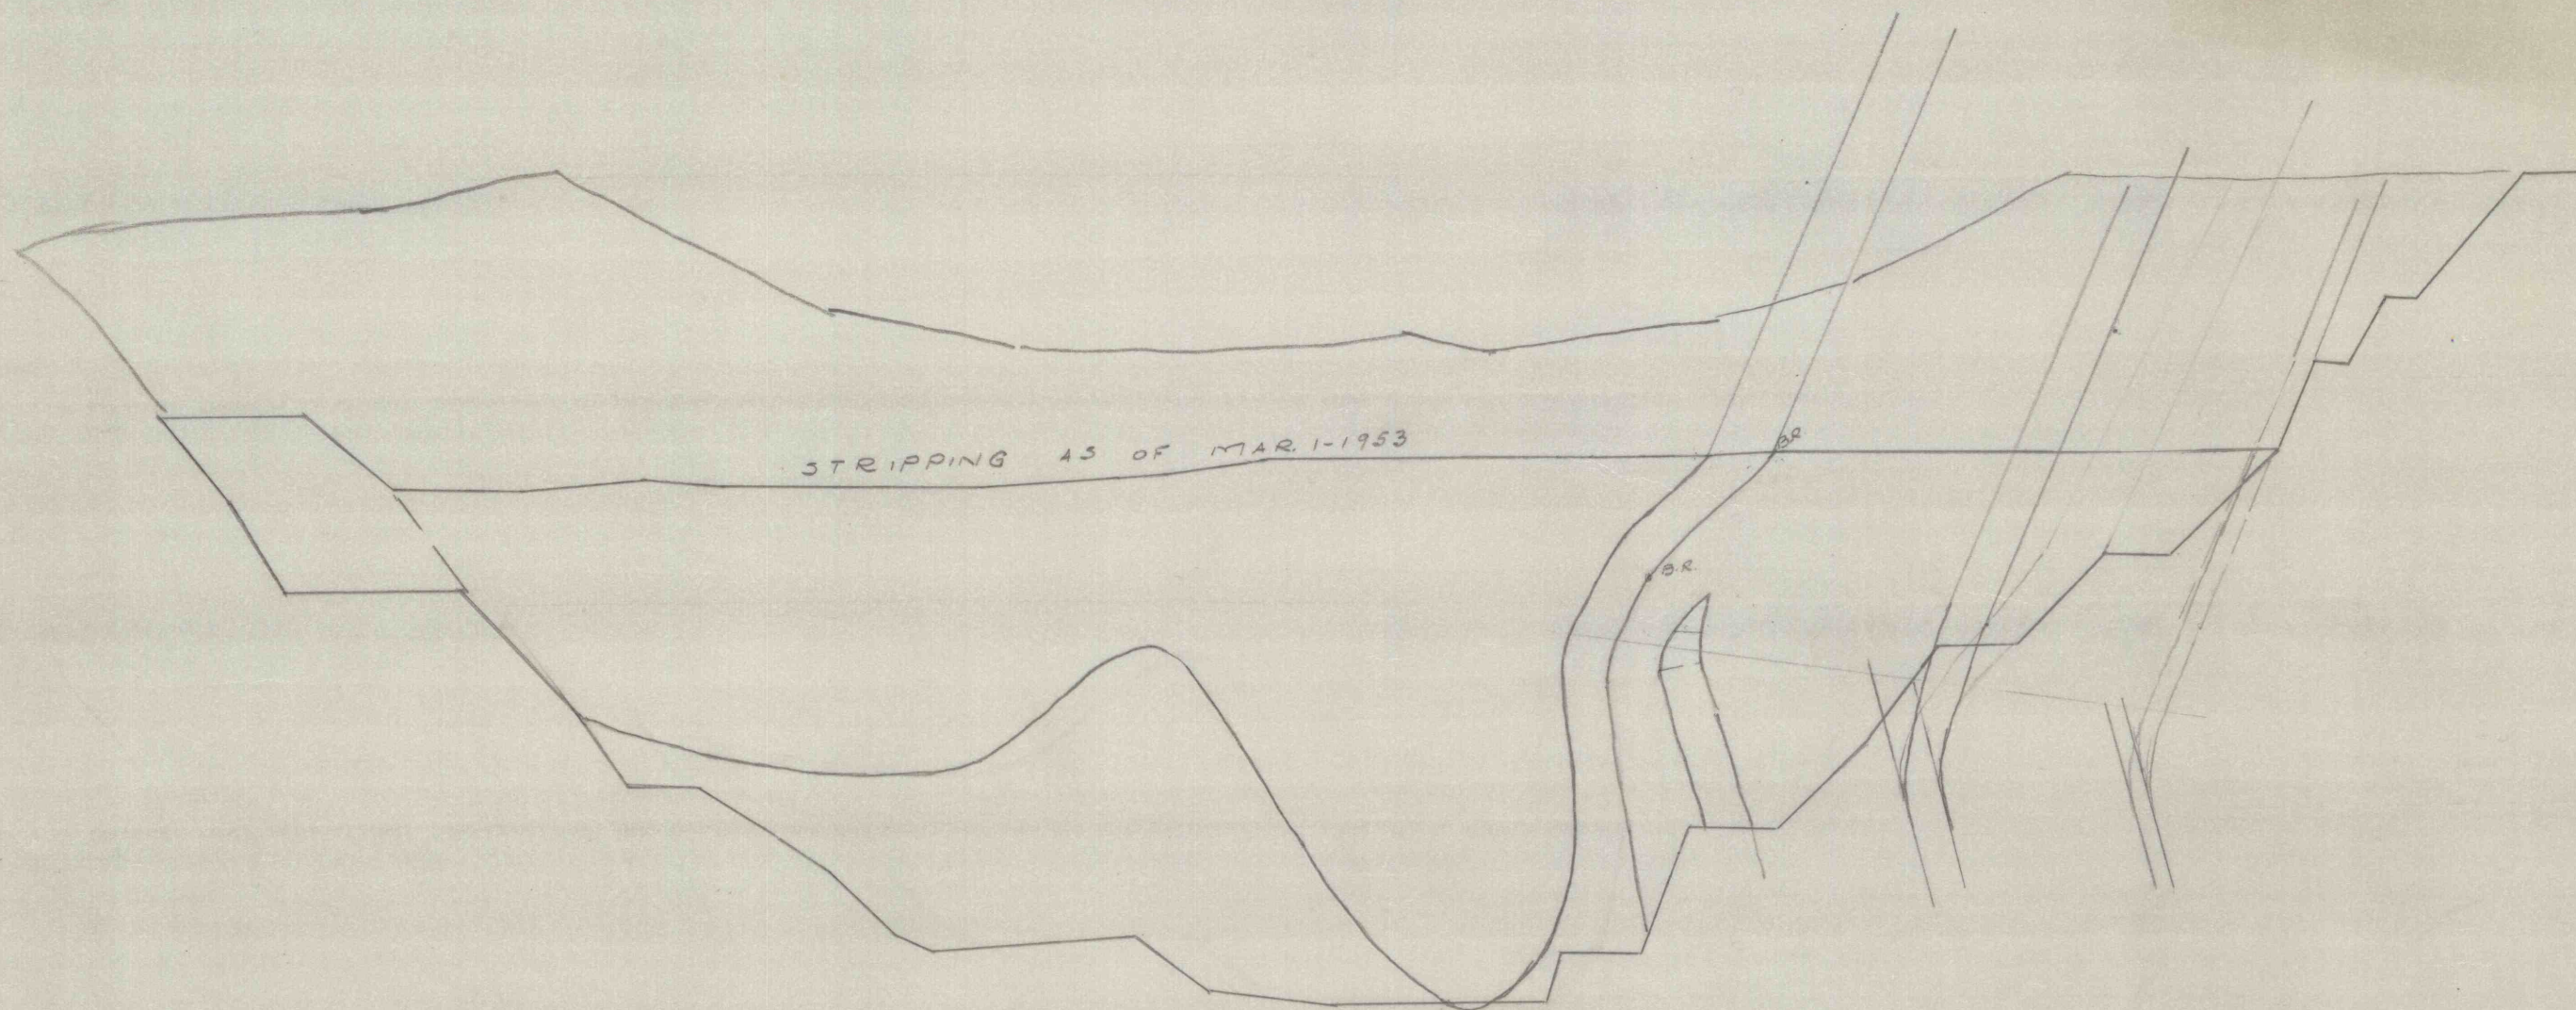

4005

1100

MOREA STRIPPING
SECTION 9+00 EAST
1" = 50'

011-MC-JAI