


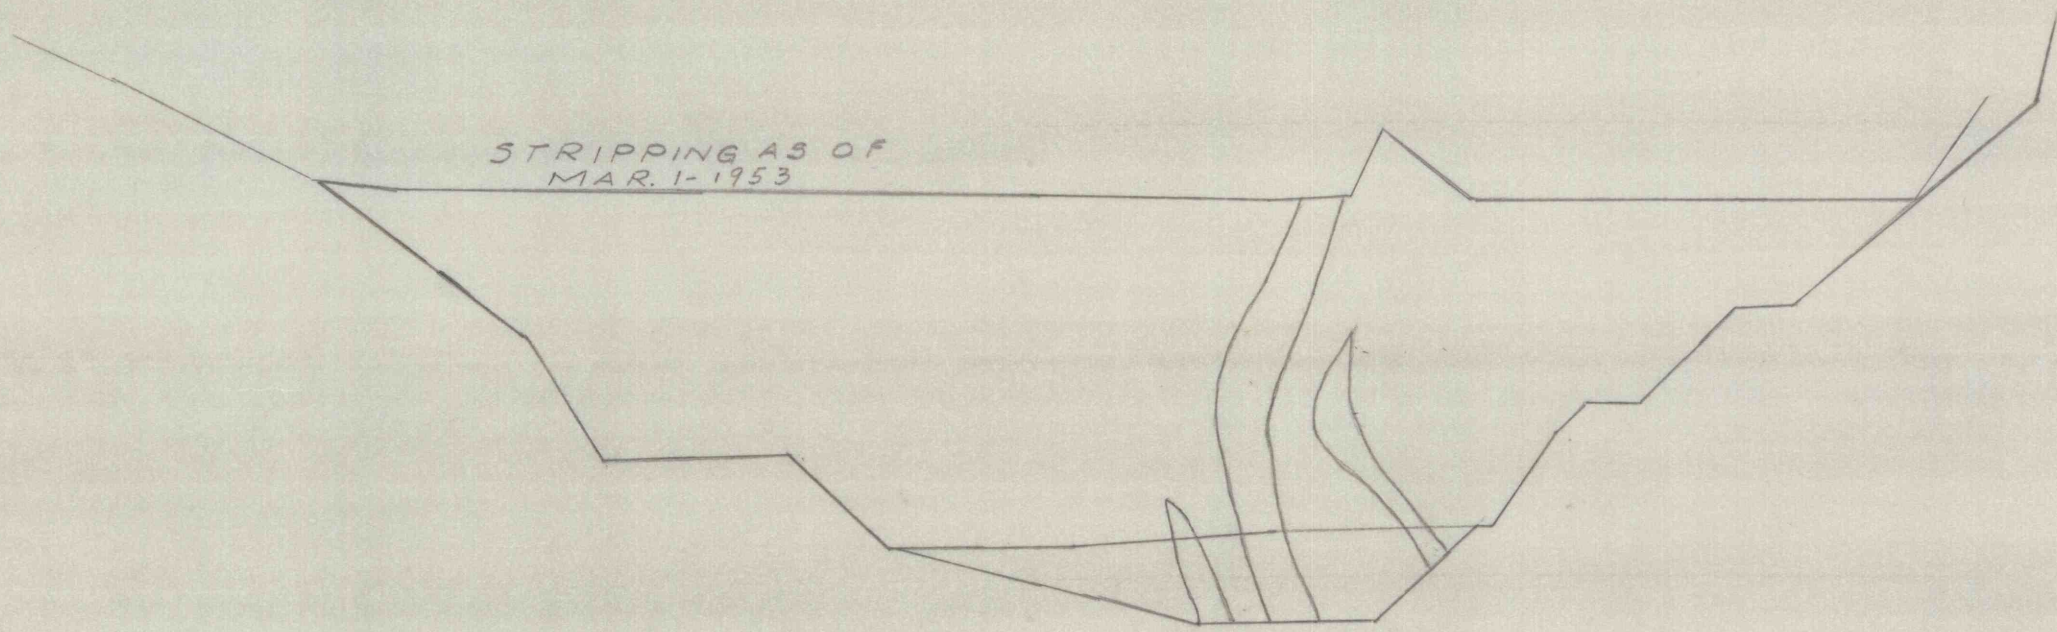

STRIPPING AS OF
MAR. 1-1953

1100

MOREA STRIPPING
SECTION 10+00 EAST
1"=50'

111-MC-JAL