


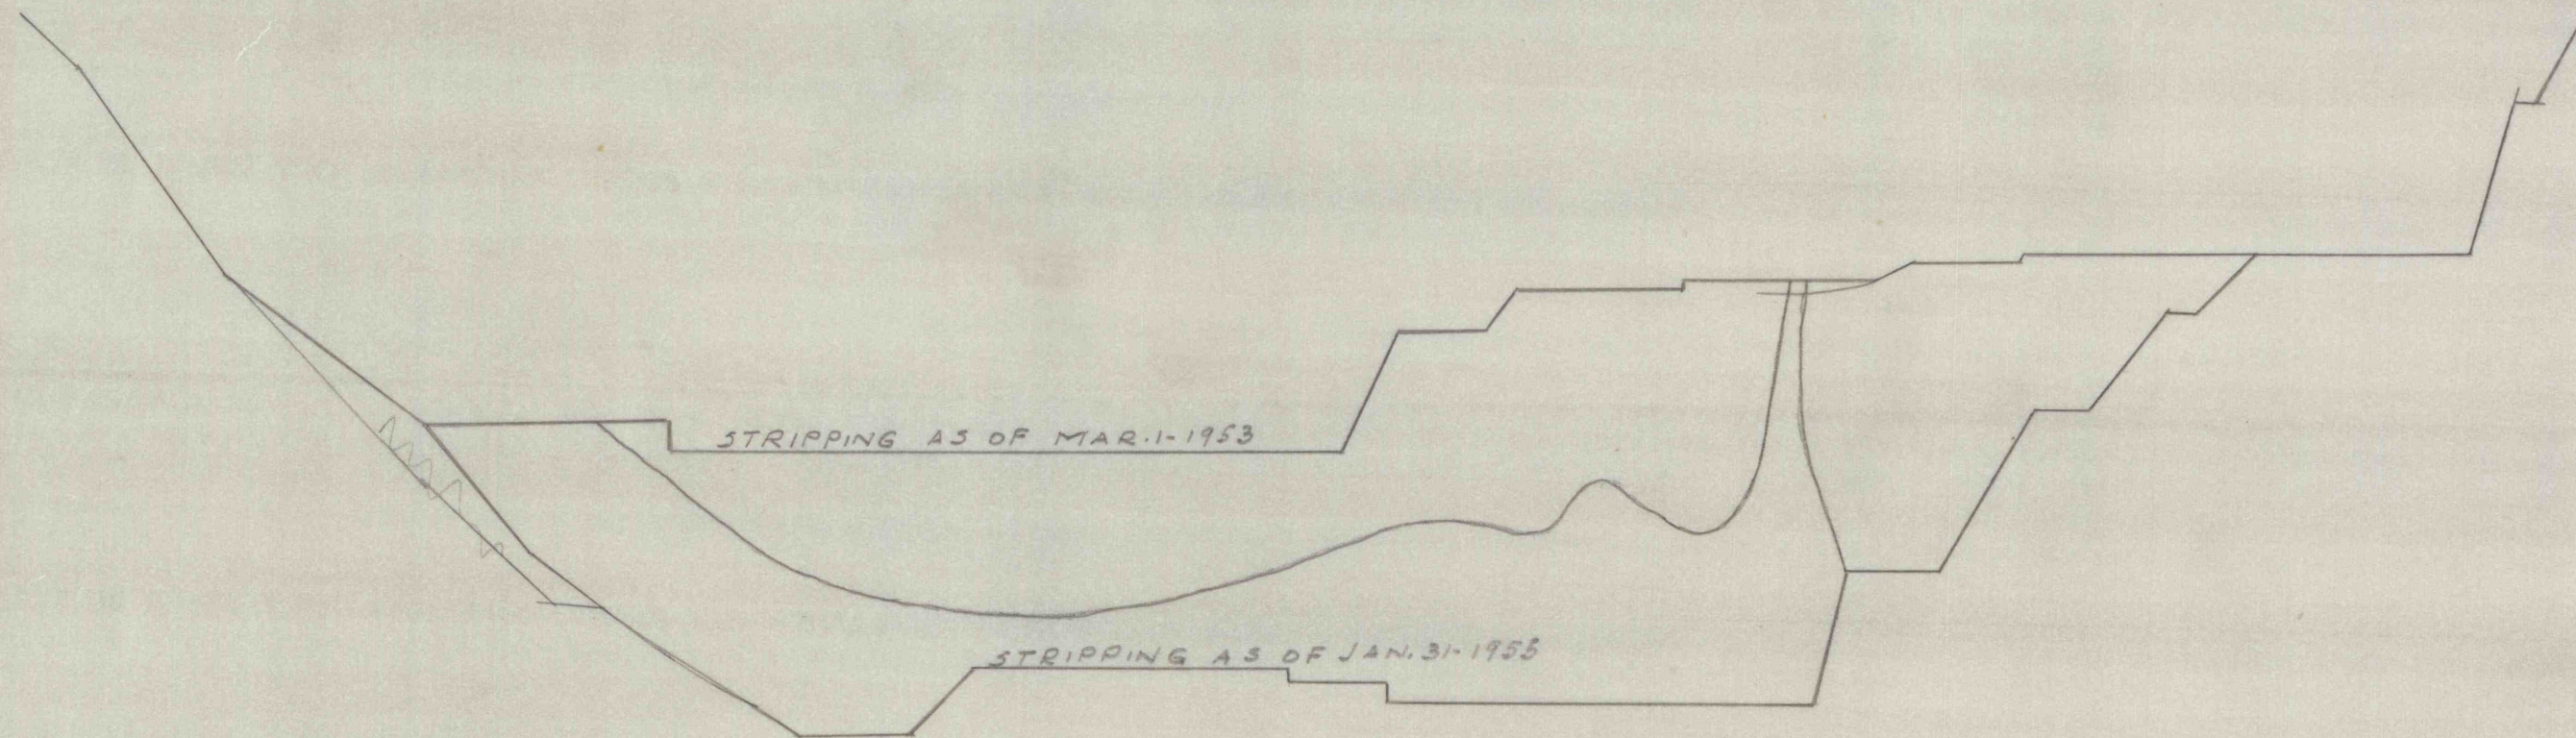

MOREA STRIPPING
SECTION 2+00 EAST
1"=50' FEB 11-1955

1000

1005