


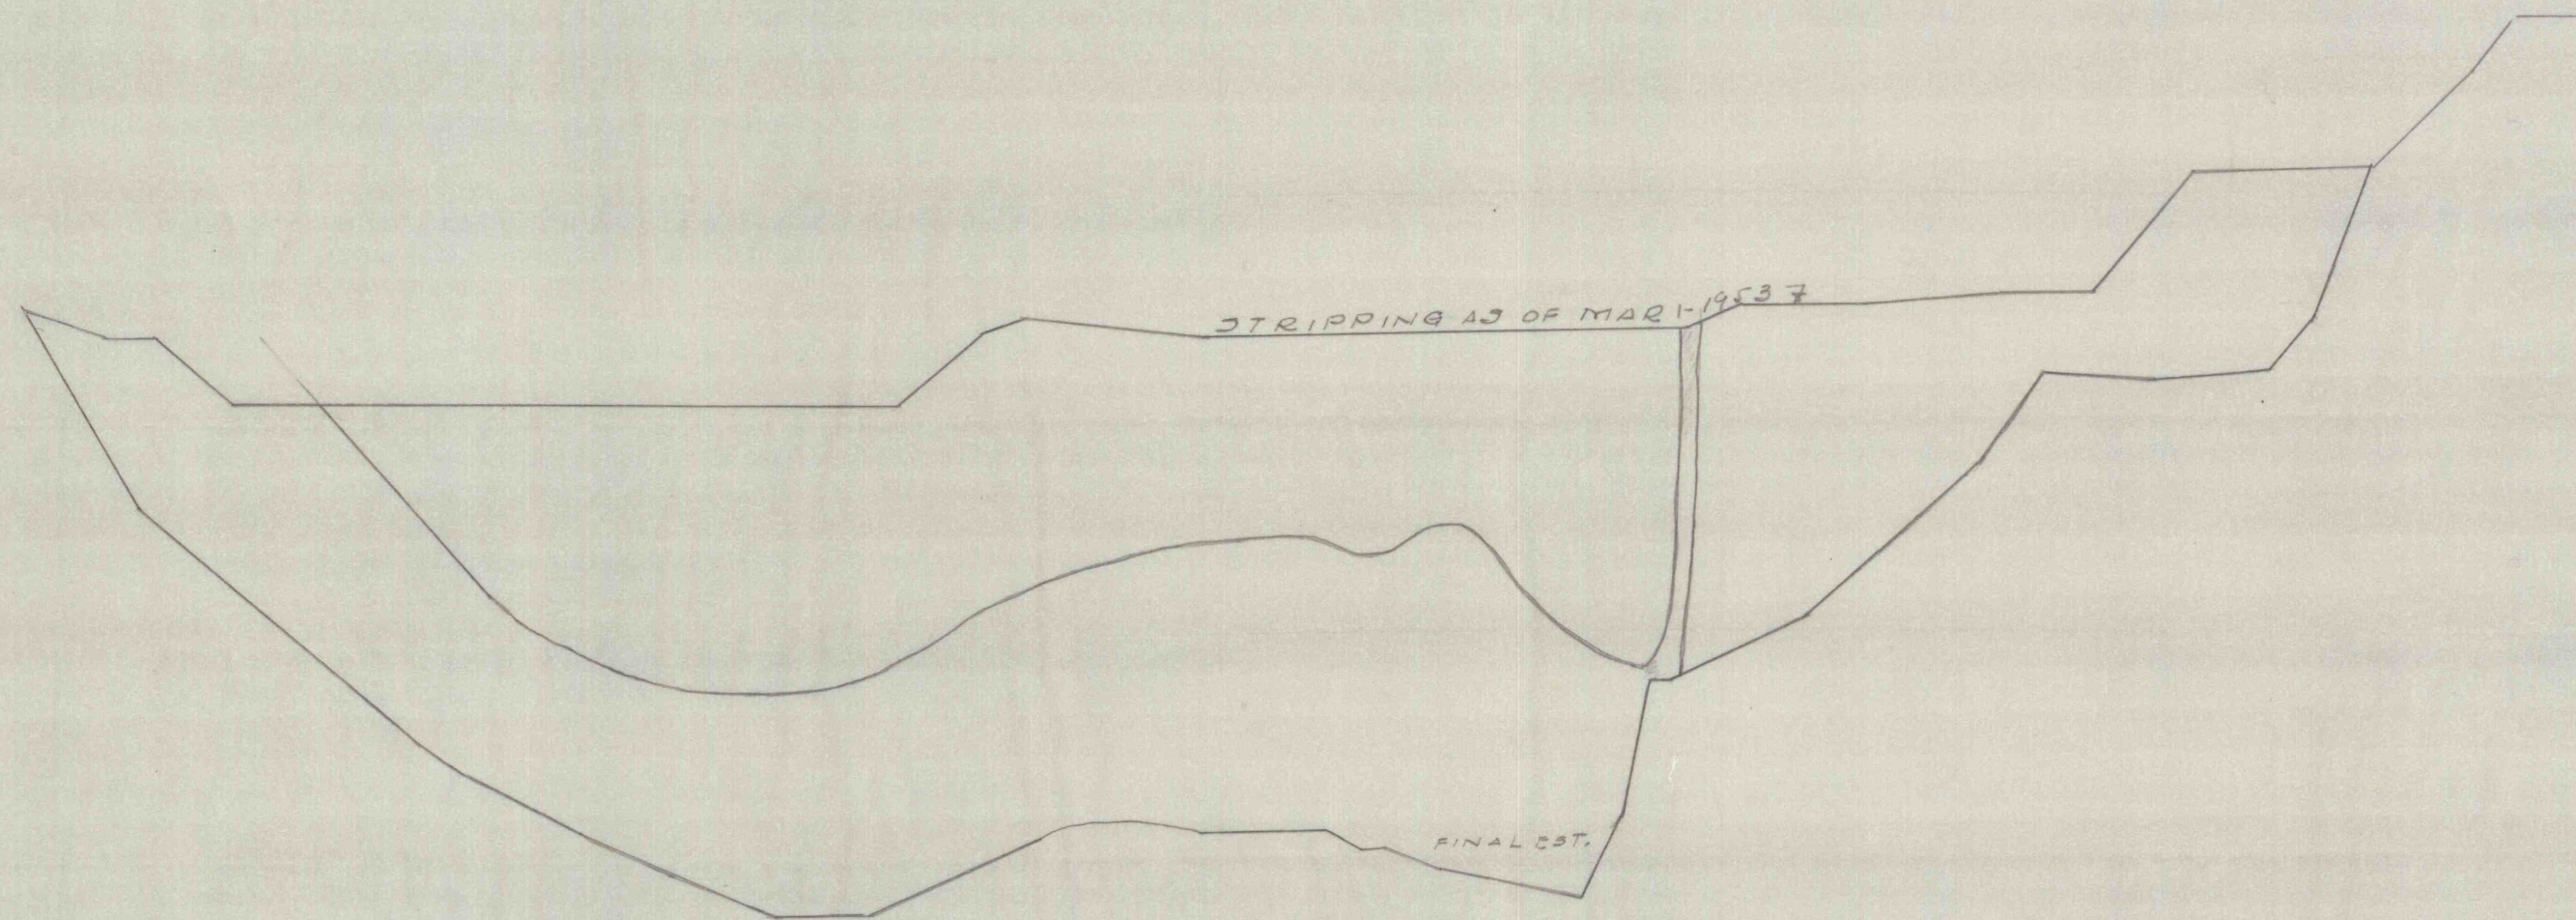

1100

MOREA STRIPPING
SECTION 4+00 EAST
1"=50'

2111-MC-JAT