


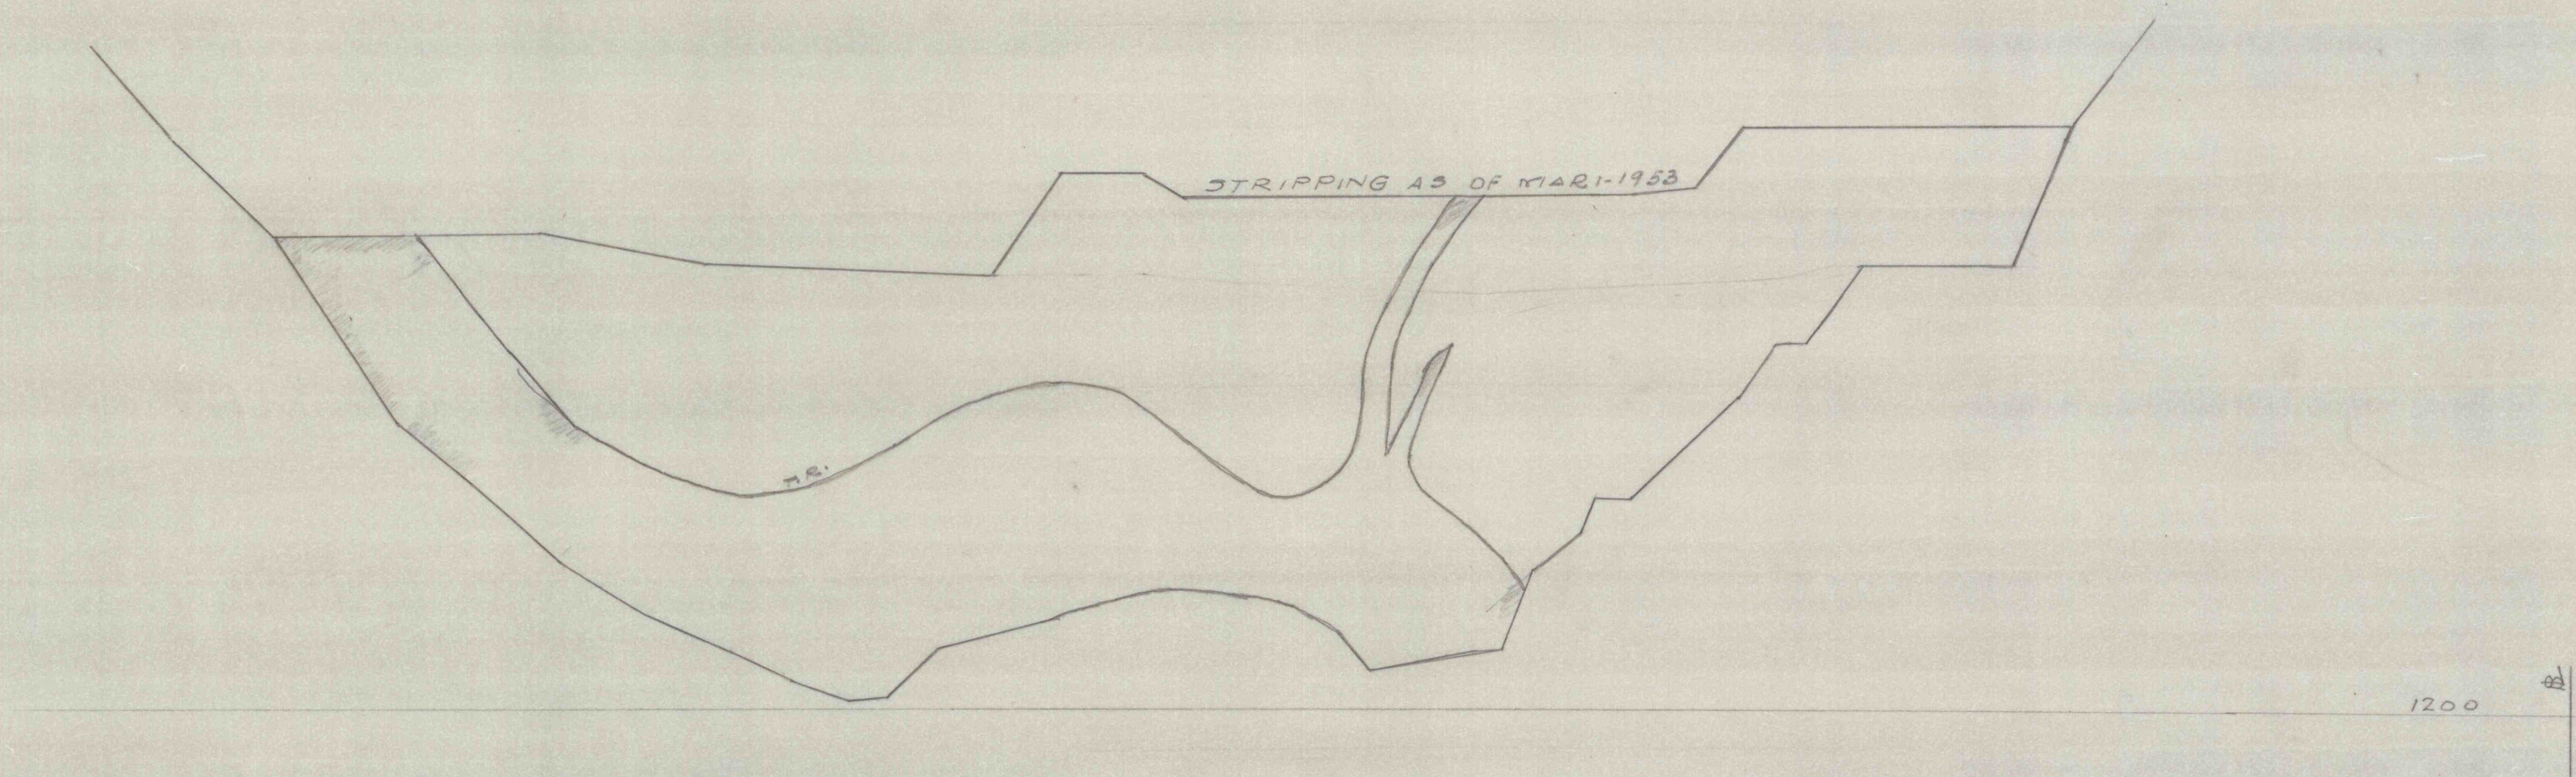

MOREA STRIPPING
SECTION 5+00 E
1" = 50'