


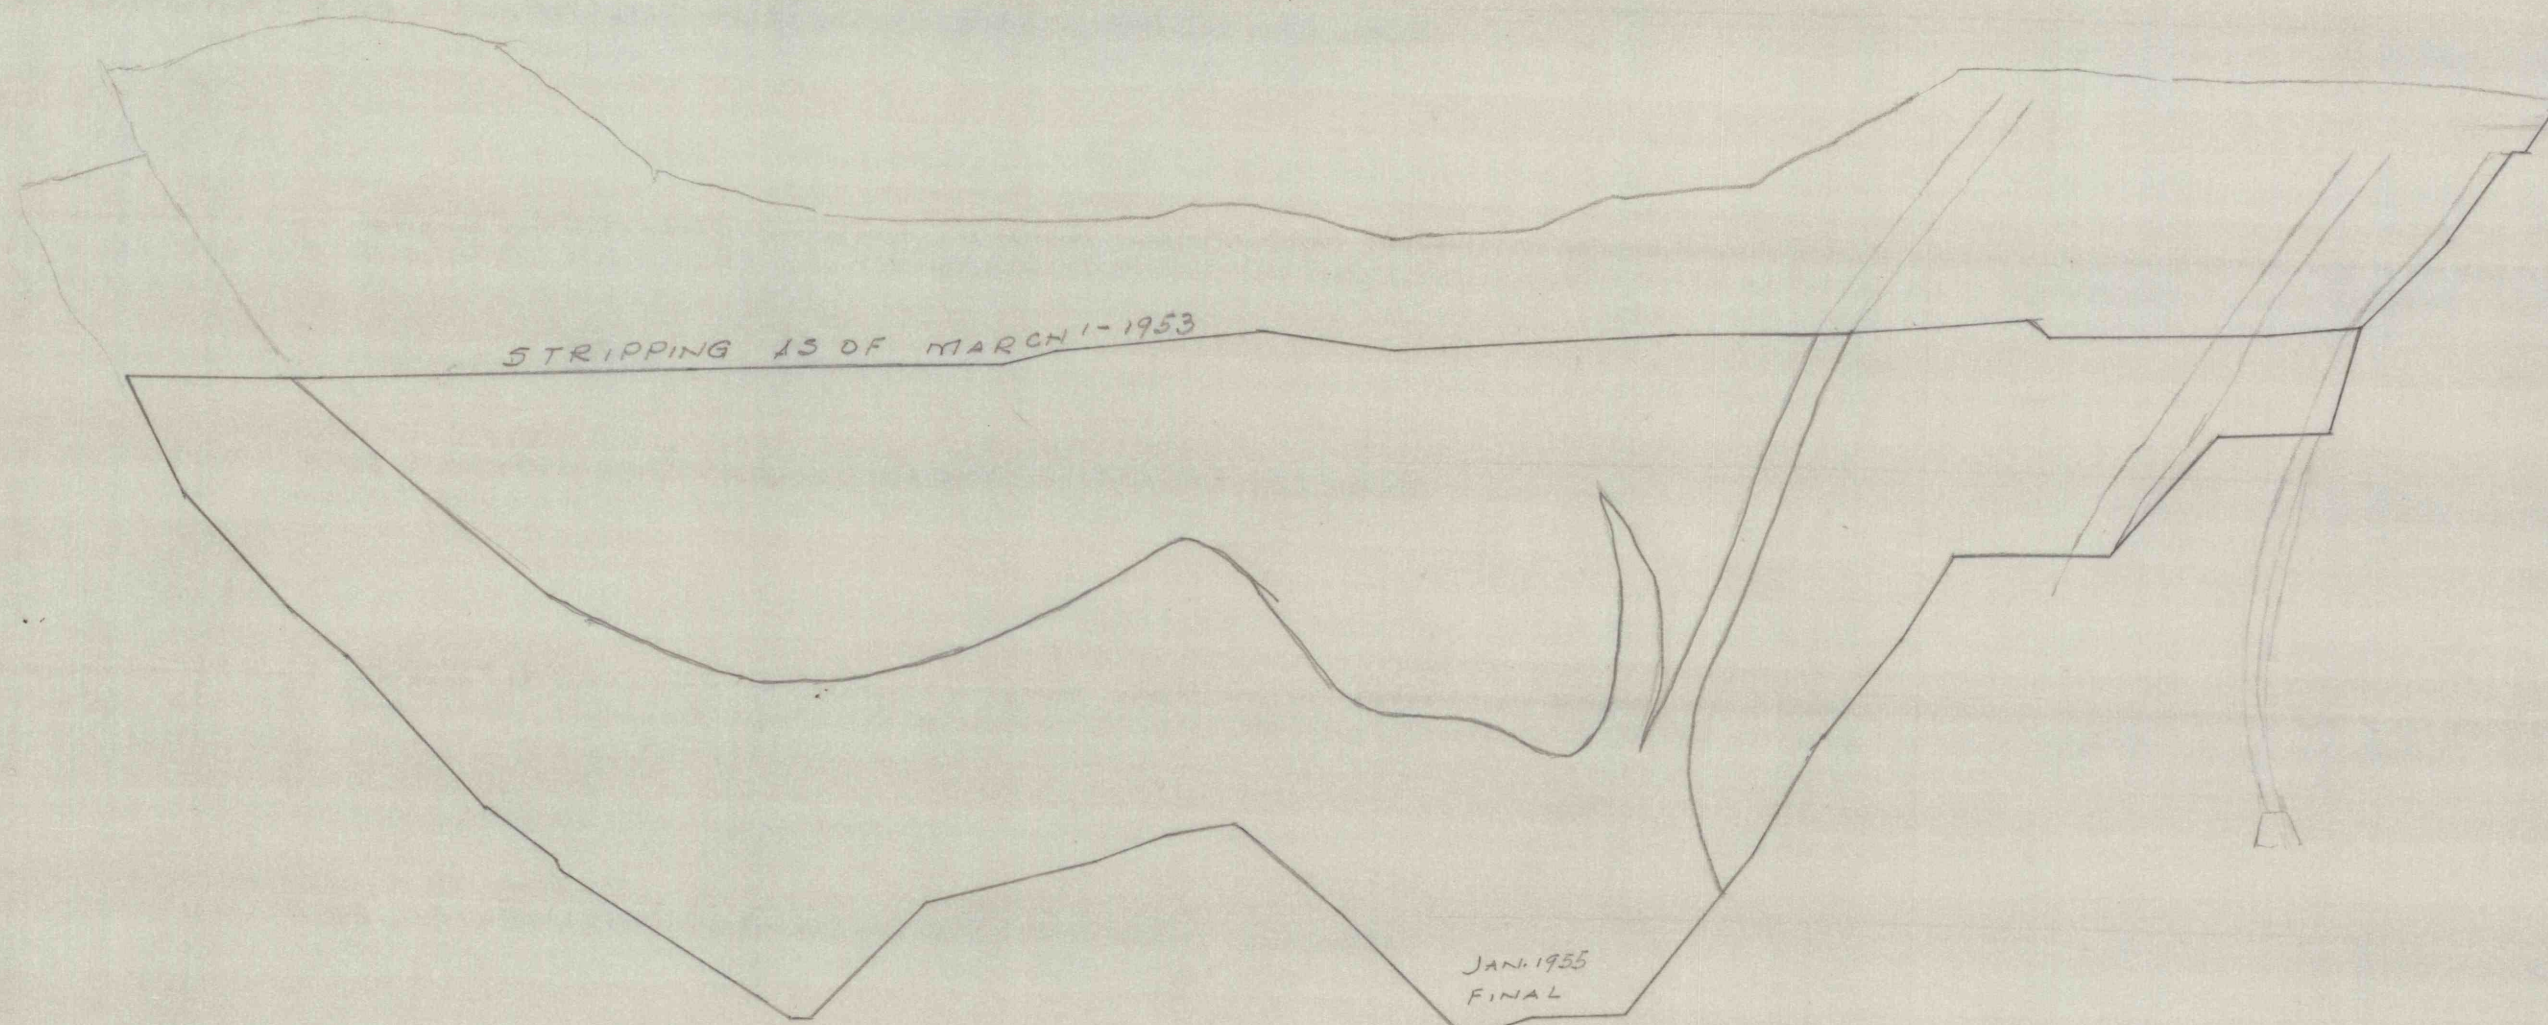

1100

MOREA STRIPPING
SECTION 8+00 EAST
1"=50'