


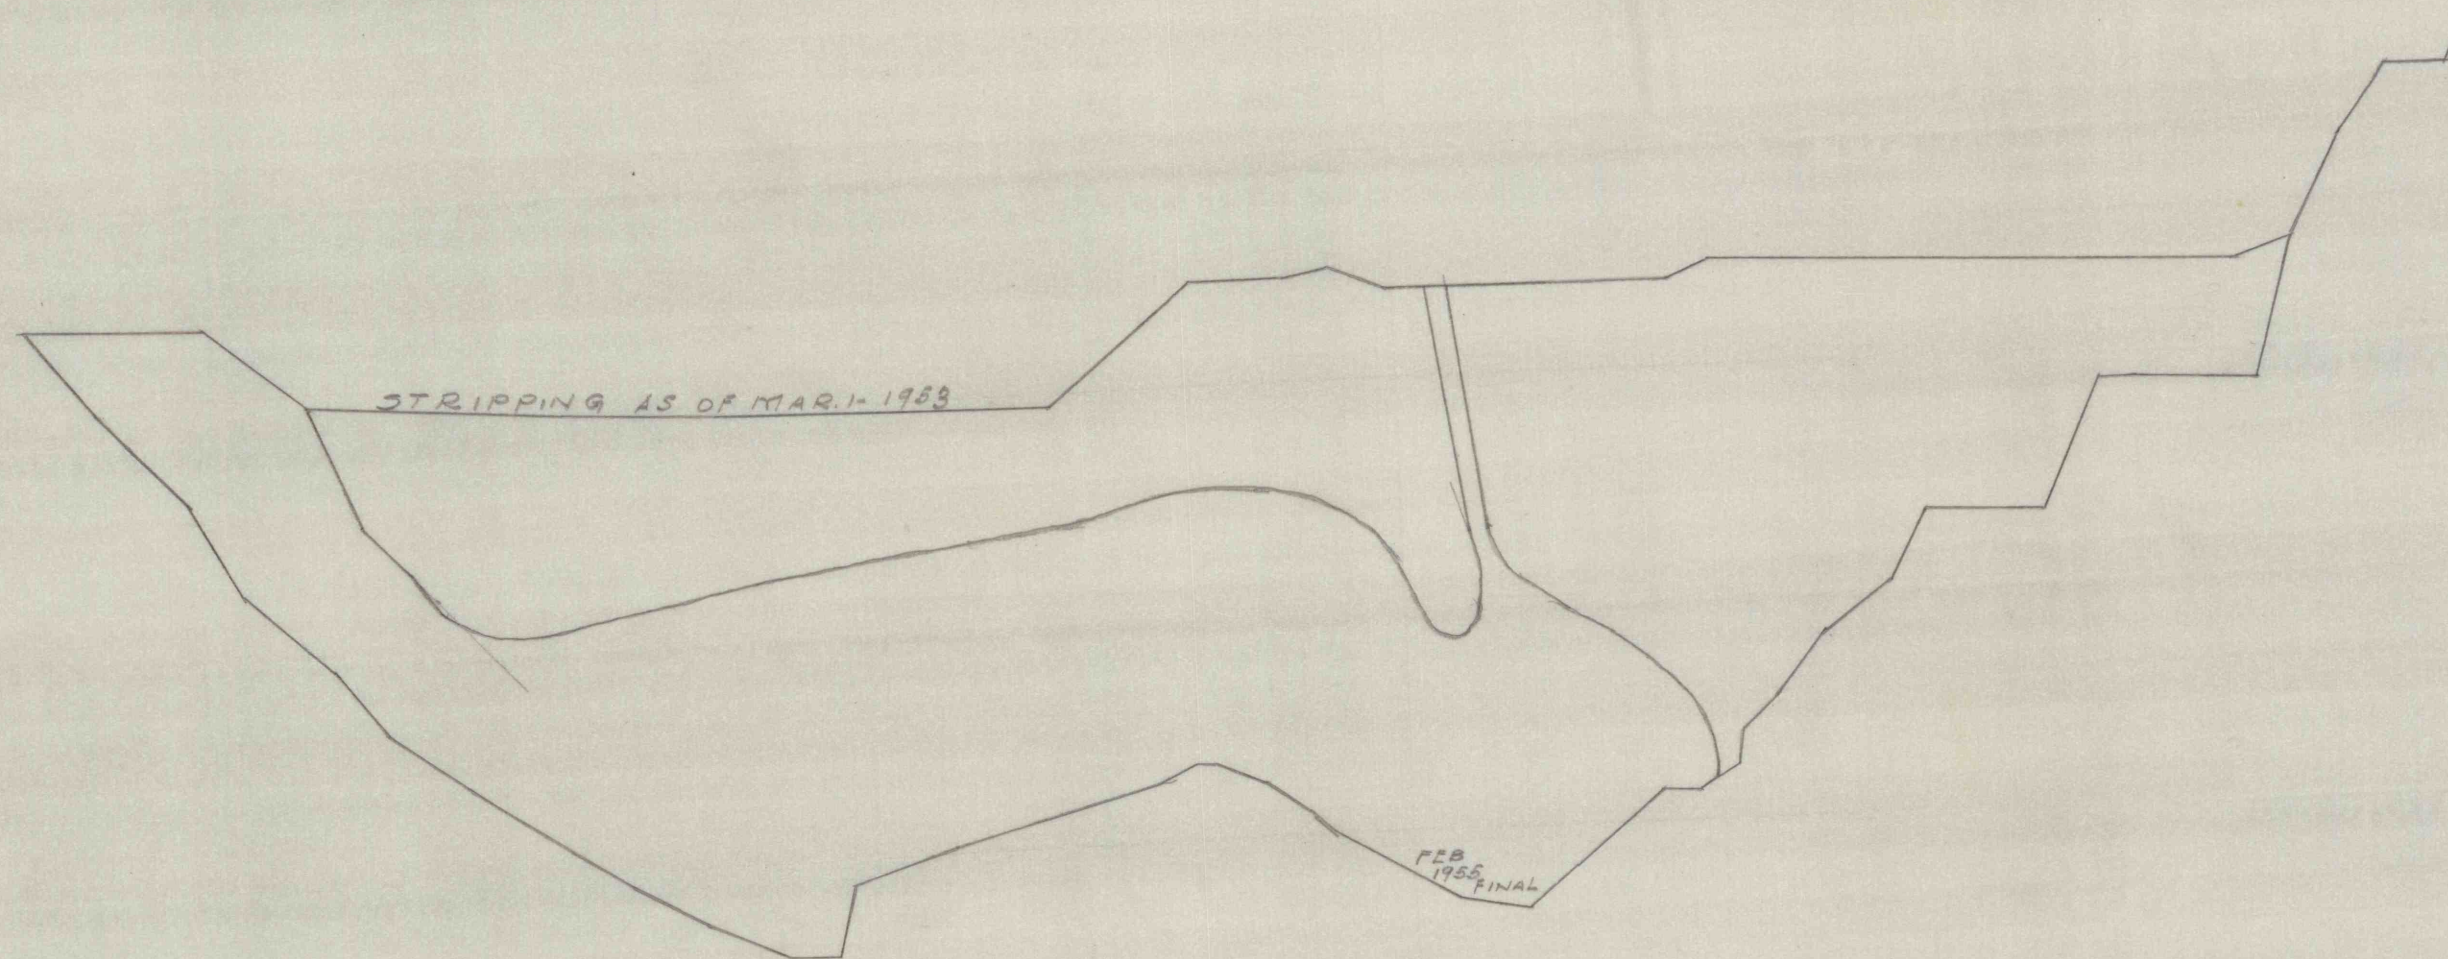

1100

MOREA STRIPPING
SECTION 6+00 E
1" = 50'