


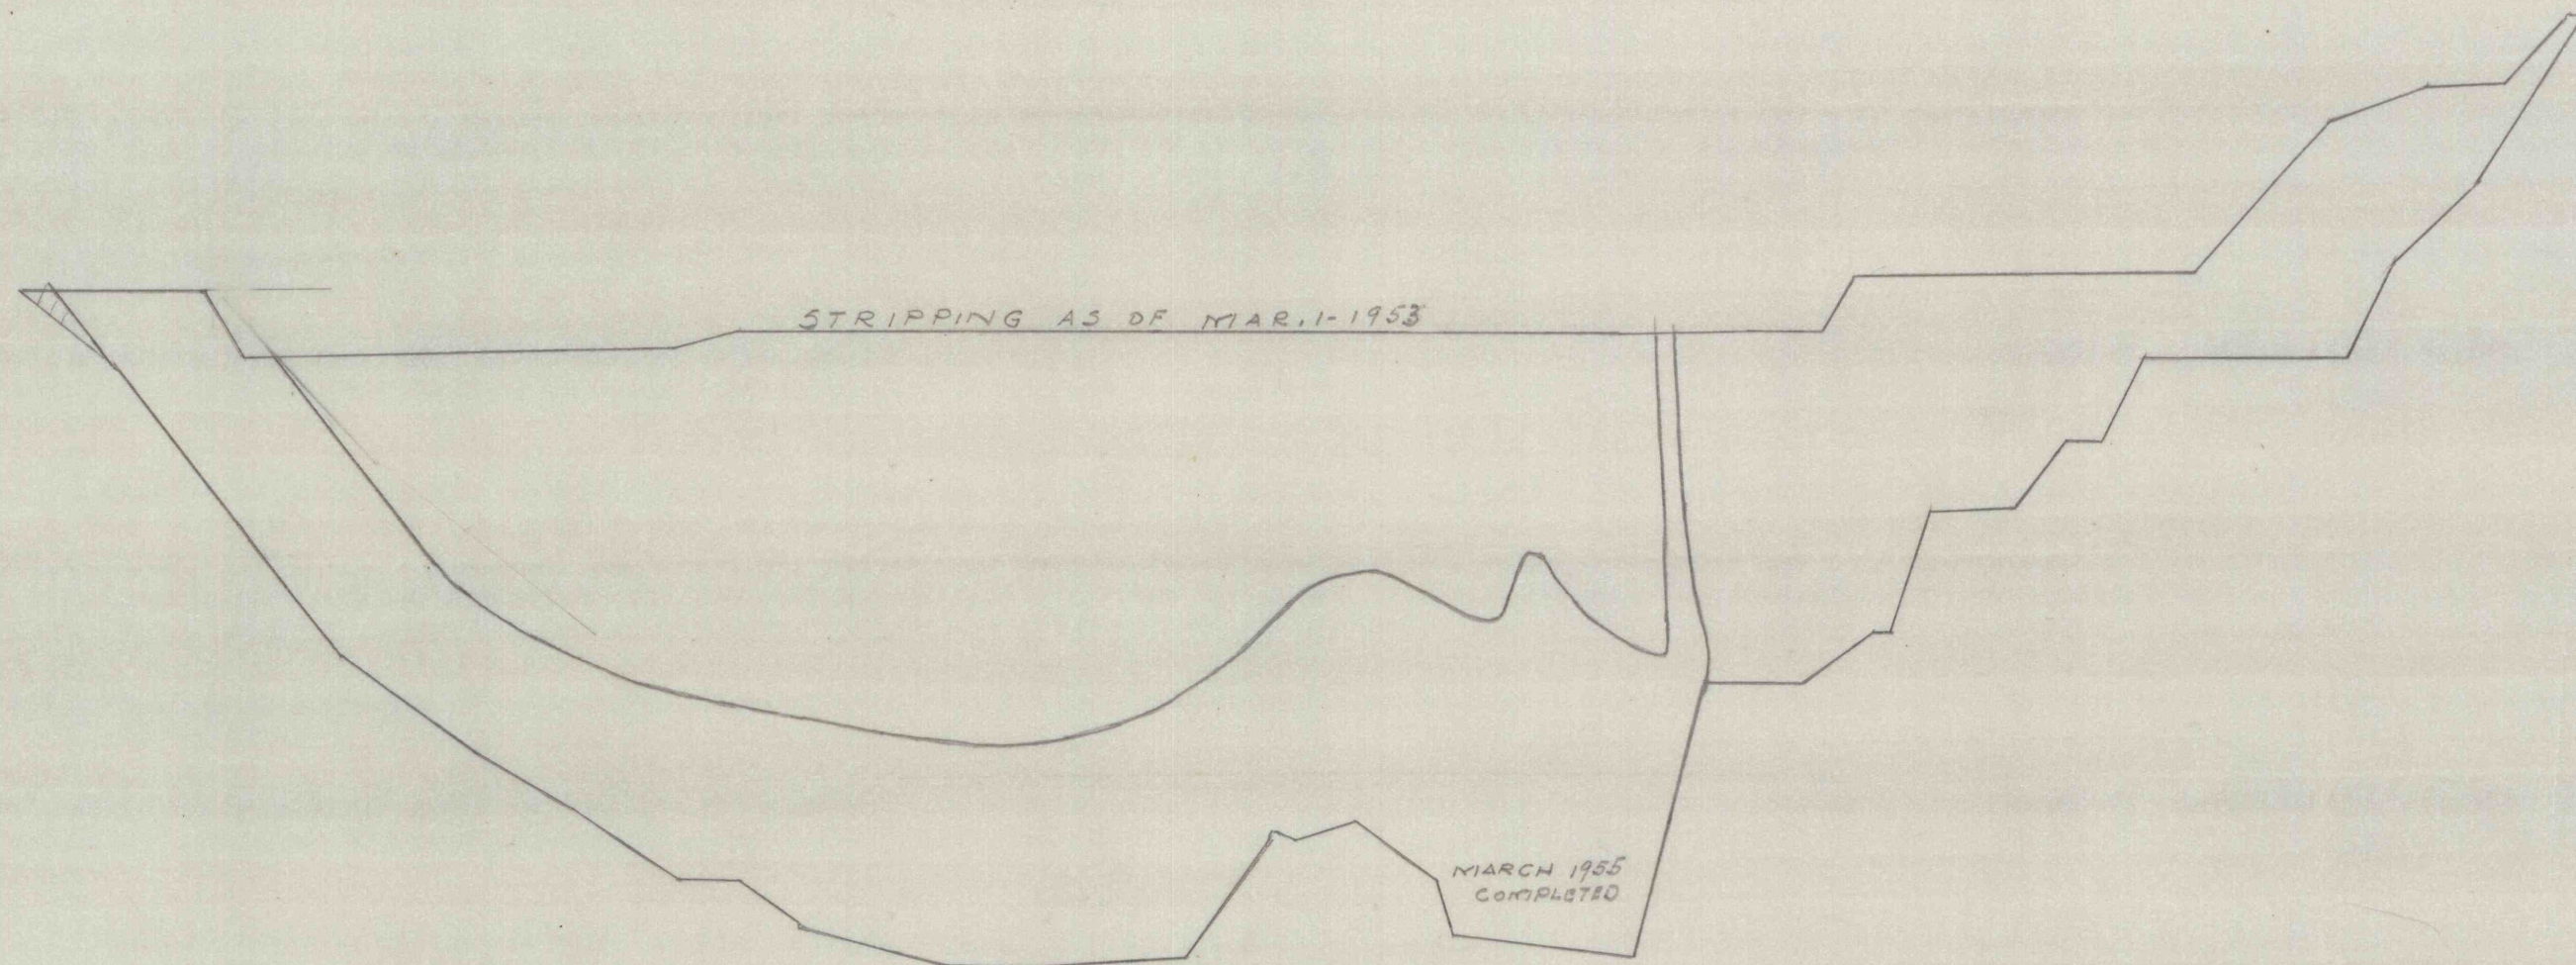

8171-ME-JAT

1100

MOREA STRIPPING
SECTION 3+00 EAST
1" = 50'