


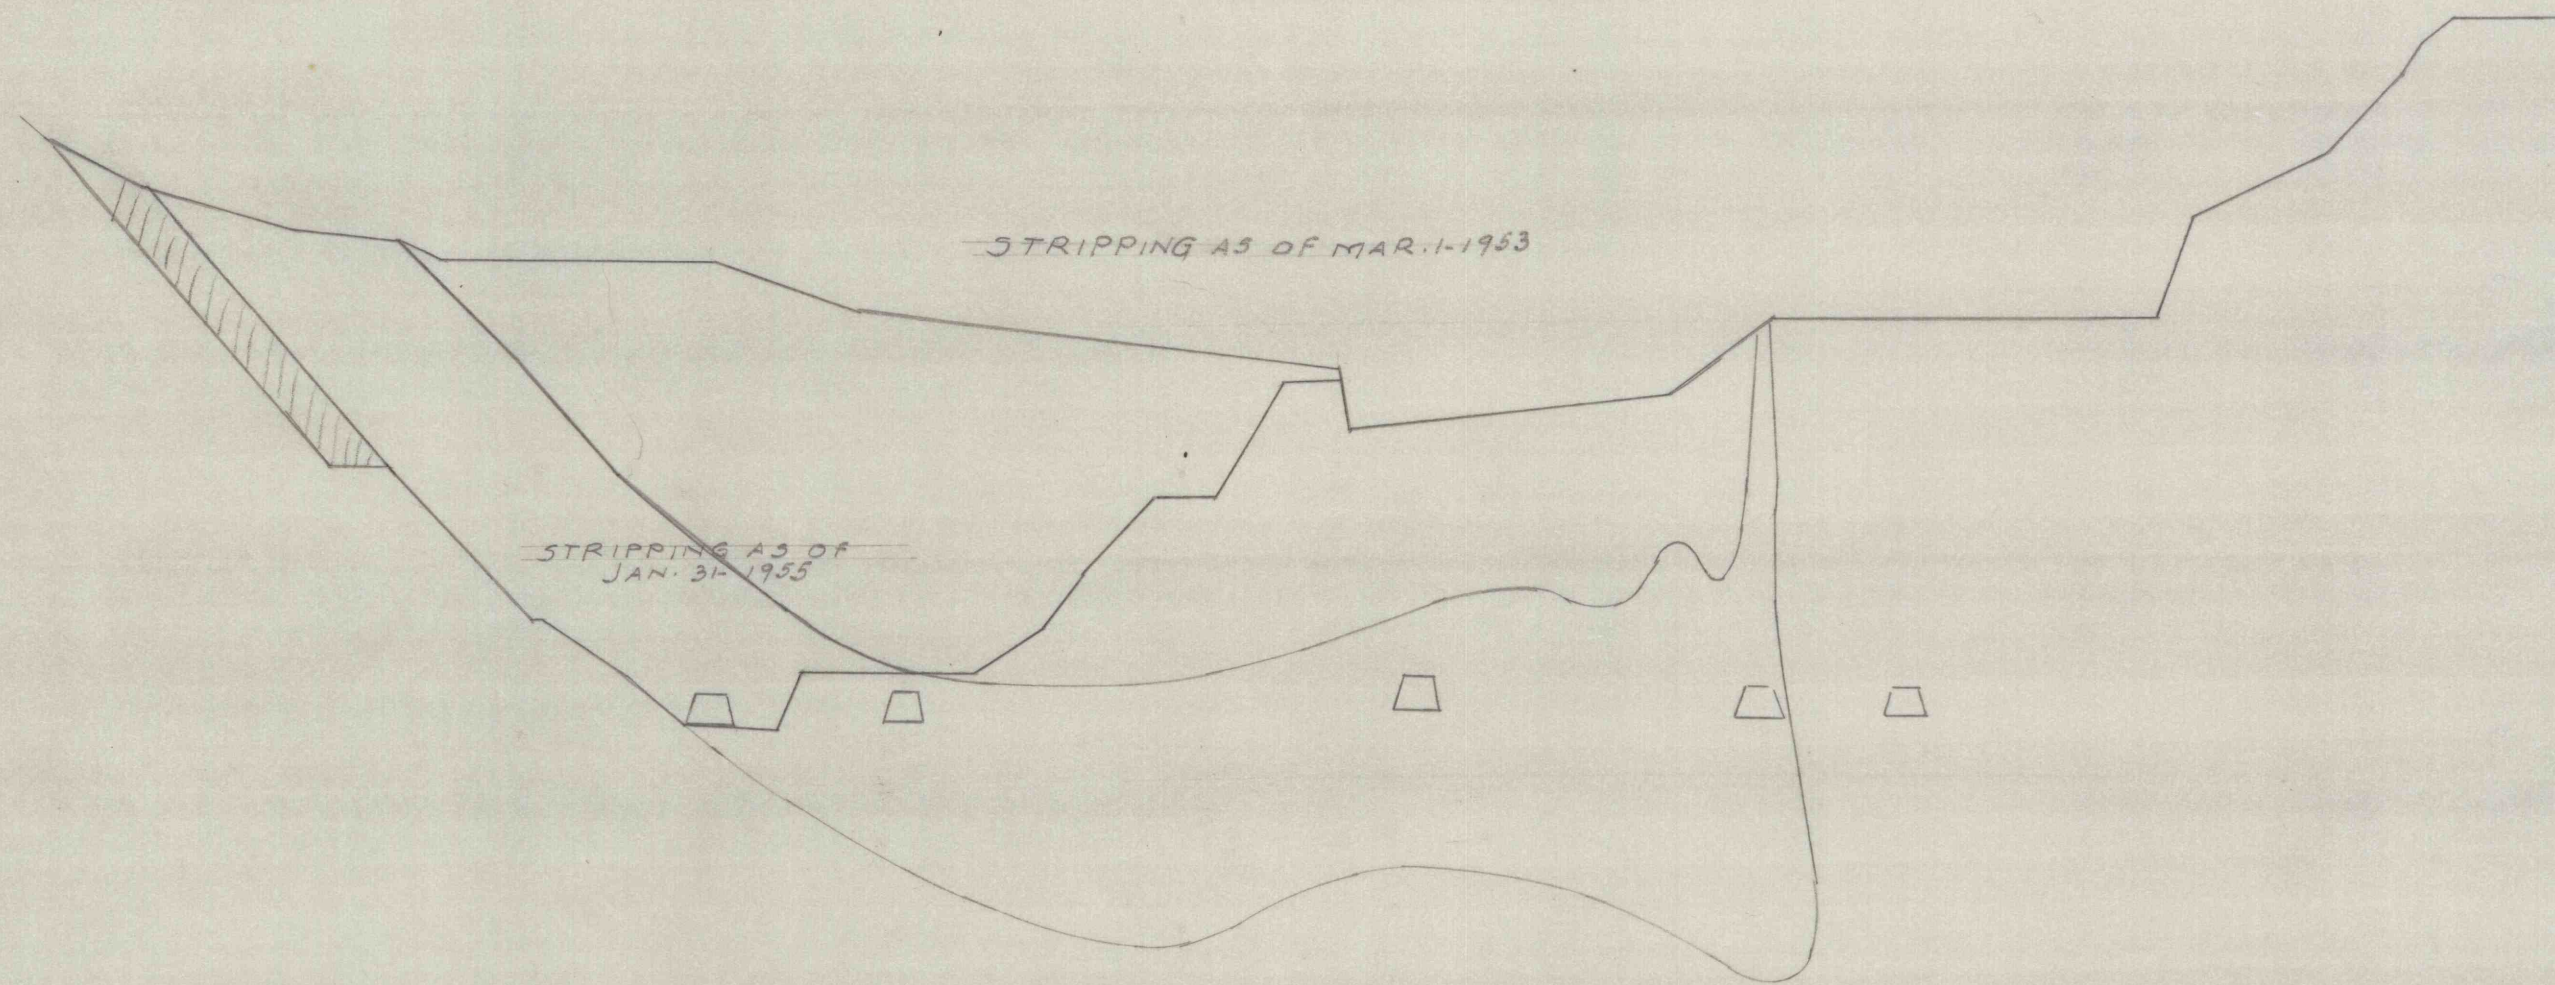

PIT-ME-JAT

MOREA STRIPPING
SECTION 1+00E
1/4 50' FEB. 11-1955

1000

500/