


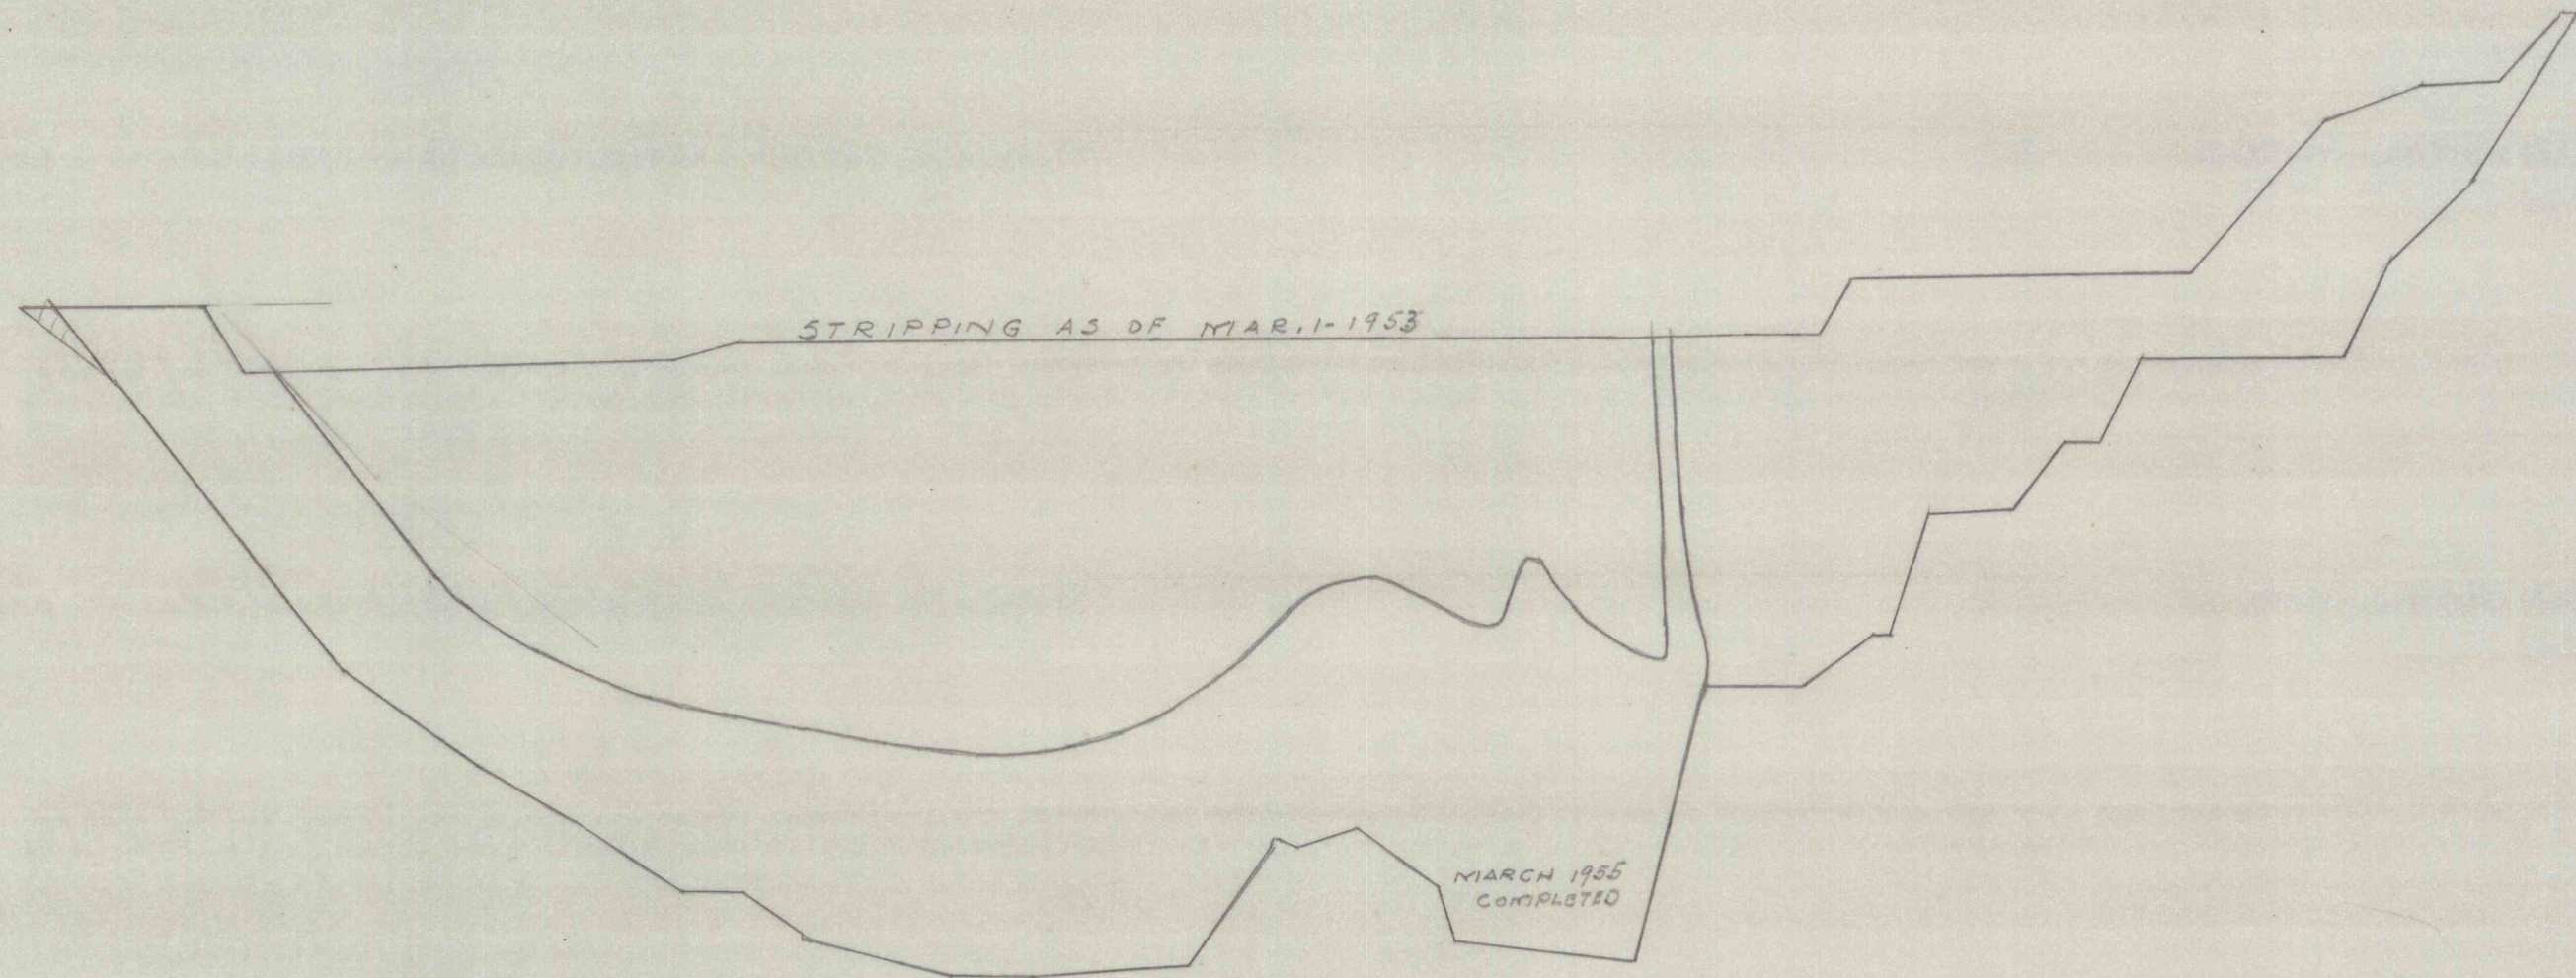

8171-ME-JAI

1100

MOREA STRIPPING
SECTION 3+00 EAST
1/2 50'