


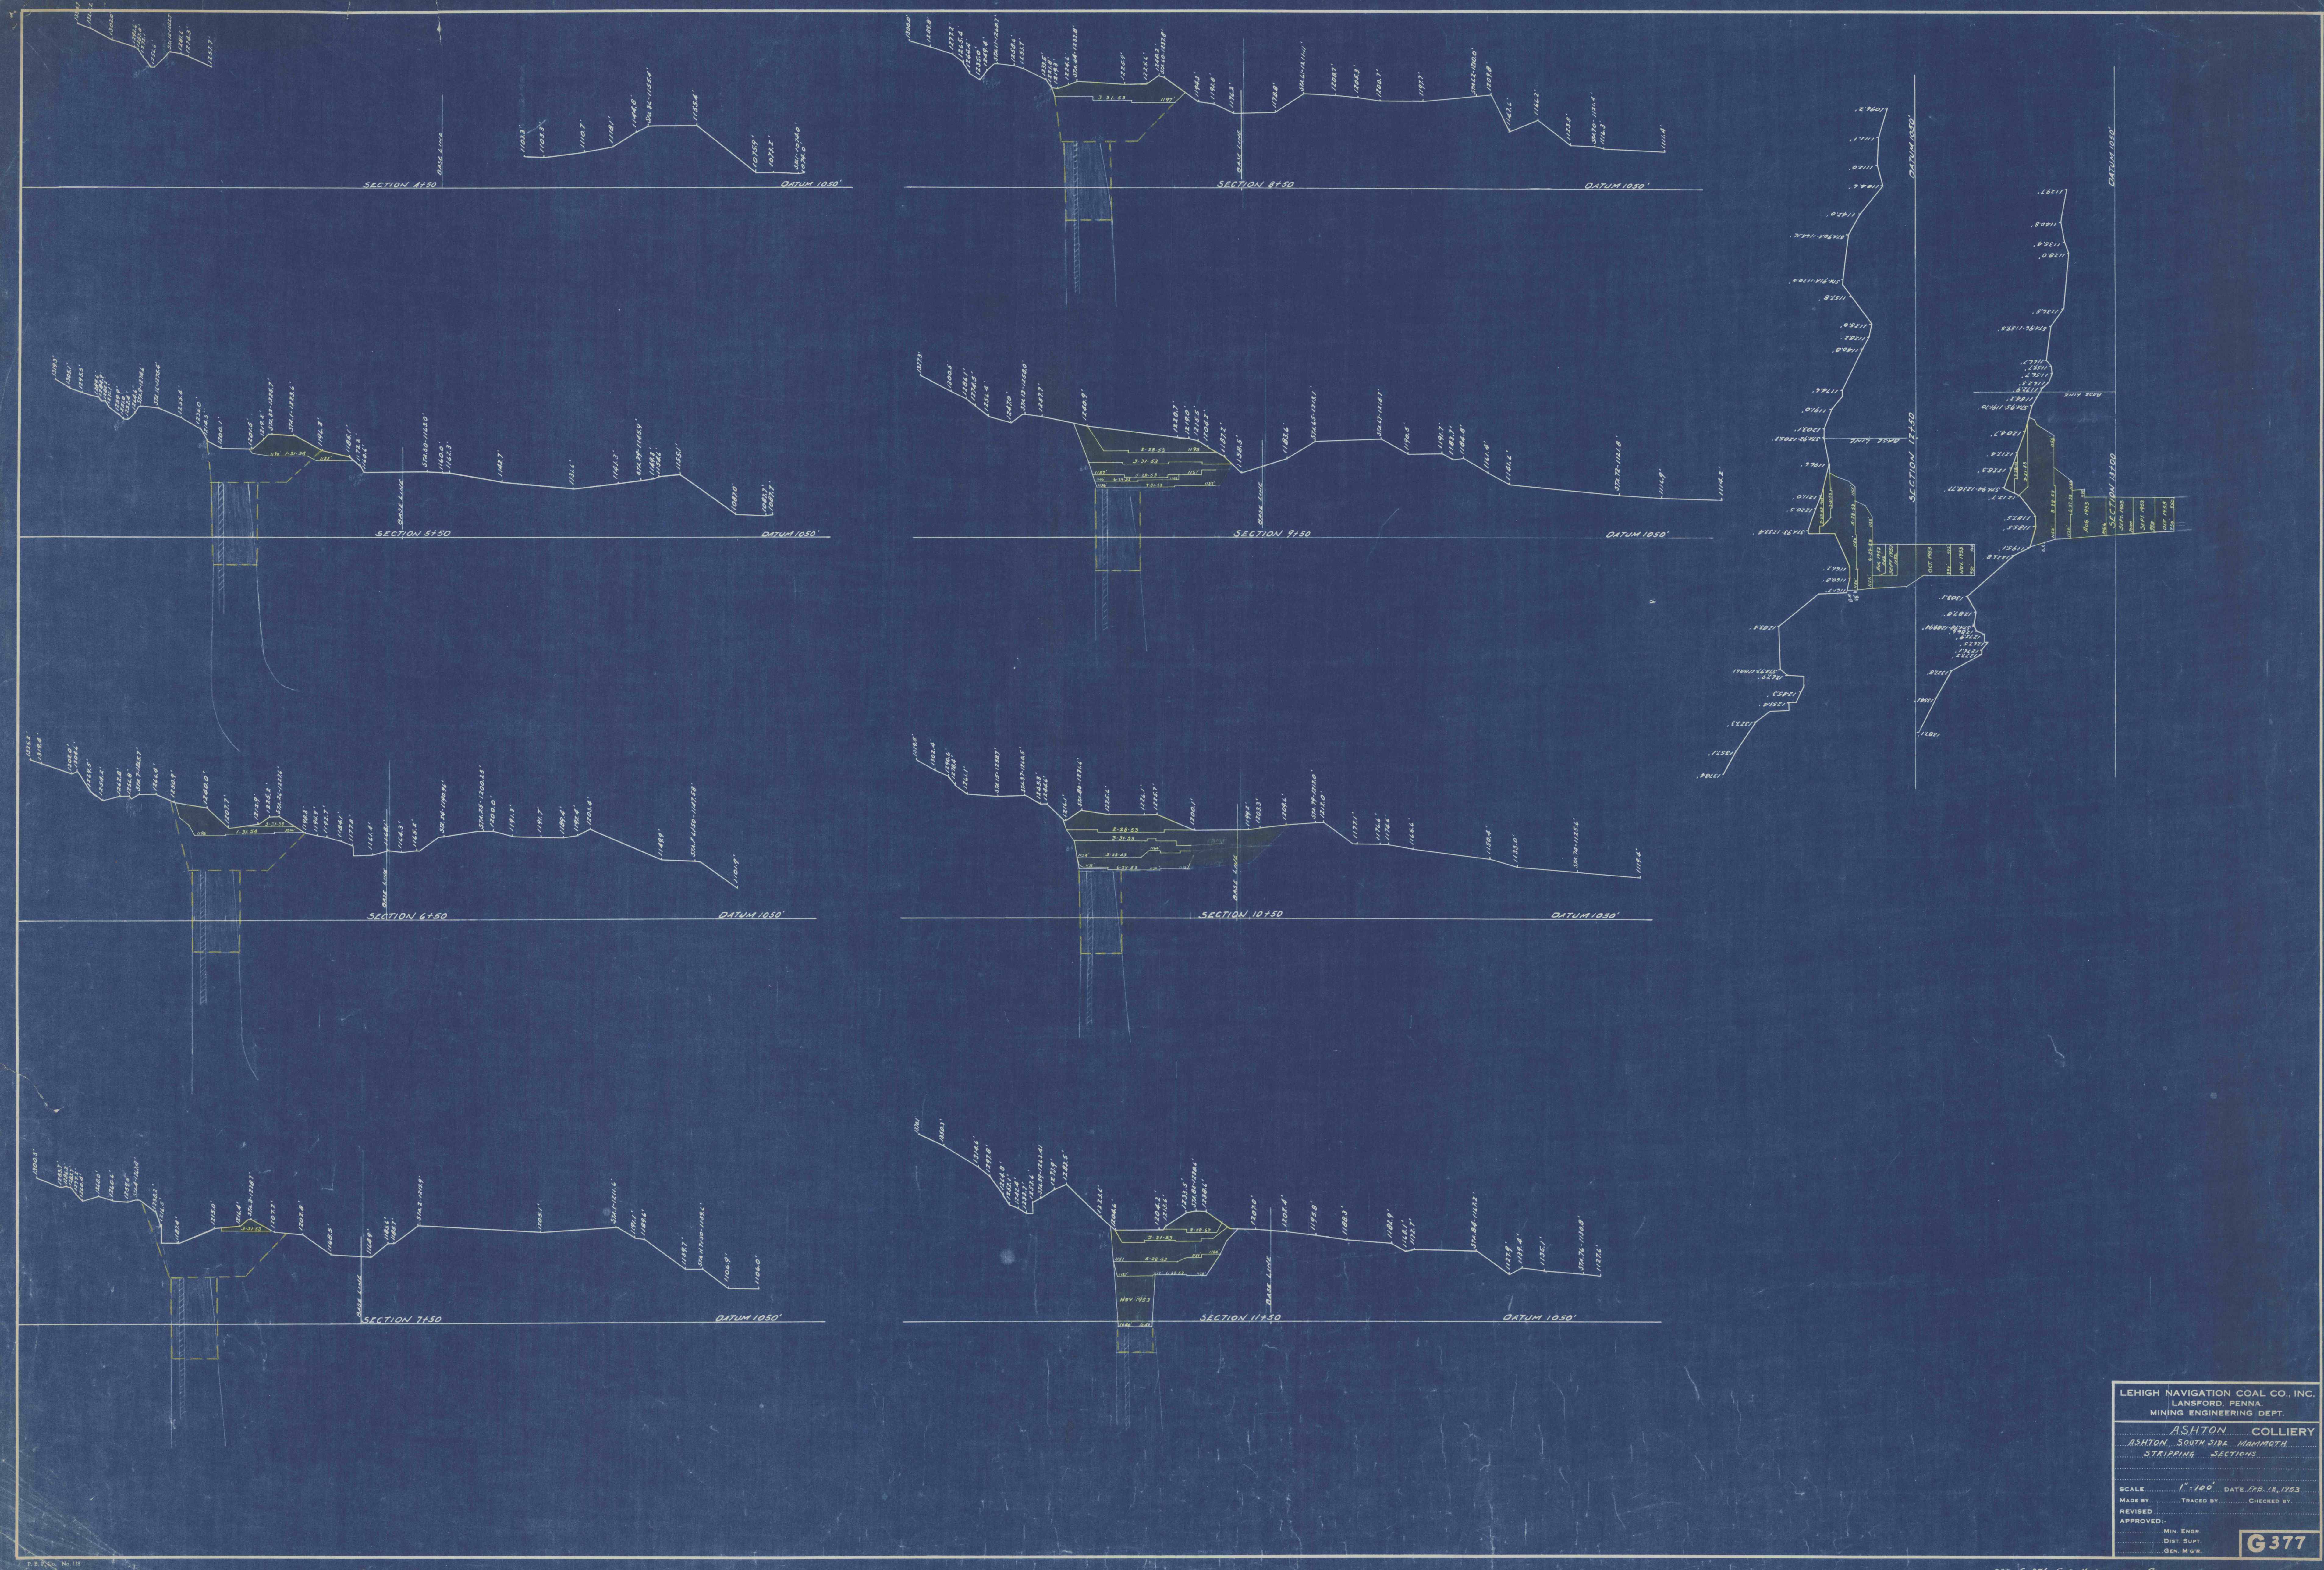

LEHIGH NAVIGATION COAL CO., INC.
LANSFORD, PENNA.
MINING ENGINEERING DEPT.

ASHTON COLLIERY
SOUTH SIDE MAMMOTH
STRIPPING SECTIONS

MADE BY _____ TRACED BY _____
REVISED _____
APPROVED: _____
MIN. ENGR. _____
DIST. SUPT. _____
GEN. MGR. _____

G377