


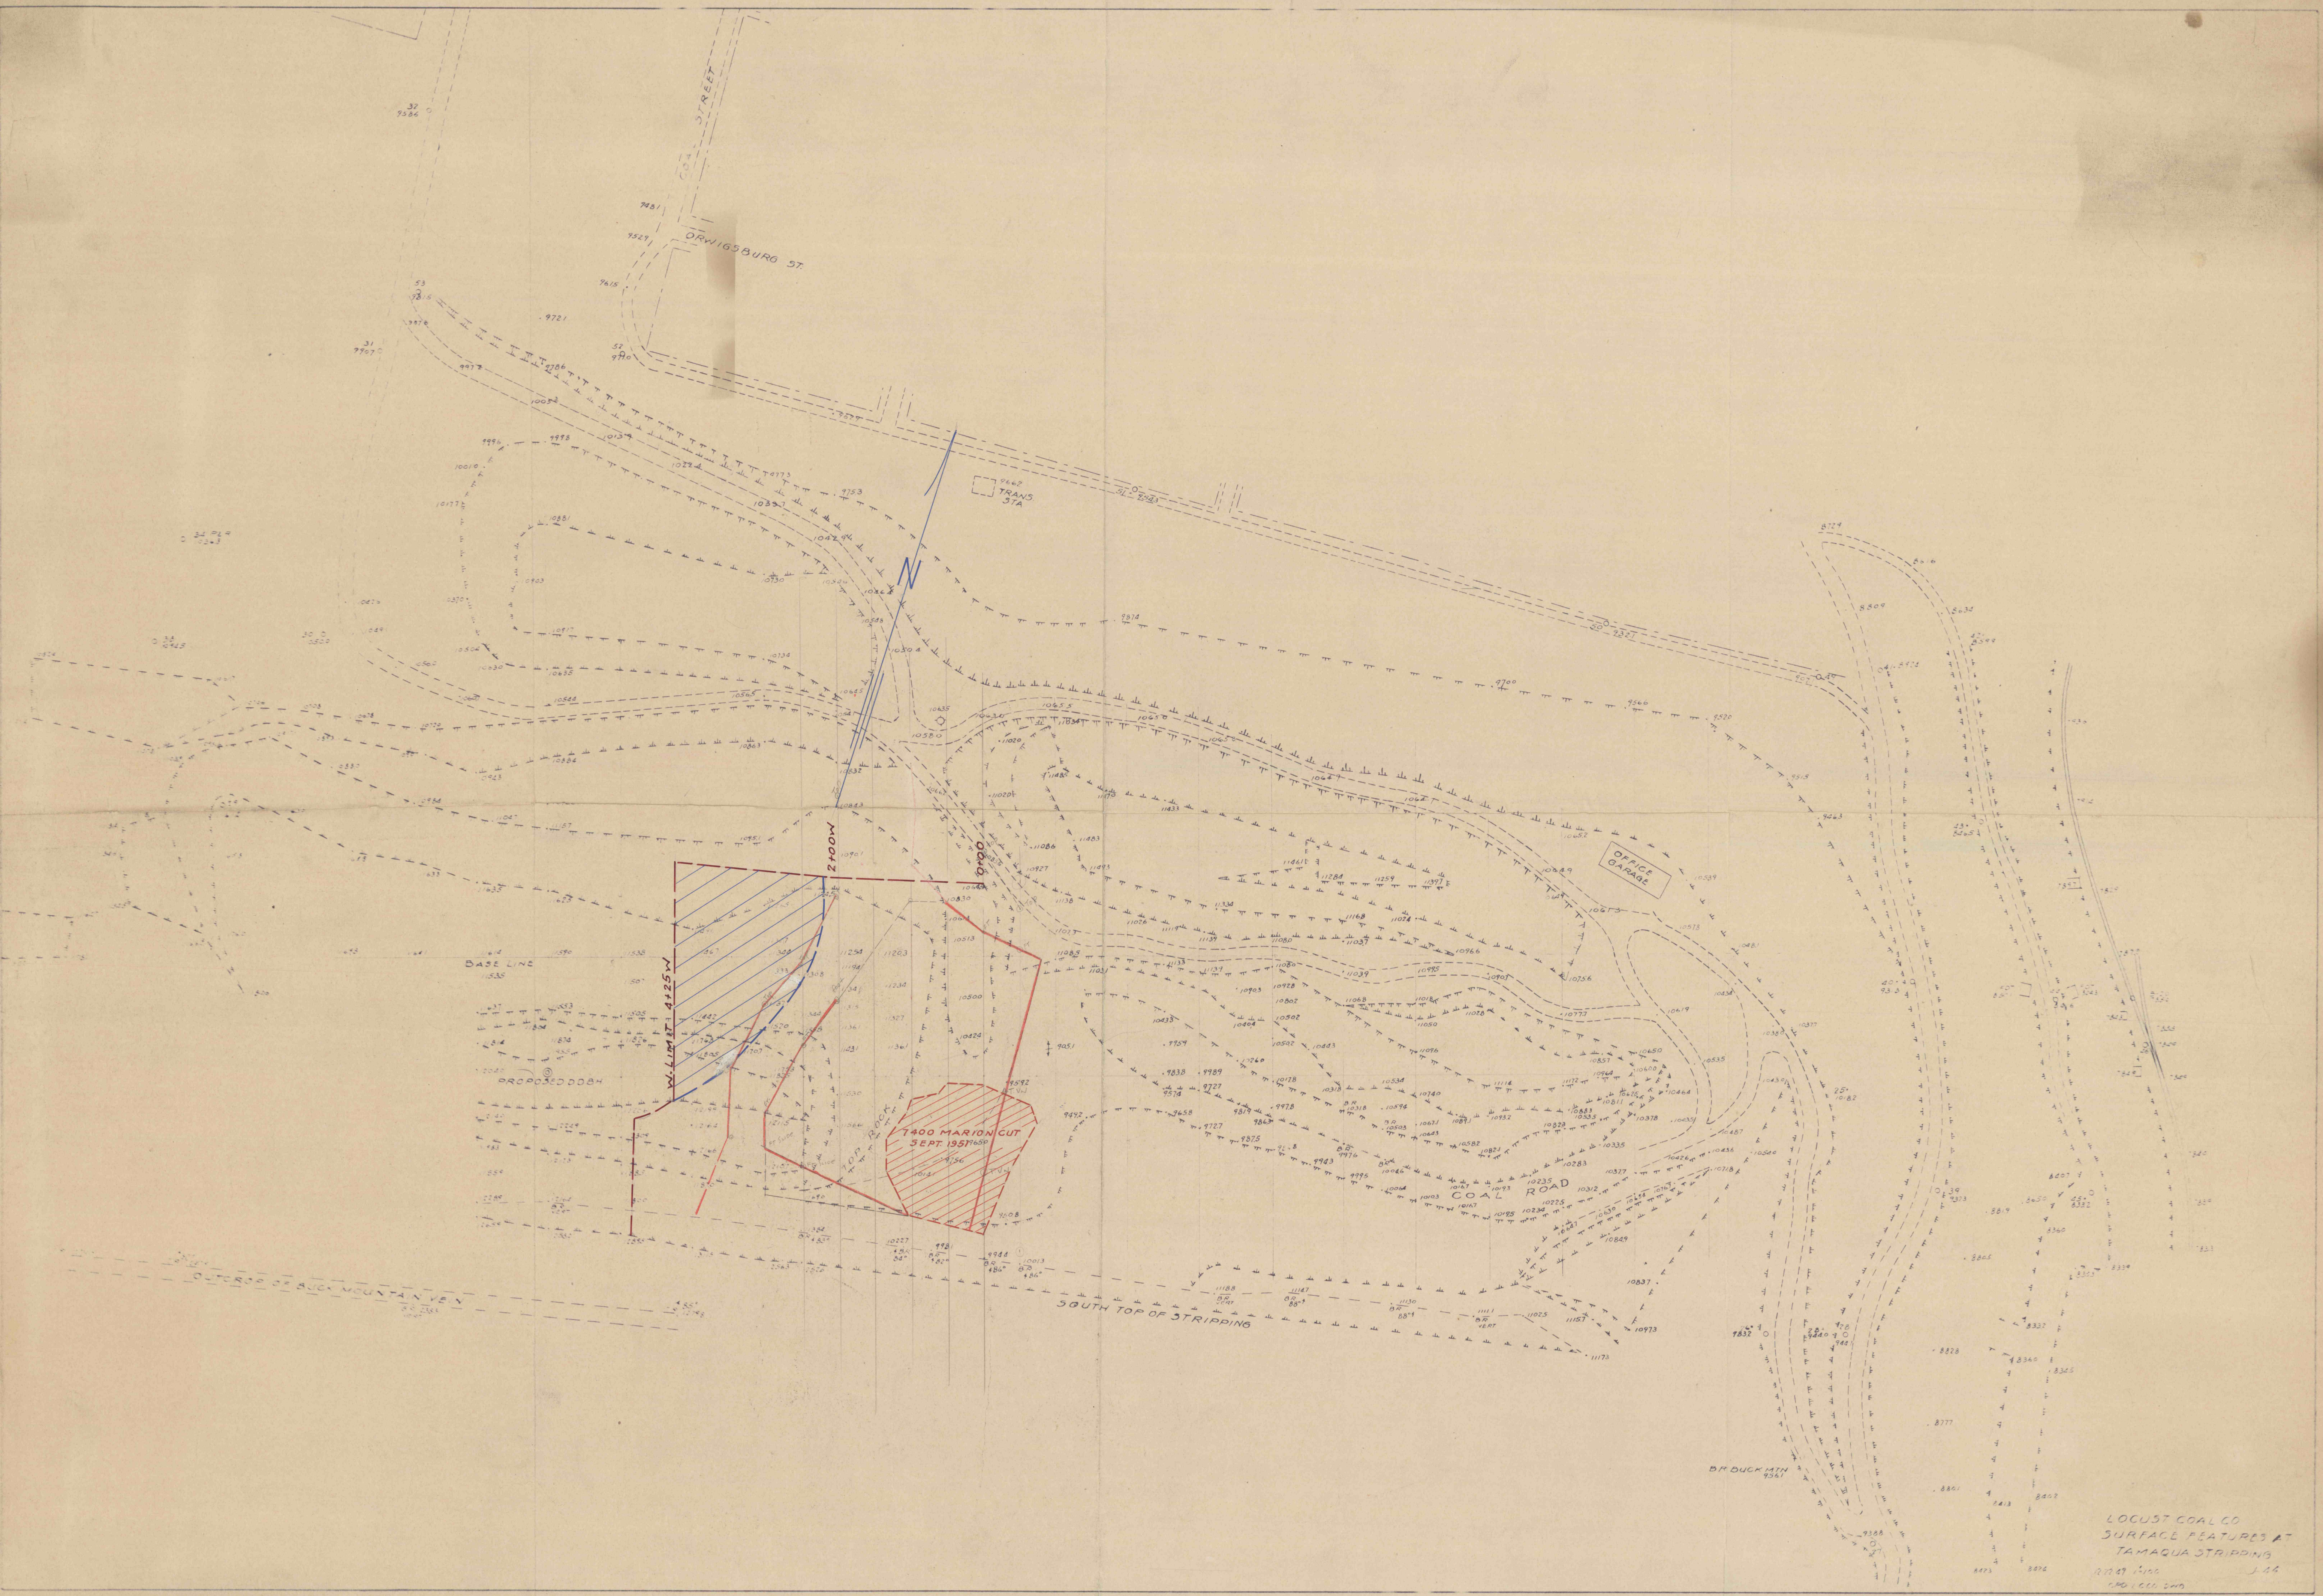

LOCUST COAL CO.
SURFACE FEATURES AT
TAMAQUA STRIPPING
R. 1957 1:100
J. 11